
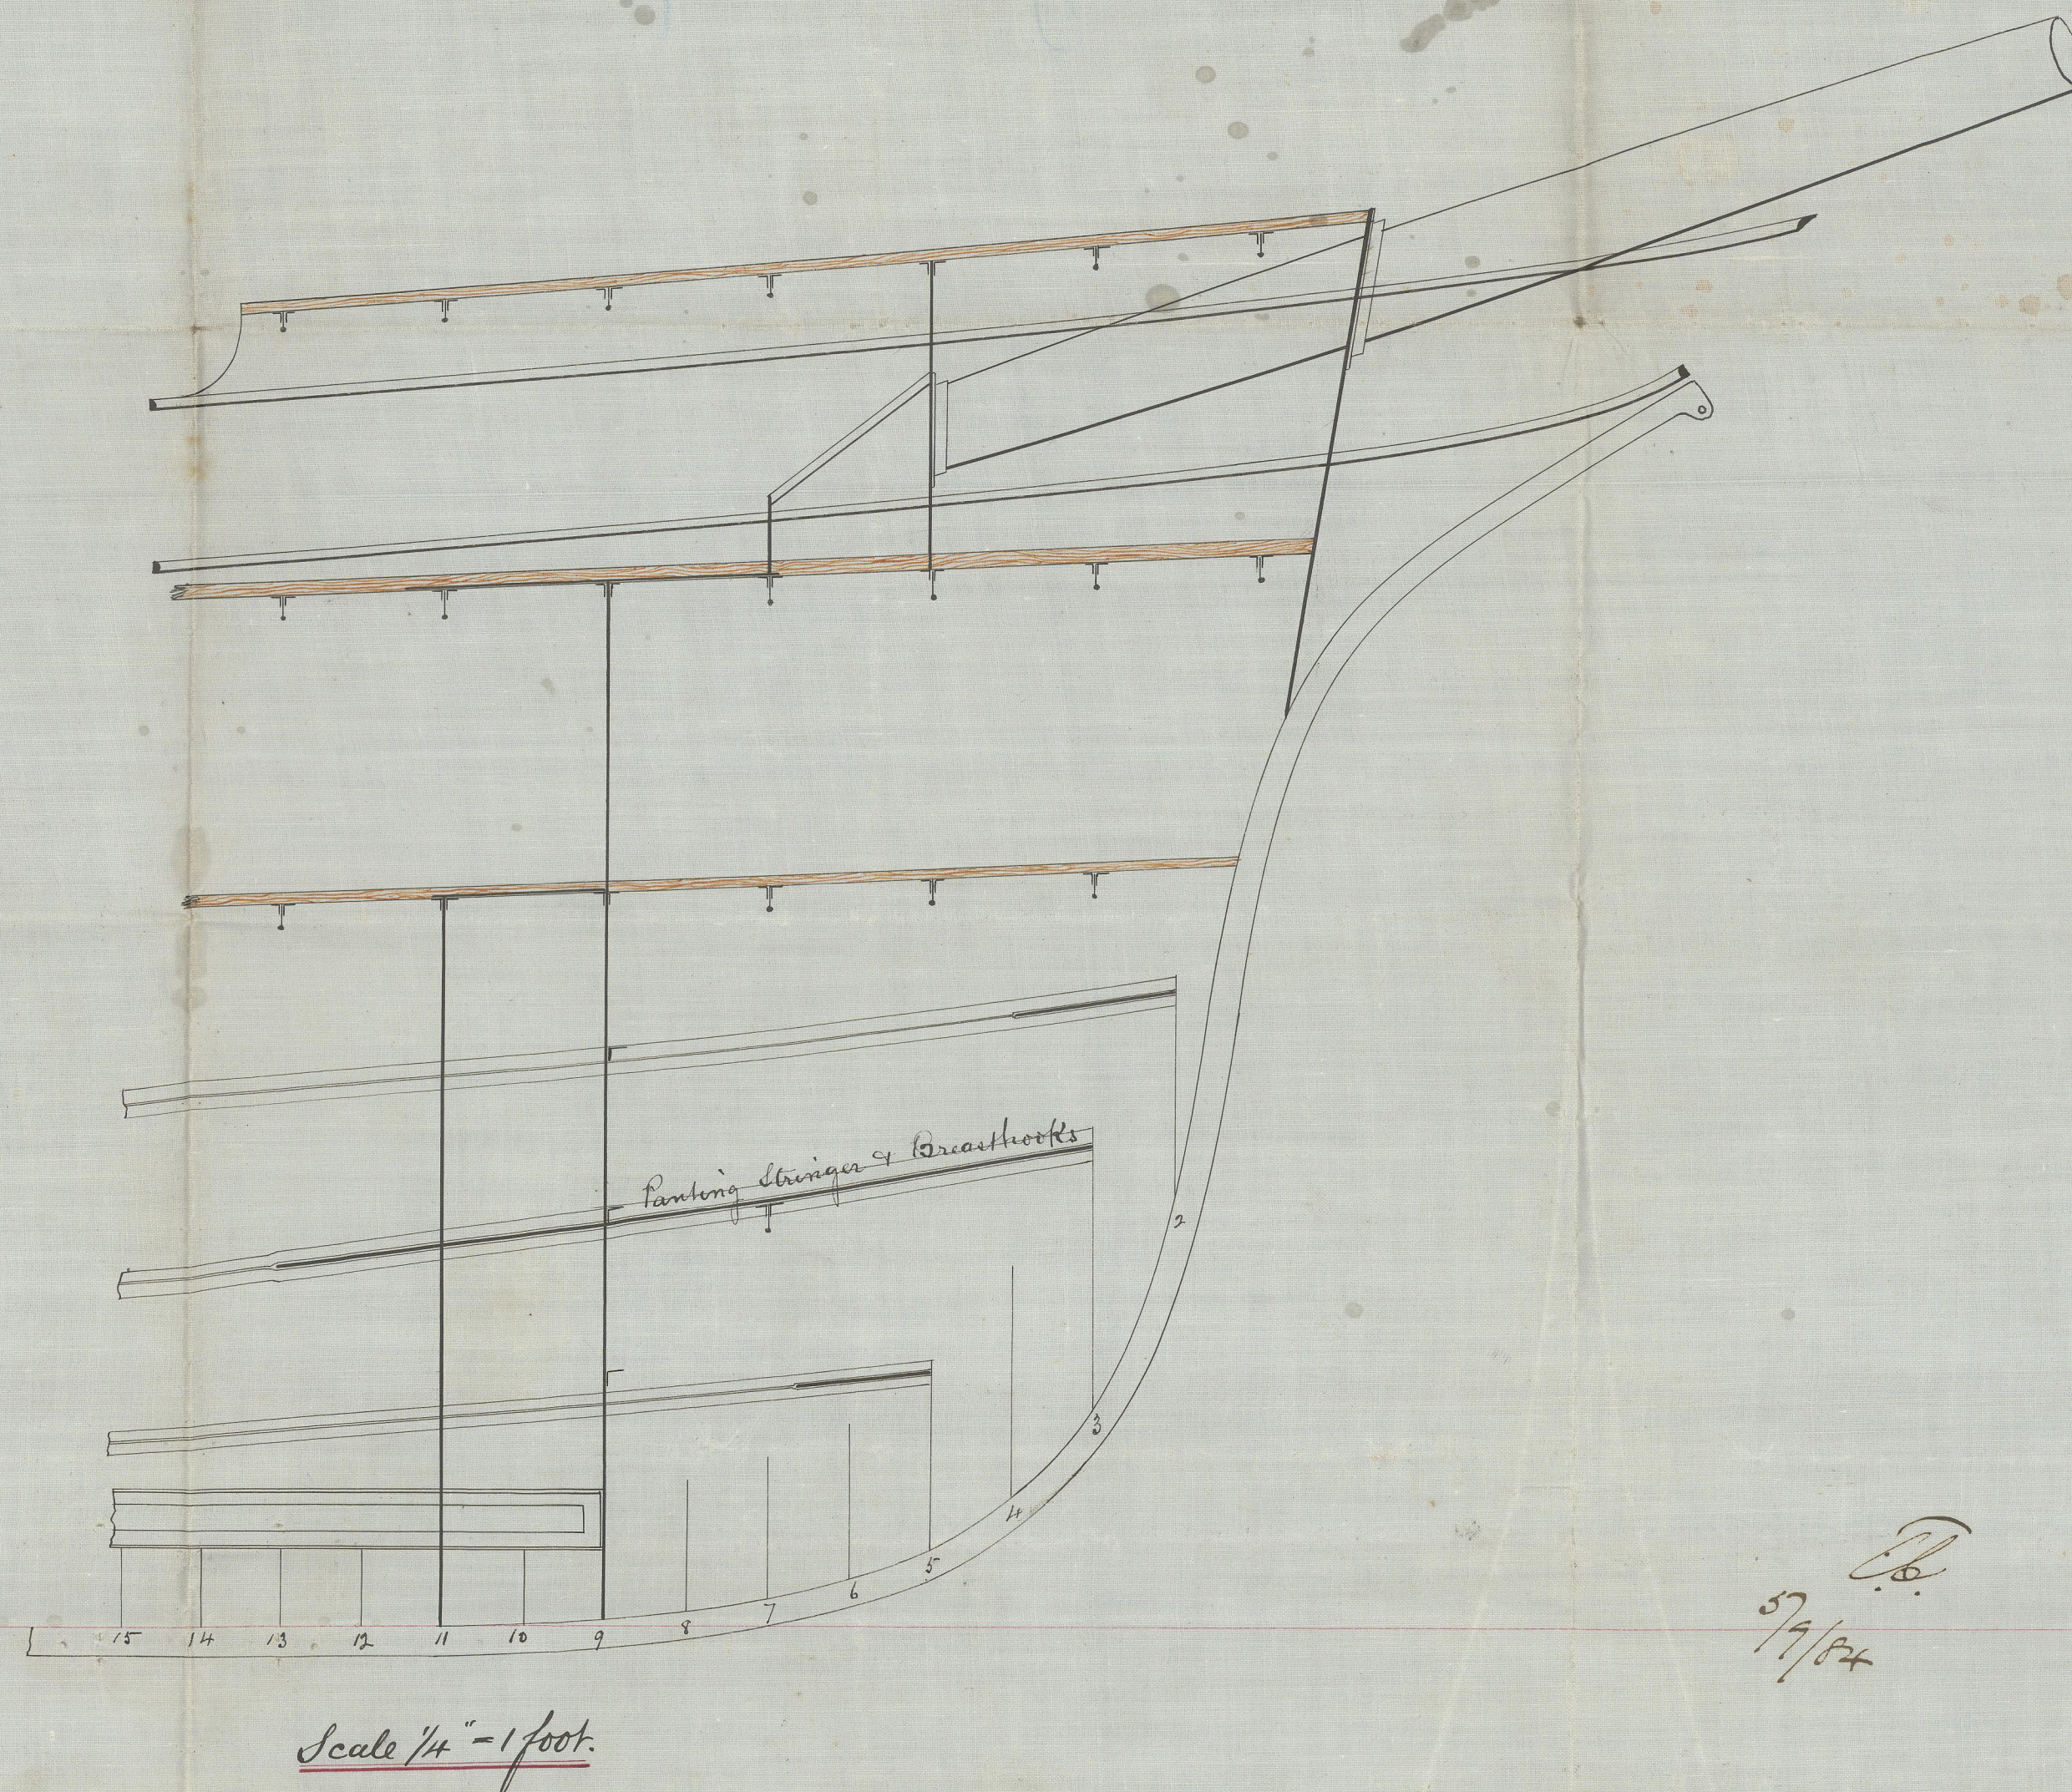


ROBERT DUNCAN & CO
SHIP BUILDERS
PORT GLASGOW

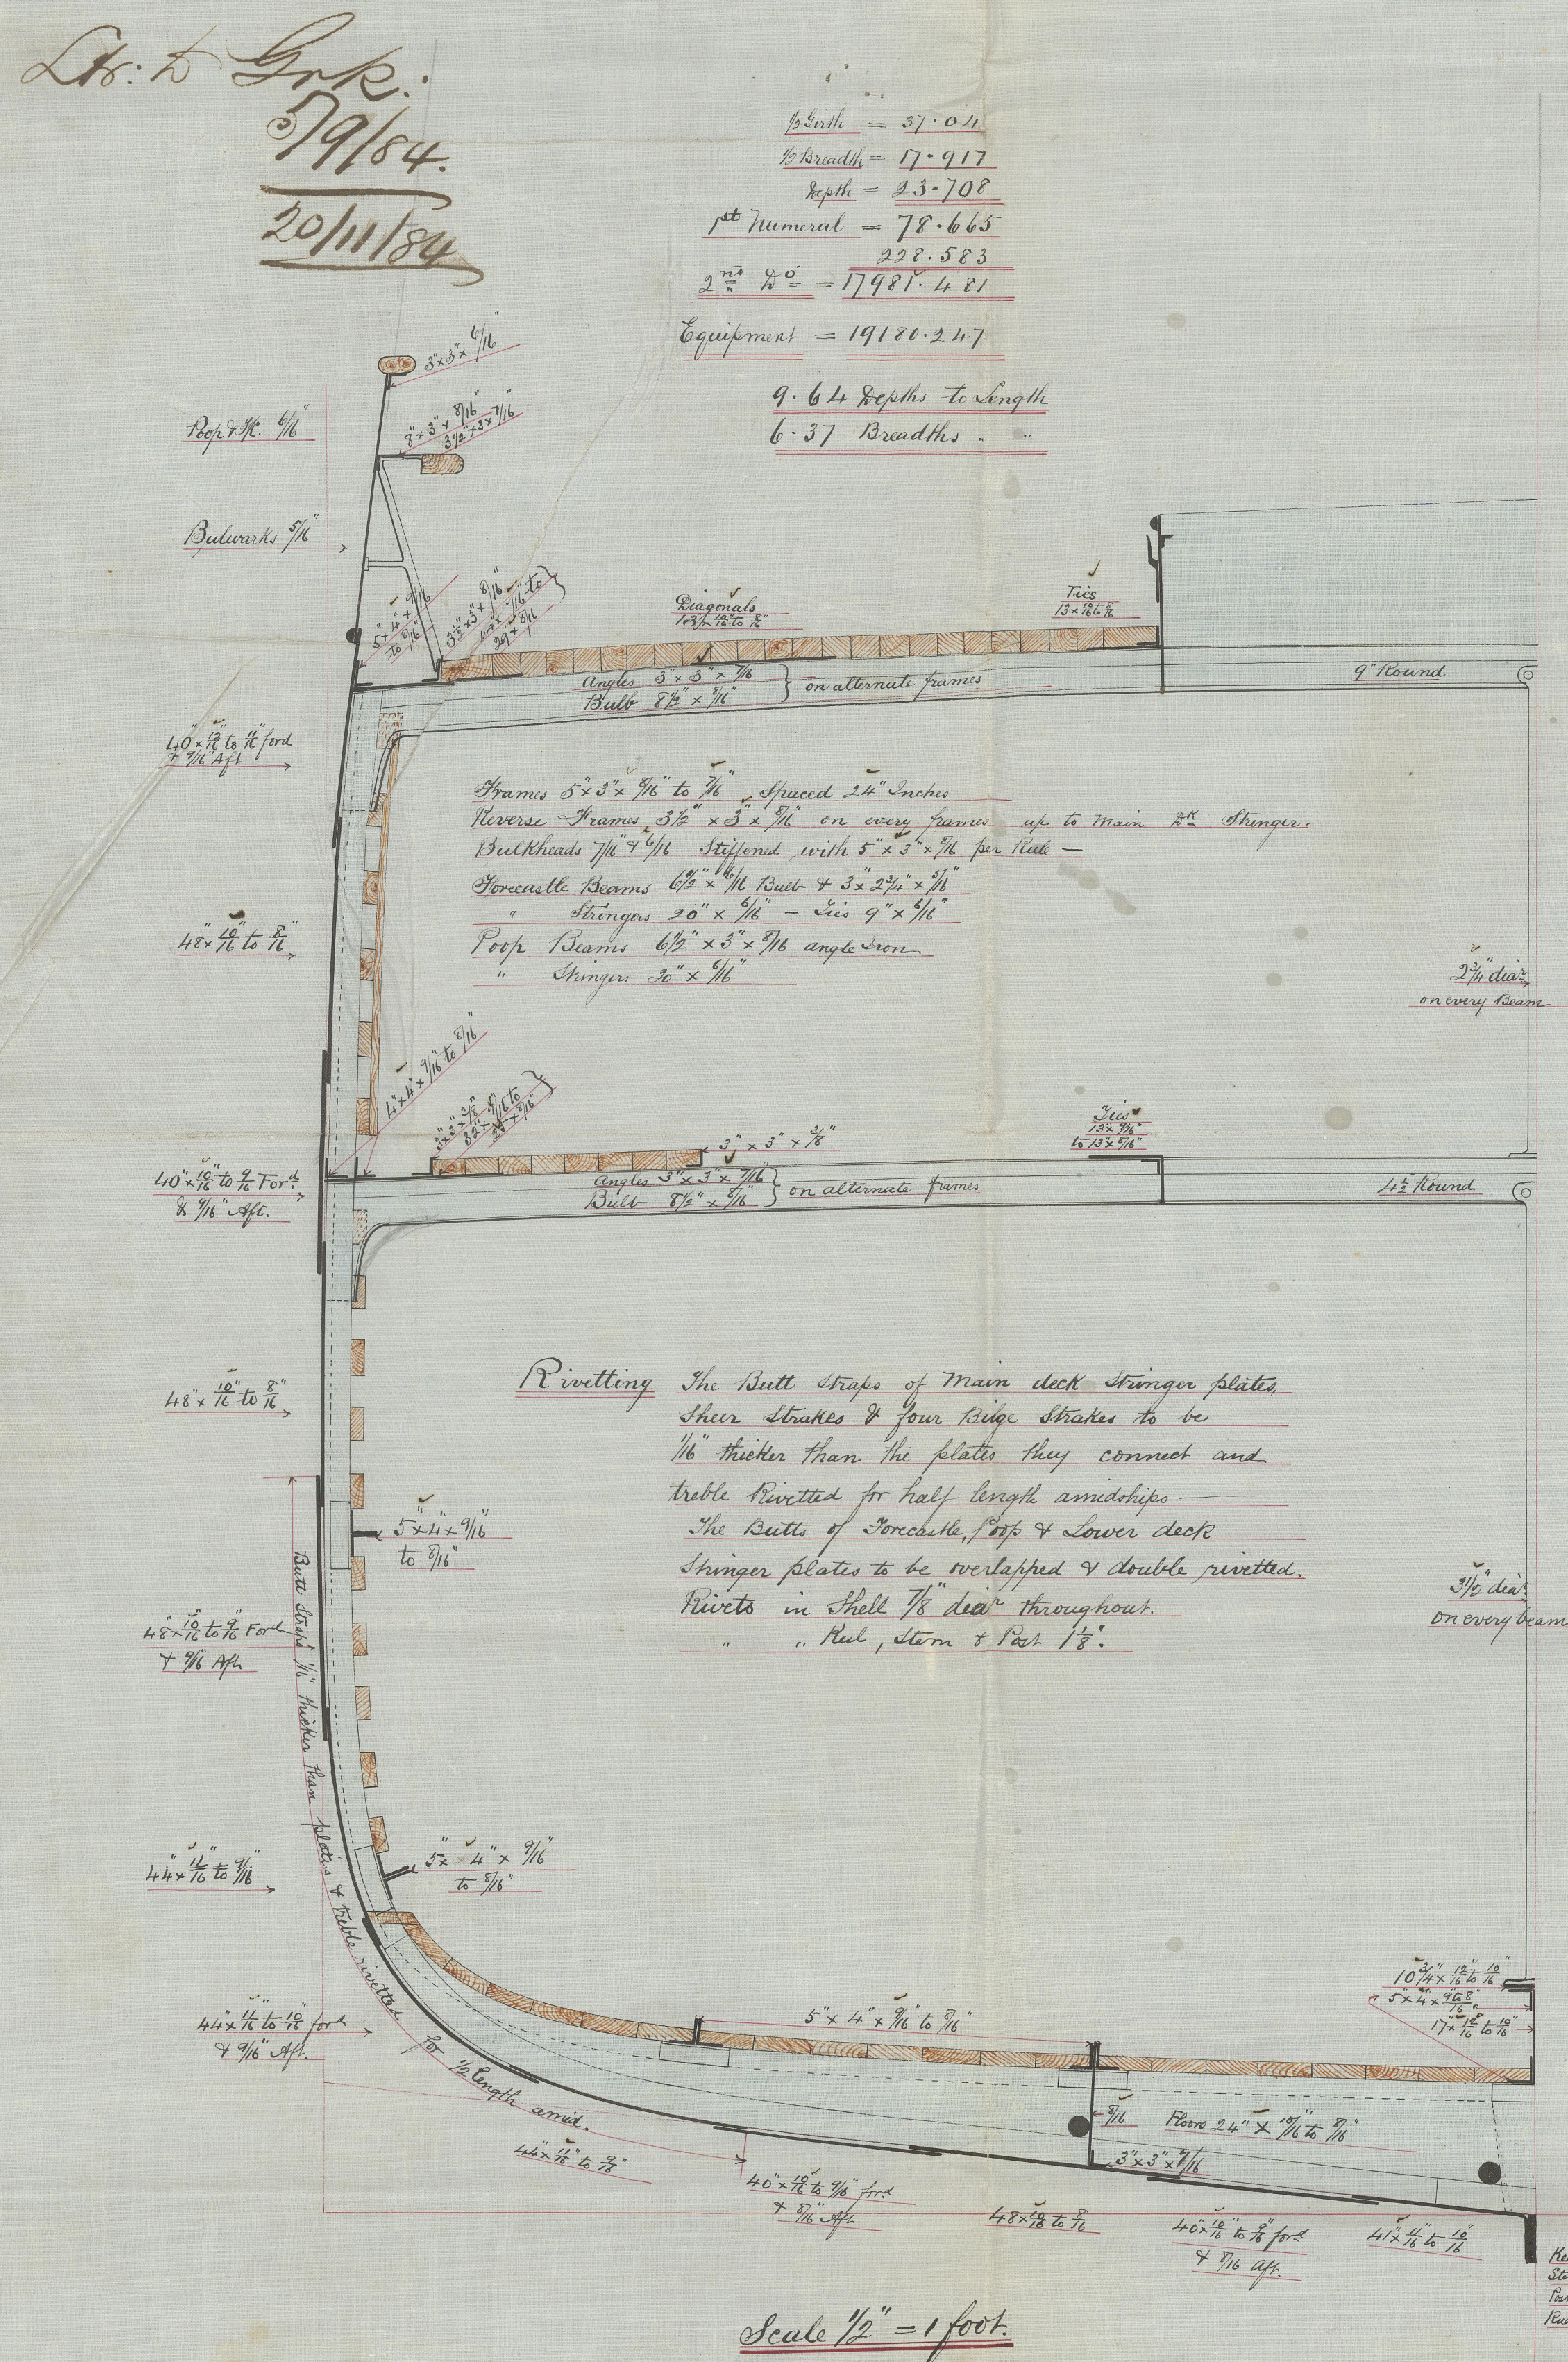









© 2020

Lloyd's Register
Foundation