

Lloyd's Register of British and Foreign Shipping.

(Report on Vessel No. _____ Port _____)

No. 153a

SHIP FORGINGS OR CASTINGS.

I have to report that the undermentioned Iron or Steel Forgings or Castings, manufactured by

The Darlington Forge Co of *Darlington*

for the Vessel No. *218*, being built by *Wm R Duncan & Co*

of *Port Glasgow* have been inspected by me as set forth below, and found

to be, so far as can be seen, *sound and efficient.*

The words FORGINGS or CASTINGS, IRON or STEEL, should be struck out as may be required.

Mark on Forgings.

Lloyd's

No. 153a


W.C.

A. Cameron

Sunderland

| | STERN FRAME. | RUDDER FRAME. | STEM. |
|------------------------|--|---|------------------------|
| Material* | <i>Scrap Iron</i> | <i>Scrap Iron</i> | <i>Scrap Iron</i> |
| How made | <i>Forged</i> | <i>Forged</i> | <i>Forged</i> |
| Dimensions | <i>8 1/2" x 2 1/2"</i> | <i>6" x 3"</i> | <i>8 1/2" x 2 1/2"</i> |
| Progress on Inspection | <i>Forged & smithed</i> | <i>Forged & smithed</i> | <i>forged</i> |
| Dates when Inspected | <i>Sept 6-12-18-25 Oct 2-6-10 15-18-24-28 Nov 5/84</i> | <i>Dec 14-11-18-20-31 Jan 3 8-19-26-28/85</i> | <i>Sept 6-12/84</i> |

SKETCHES OF FRAMES SHEWING POSITION AND DESCRIPTION OF WELDS OF FORGINGS, OR PARTICULARS OF TESTS APPLIED TO CASTINGS.

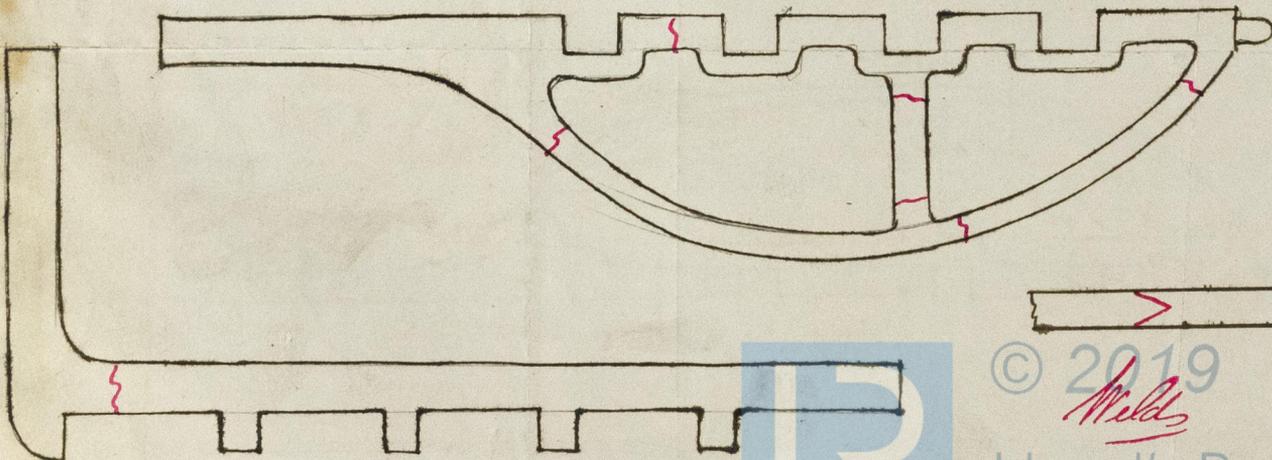

© 2019

Mills

Lloyd's Register
Foundation

GRK304-0152

* If of Iron, state whether scrap or puddled Iron.