

Received at

Office,

16

Lloyd's Register of British and Foreign Shipping.

(Report on Vessel No. Port)

No. 898

SHIP FORGINGS OR CASTINGS.

I have to report that the undermentioned Iron or Steel Forgings or Castings, manufactured by

The Harbour Forge Co of Irvine.

for the Vessel No. 847 being built by Messrs R. Duncan & Co
of Port Glasgow have been inspected by me as set forth below, and found
to be, so far as can be seen, sound and efficient.

Mark on Forgings.

Lloyd's

No. 898


G. N.

George Newcomb
Glasgow,

3/3/85.

	STERN FRAME.	RUDDER FRAME.	STEM.
Material*		Scrap iron	
How made		Forged	
Dimensions		6 1/4 and 3 5/8	
Progress on Inspection		Forged & smithed	
Dates when Inspected		27/11/84. 9.26/12/84. 5.17. 27/2/85. 2/3/85.	

SKETCHES OF FRAMES SHEWING POSITION AND DESCRIPTION OF WELDS OF FORGINGS, OR PARTICULARS OF TESTS APPLIED TO CASTINGS.

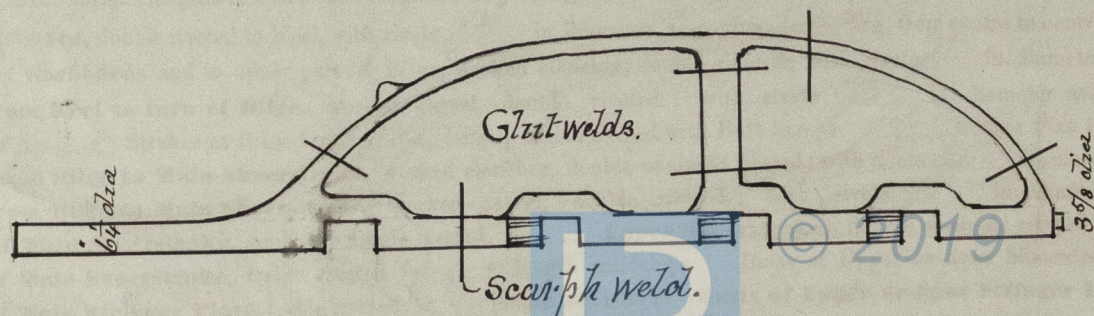

* If of Iron, state whether scrap or puddled Iron.