

# Lloyd's Register of British and Foreign Shipping.

(Report on Vessel No. \_\_\_\_\_ Port \_\_\_\_\_)

To. 1048

## SHIP FORGINGS OR CASTINGS.

I have to report that the undermentioned Iron ~~or Steel~~ Forgings ~~or Castings~~, manufactured by  
*The Lancefield Forge Co* of *Glasgow*  
 for the Vessel No. *92*, being built by *Messrs Murdock & Murray*  
*Port Glasgow* have been inspected by me as set forth below, and found  
 to be, so far as can be seen, *sound and efficient.*


Mark on forgings.

L.L. &  
 No. 1018  
 G.N.

*George Newcomb*  
*Glasgow* 5/8/85.

	STERN FRAME.	RUDDER FRAME.	STEM.
Material*	/	Scrap iron	/
How made		Forged	
Dimensions		4 1/4 x 2 1/2	
Progress of inspection		Forging & smithing	
Places when tested		4.10.13.27.31/7/85. 4/8/85.	

SKETCHES OF FRAMES SHEWING POSITION AND DESCRIPTION OF WELDS OF FORGINGS, OR PARTICULARS OF TESTS APPLIED TO CASTINGS.

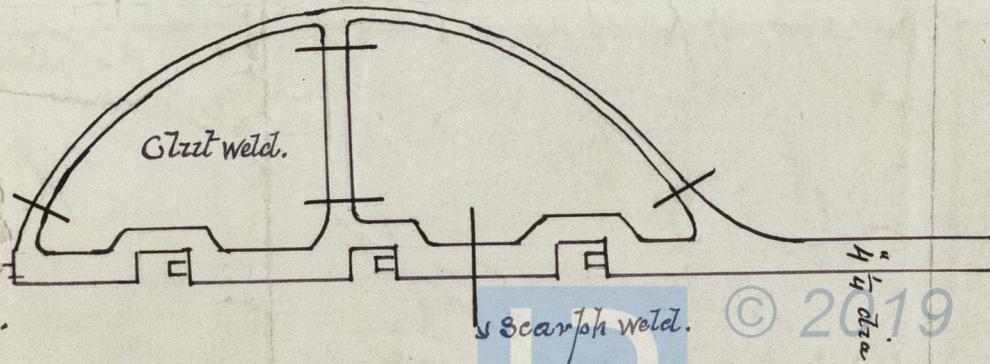

© 2019

Lloyd's Register Foundation

\* If of Iron, state whether scrap or puddled iron.