LLOYD'S REGISTER OF SHIPPING RECEIVED 1 JUN 85 LONDON

LLOYD'S REGISTER OF SHIPPING RECEIVED 1 JUN 85 LONDON

LLOYD'S REGISTER OF SHIPPING RECEIVED 1 JUN 85 LONDON

S.S. "Captain McClure"

Greenock Report No. 9020

LLOYD'S REGISTER OF SHIPPING GREENOCK OFFICE SURVEYOR REGISTERED

2.4.85
11/18/6/85

MIDSHIP-SECTION.

S.S. No. 92

Scale ½ Inch = 1 Foot.

Class 100 A.

Depth	15·7
½ Breadth	11·75
½ Girth	24·25
1st Numeral	51·7 ✓
Length	168·9
	4653
	4136
	3102
	517
2nd Numeral	873213 ✓
add 1/10th	87321
Equipt Numeral	960534 ✓
Breadth to Length	7·18
Depth to —	10·75 ✓

Equipment.

2 Bower Anchors. 10 cwt. Ex Stock } Collective Wt.
1 — " — 8½ — " — } 28½ cwt.
1 Stream — " — 3¾ — " —
1 Kedge — " — 1¾ — " —
1 — " — ¾ — " —
195 Fathoms 1⅛" Stud Chain Cable.
60 — " — ¾ Stream Chain
75 — " — 8" Towline
90 — " — 6" Warp.

Note. Quarter Deck Scantling in Red.
Frames all to Gunnals of Break.
Reverse Frames to Hold Stringer & B. Stringer alt.
Sheer Strake doubled for 26 ft. ends of Break.
increased ⅛ at Break. Butt Straps of Sides of Break. Sheer Strake & Strake next below ⅛ thicker & treble riveted. Main Stringer 7 frame spaces abaft Break. & Break Stringer 4 frame spaces before Break.

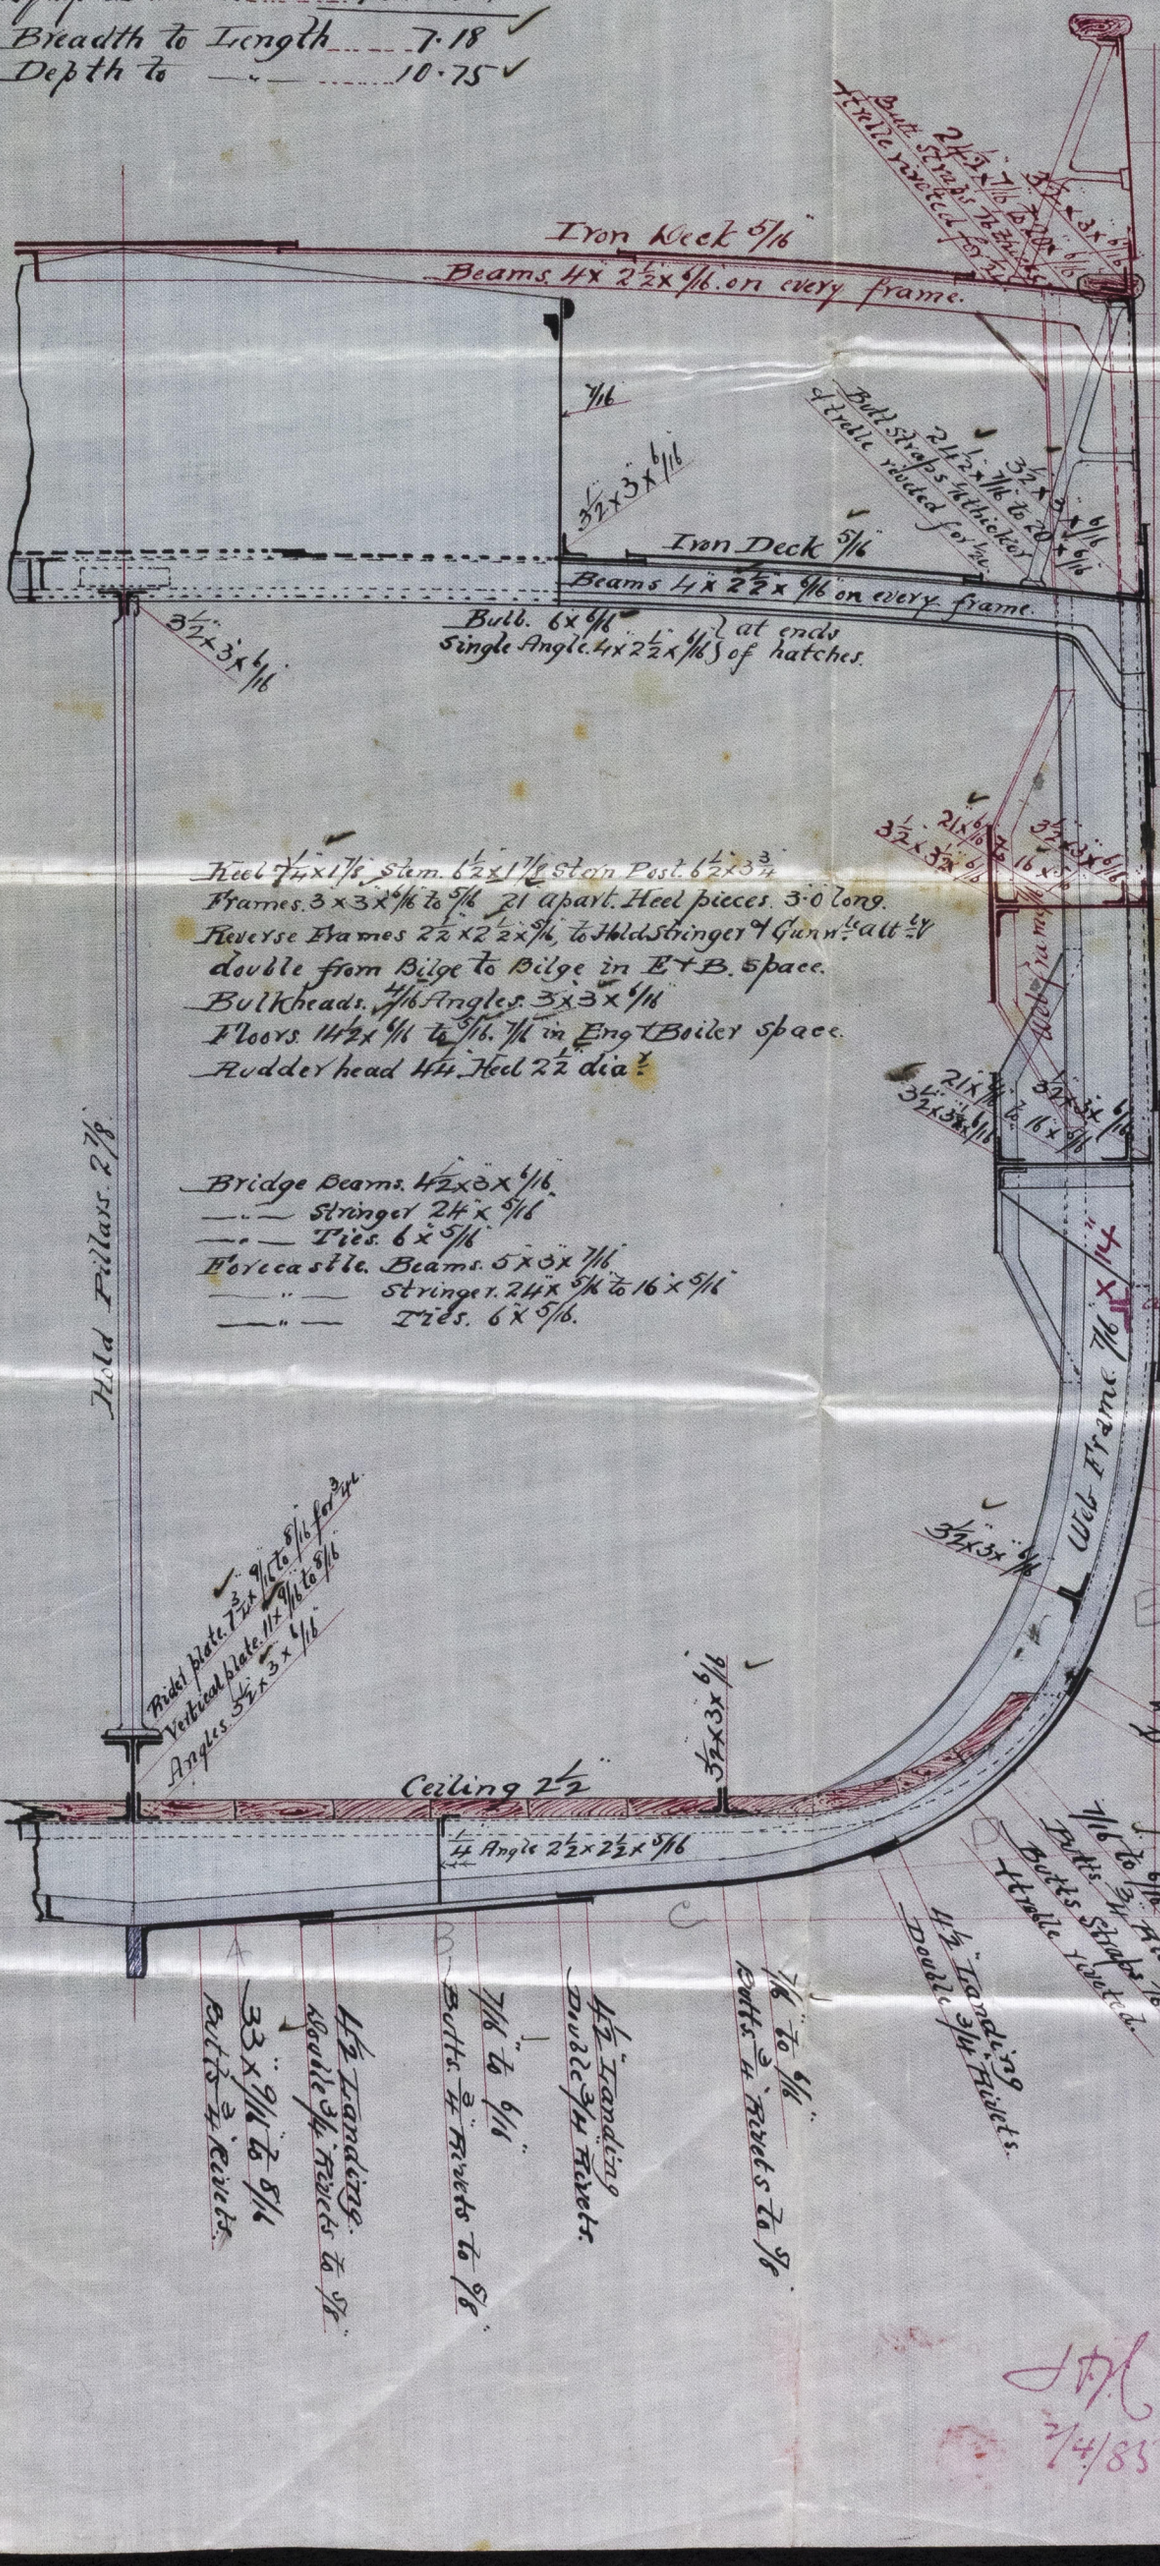

MURDOCH & MURRAY IRON SHIPBUILDERS 23rd MARCH 1883 PORT-GLASGOW

J.P.K. 2/4/85

© 2021 Lloyd's Register Foundation