


2.4.86
11/18.6.85

No 92
SCREW STEAMER
170 x 23.6 x 14.6 Hold
Scale 1/4" Inch = 1 Foot

Greenock Report No. 9020.

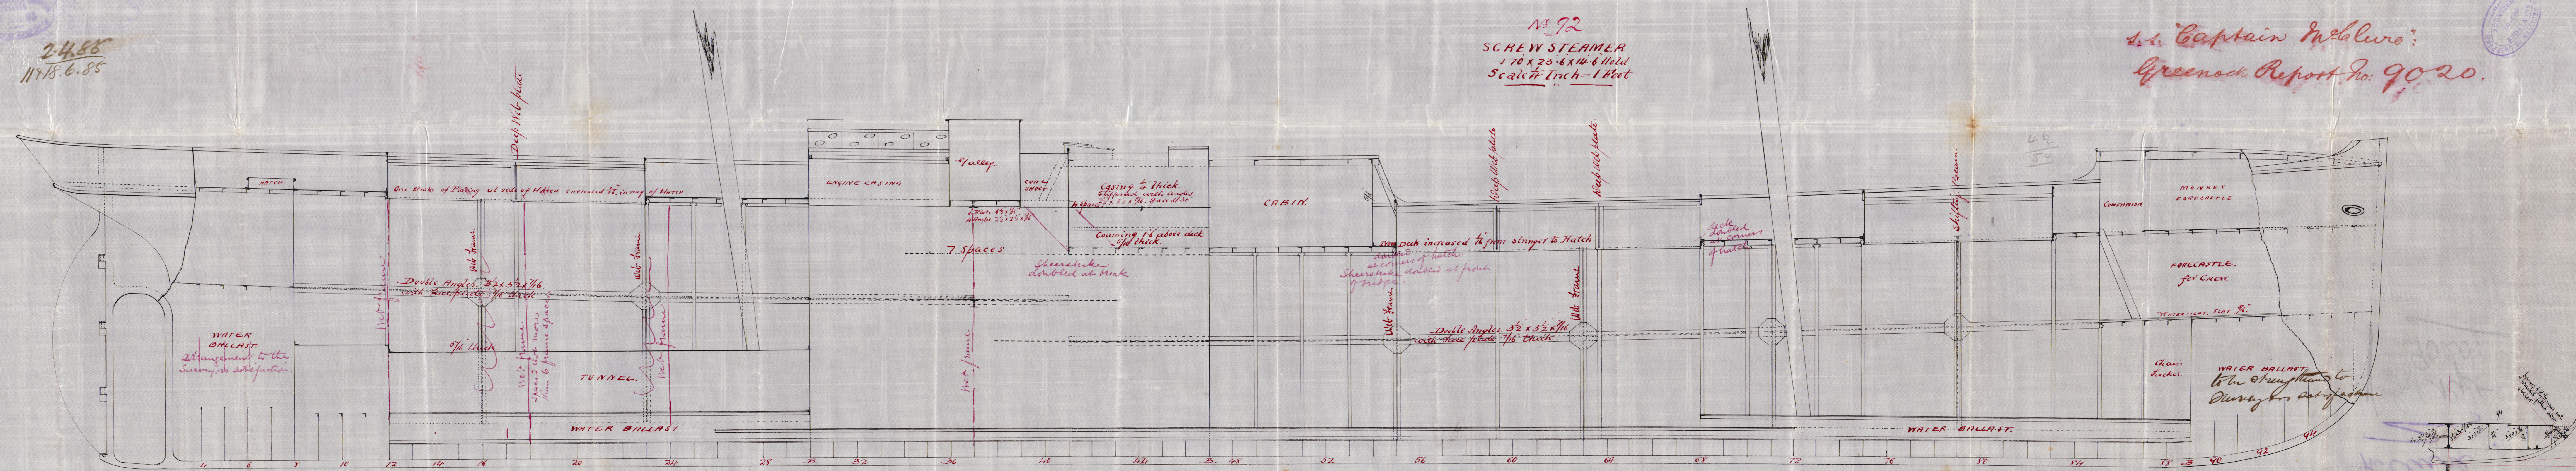

Transverse Section of Ballast Tanks.
23rd March 1885
OK.
1/4" 7/485
Lloyd's Register Foundation
© 2021

11 Brixham 11

ex

Captain

Inclosure

Grk Rpt
9020.

Q RH305-0100

© 2021

Lloyd's Register
Foundation