


Ltr. to Glas:
19/8/85

BOILER N° 174

To be constructed throughout of best Mild Steel Boiler quality to Lloyds requirements for a working pressure of 100 lbs per sq inch and have their Certificate -

Shell 8% at joint
Longitudinal seams quadruple riveted $4\frac{1}{4}'' \times \frac{1}{8}''$ zig-a-zag $3'' \times \frac{1}{8}''$
Circumferential seams double riveted $3\frac{1}{2}'' \times \frac{1}{8}''$ - $2\frac{1}{4}''$ zig-a-zag -

KINCAID & CO
GREENOCK
12 August - 85

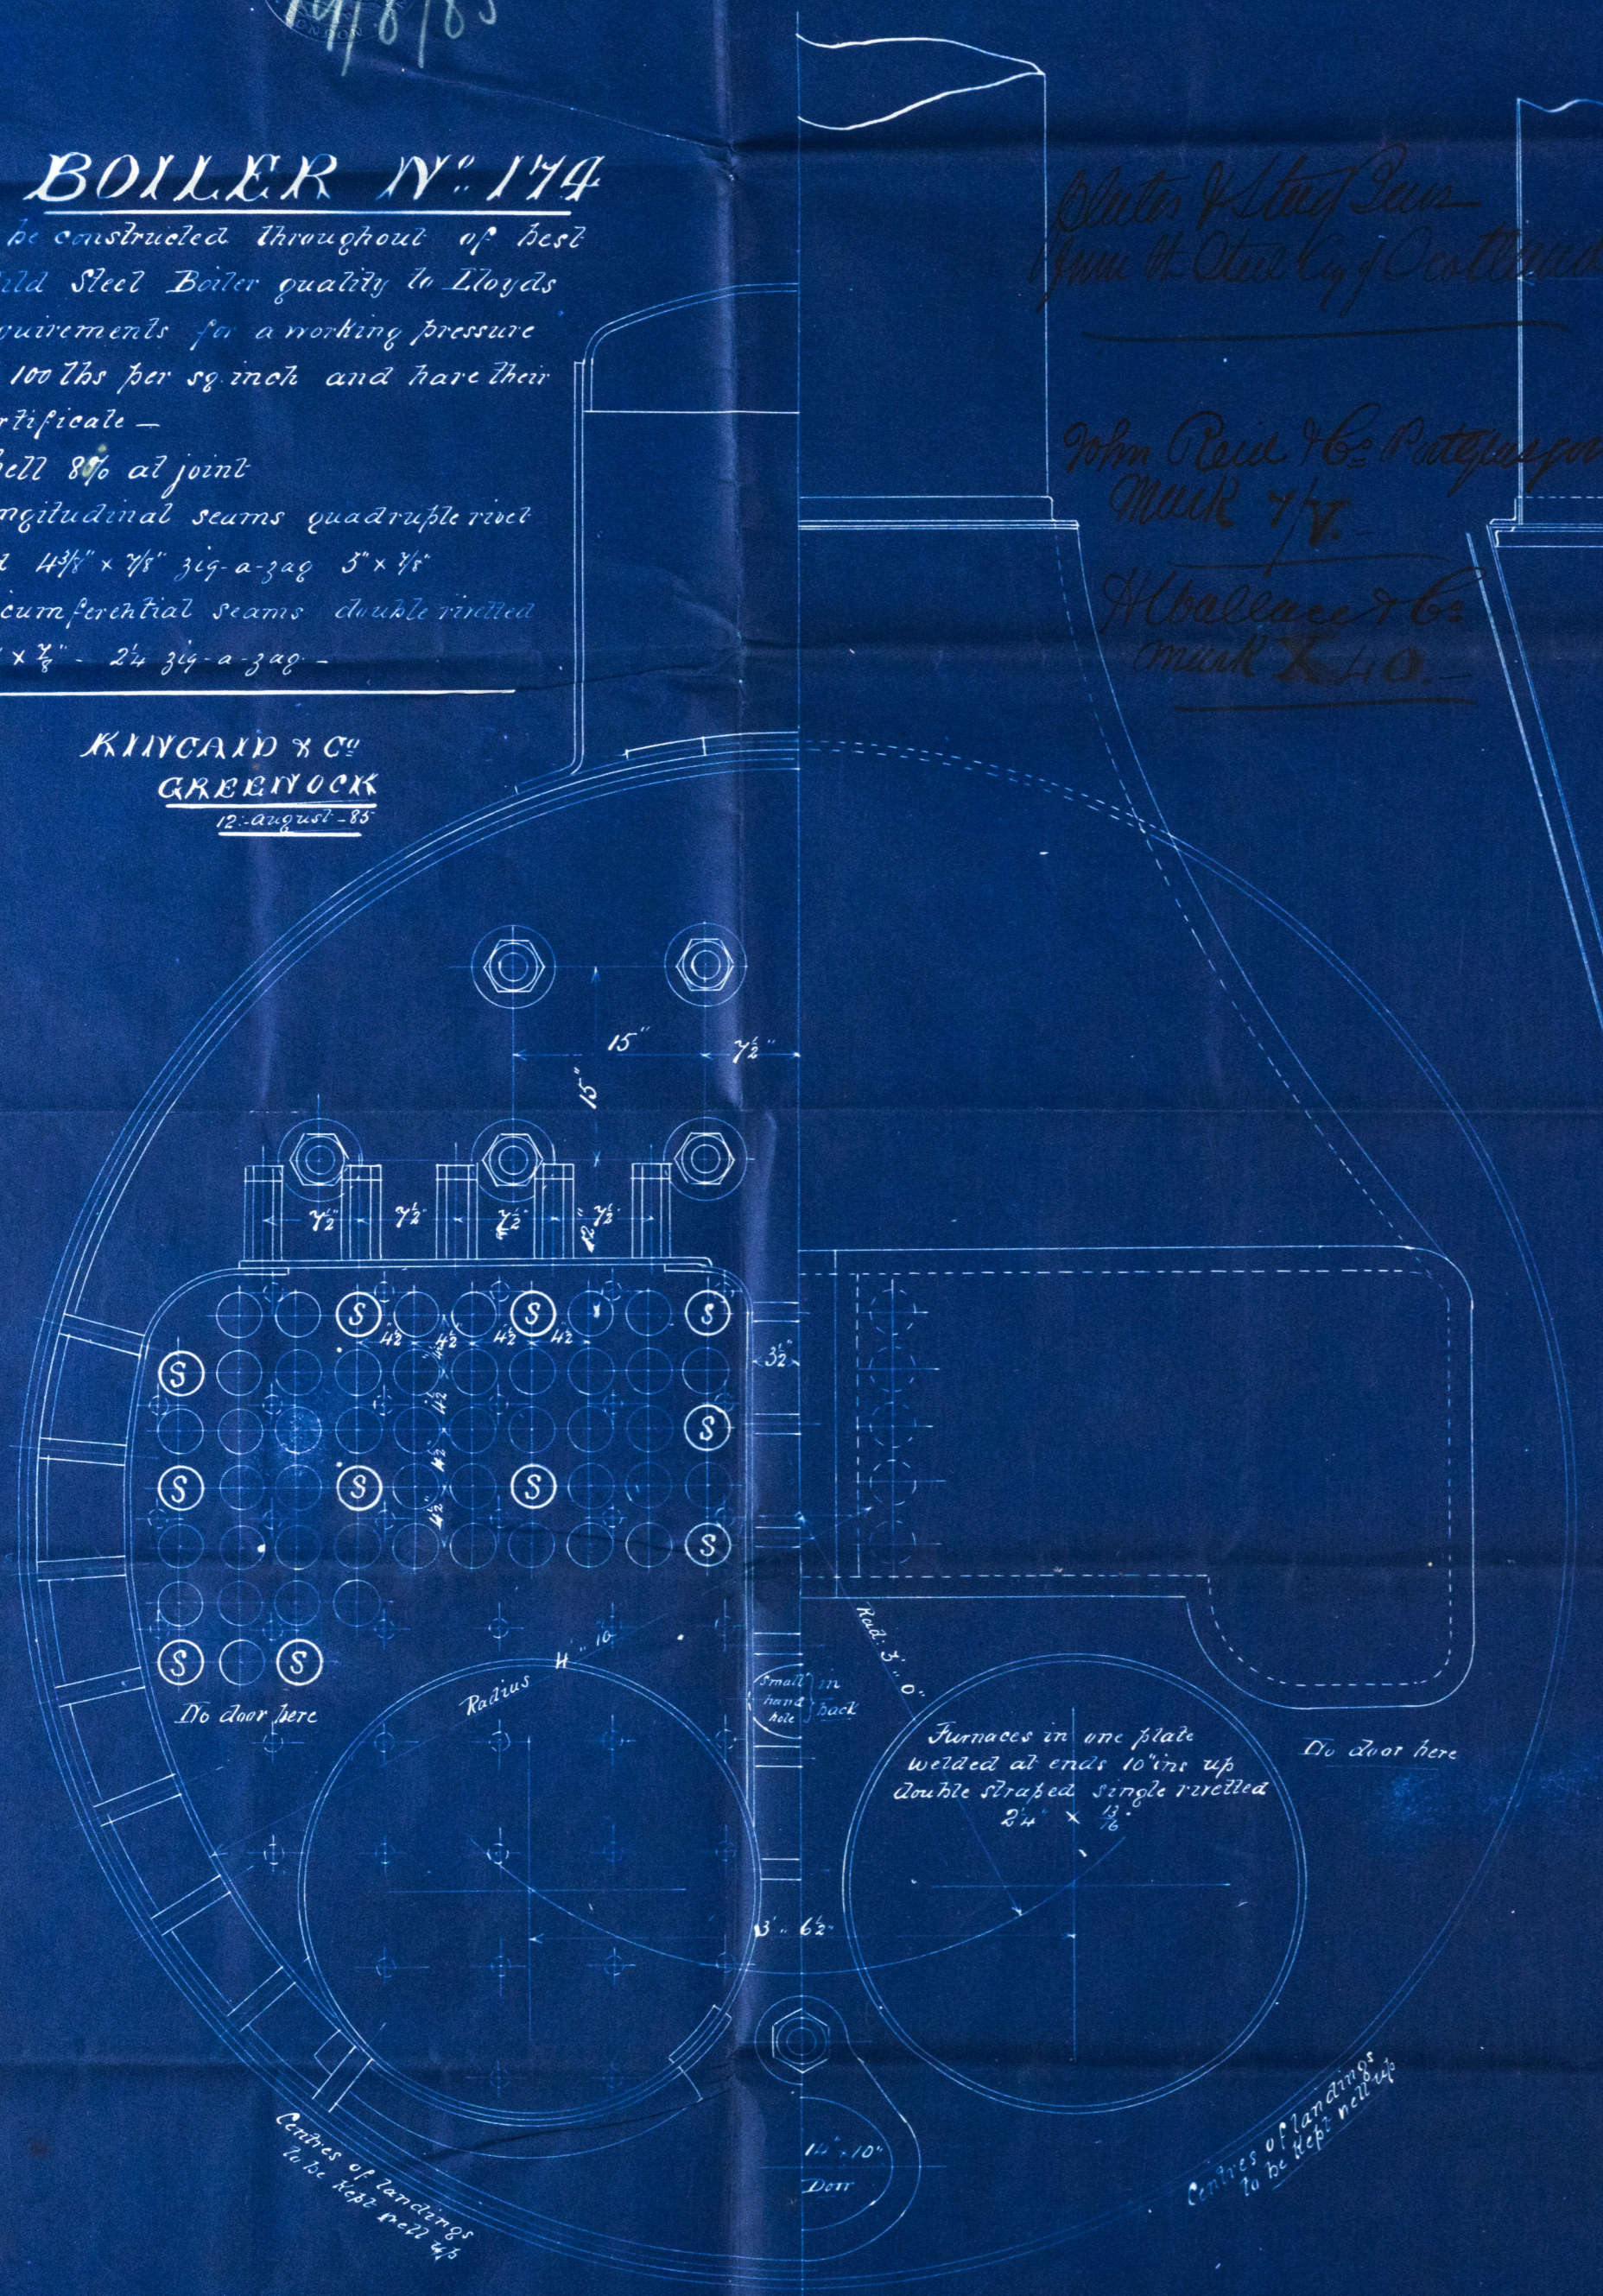


s.s. "Maule":
Greenock Report No. 9043.


John Reid & Co. Port Glasgow

H. Wallace & Co.

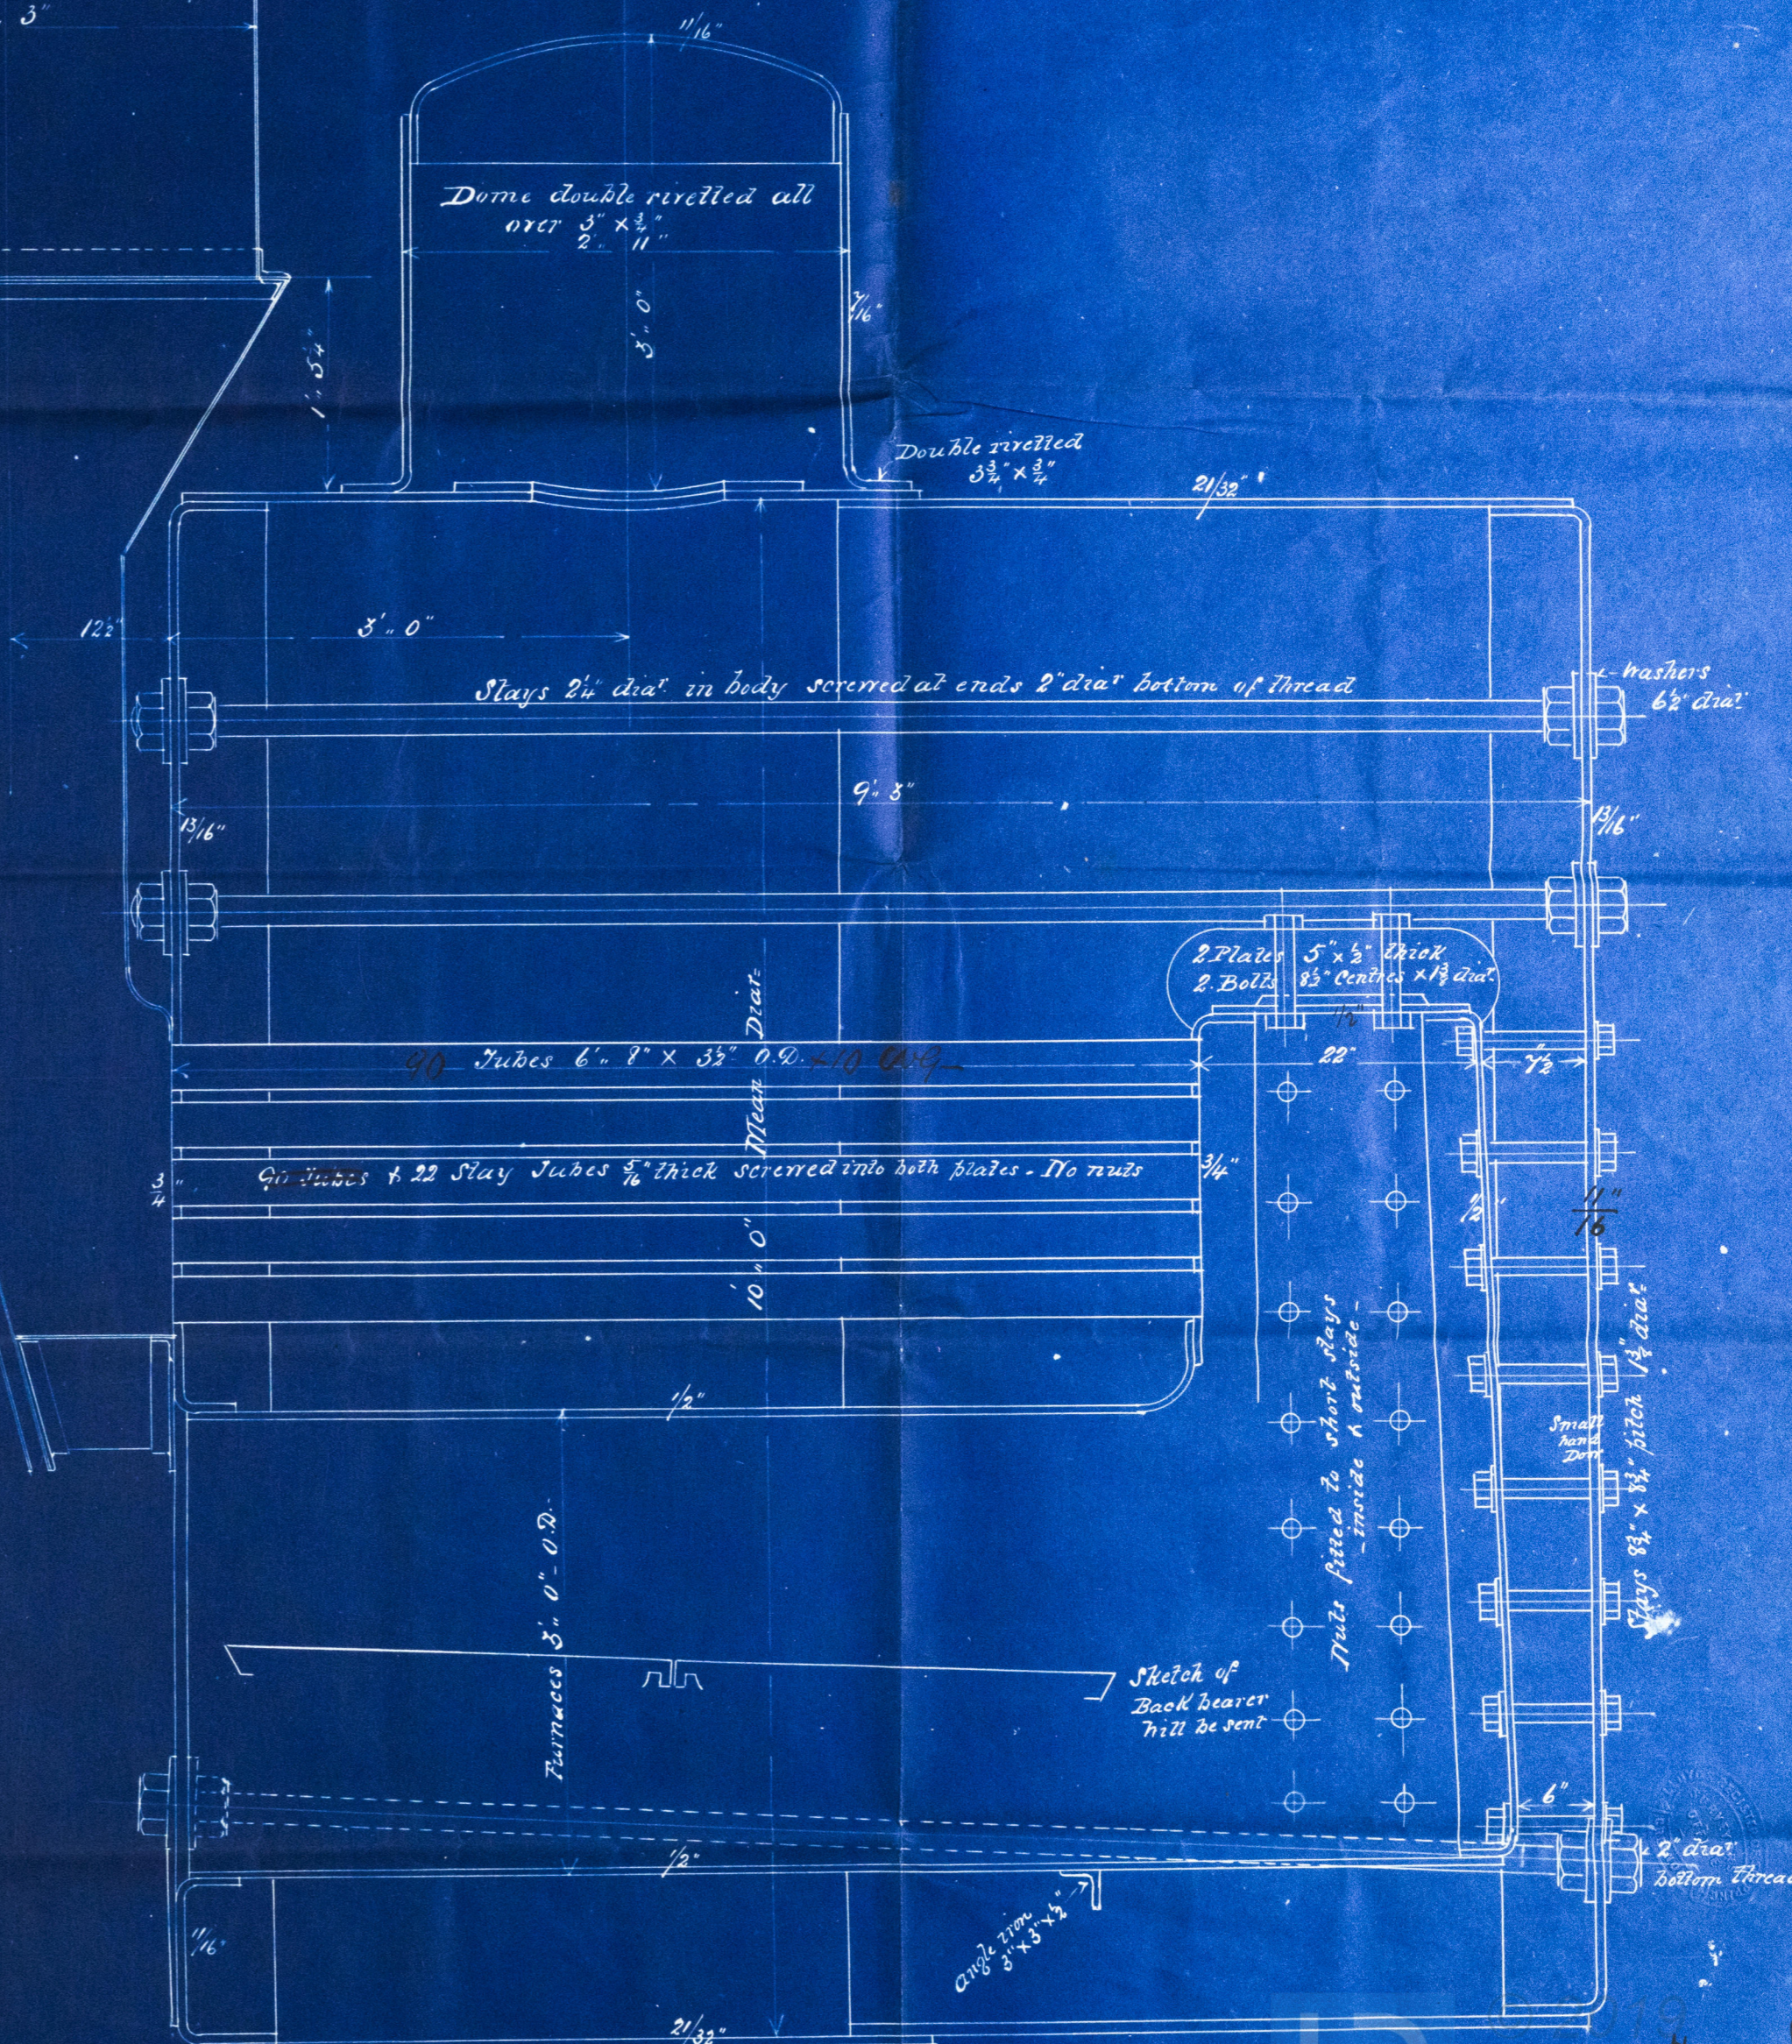

19/8/85
17/8/85
17/8/85