

# S.S. "Maule": Greenock Report No 9043

6/8/85  
19:18:55

7/16 Iron S.S.  
Midship Section

Scale 1/2" = 1 foot

Class 80A Lloyds


1/2 B	11.75
1/2 S	19.85
D	10.00
41.6 Small No	
12.4	
16.64	
49.92	
51.58	Large No
13.62	5.2
2.62	12.4

JOHN REID & CO

SHIPBUILDERS,

PORT GLASGOW.

4/8/85 ARS

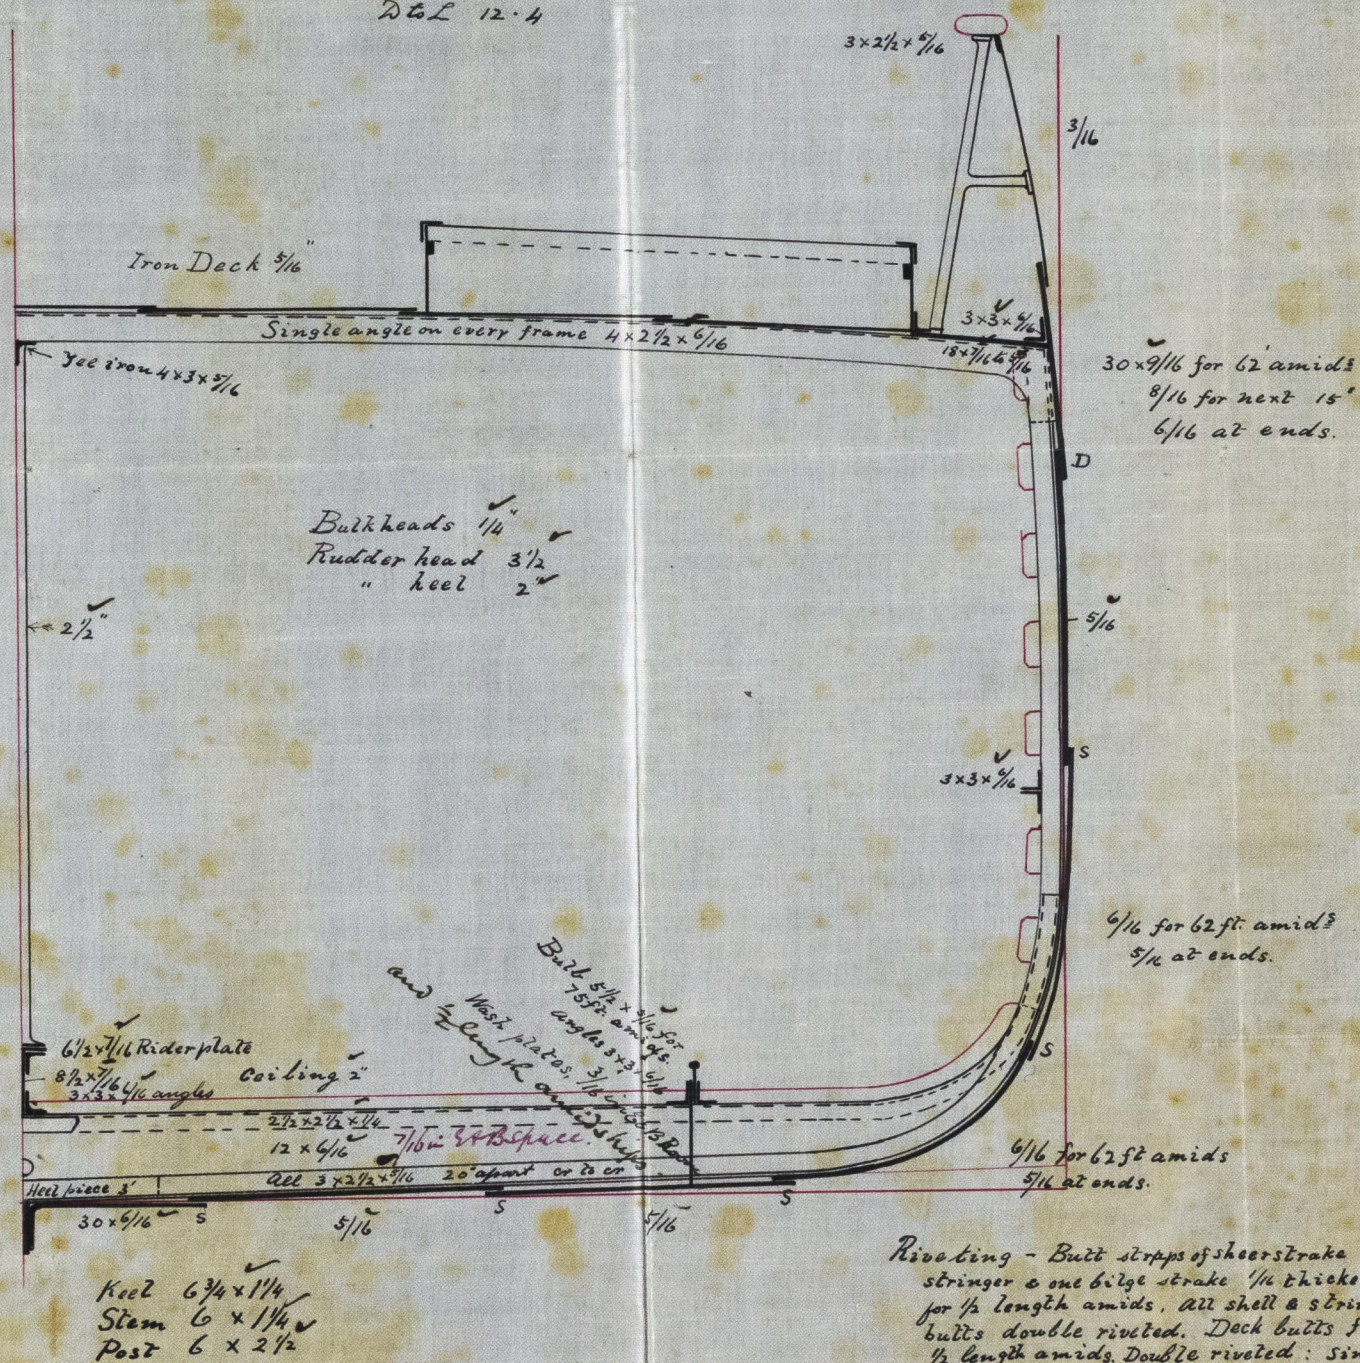

Riveting - Butt straps of sheers & strake stringer & one bilge strake 1/4" thicker for 1/2 length amids. All shell & stringer butts double riveted. Deck butts for 1/2 length amids. Double riveted: single at ends - 3/4" Rivets in shear strake. 5/8" " elsewhere.

GRH305-0145

J.H.L.  
6/8/85

