


RECEIVED
LONDON

App 17/11/85.

S.S. "Maule": Greenock Report No 9043.

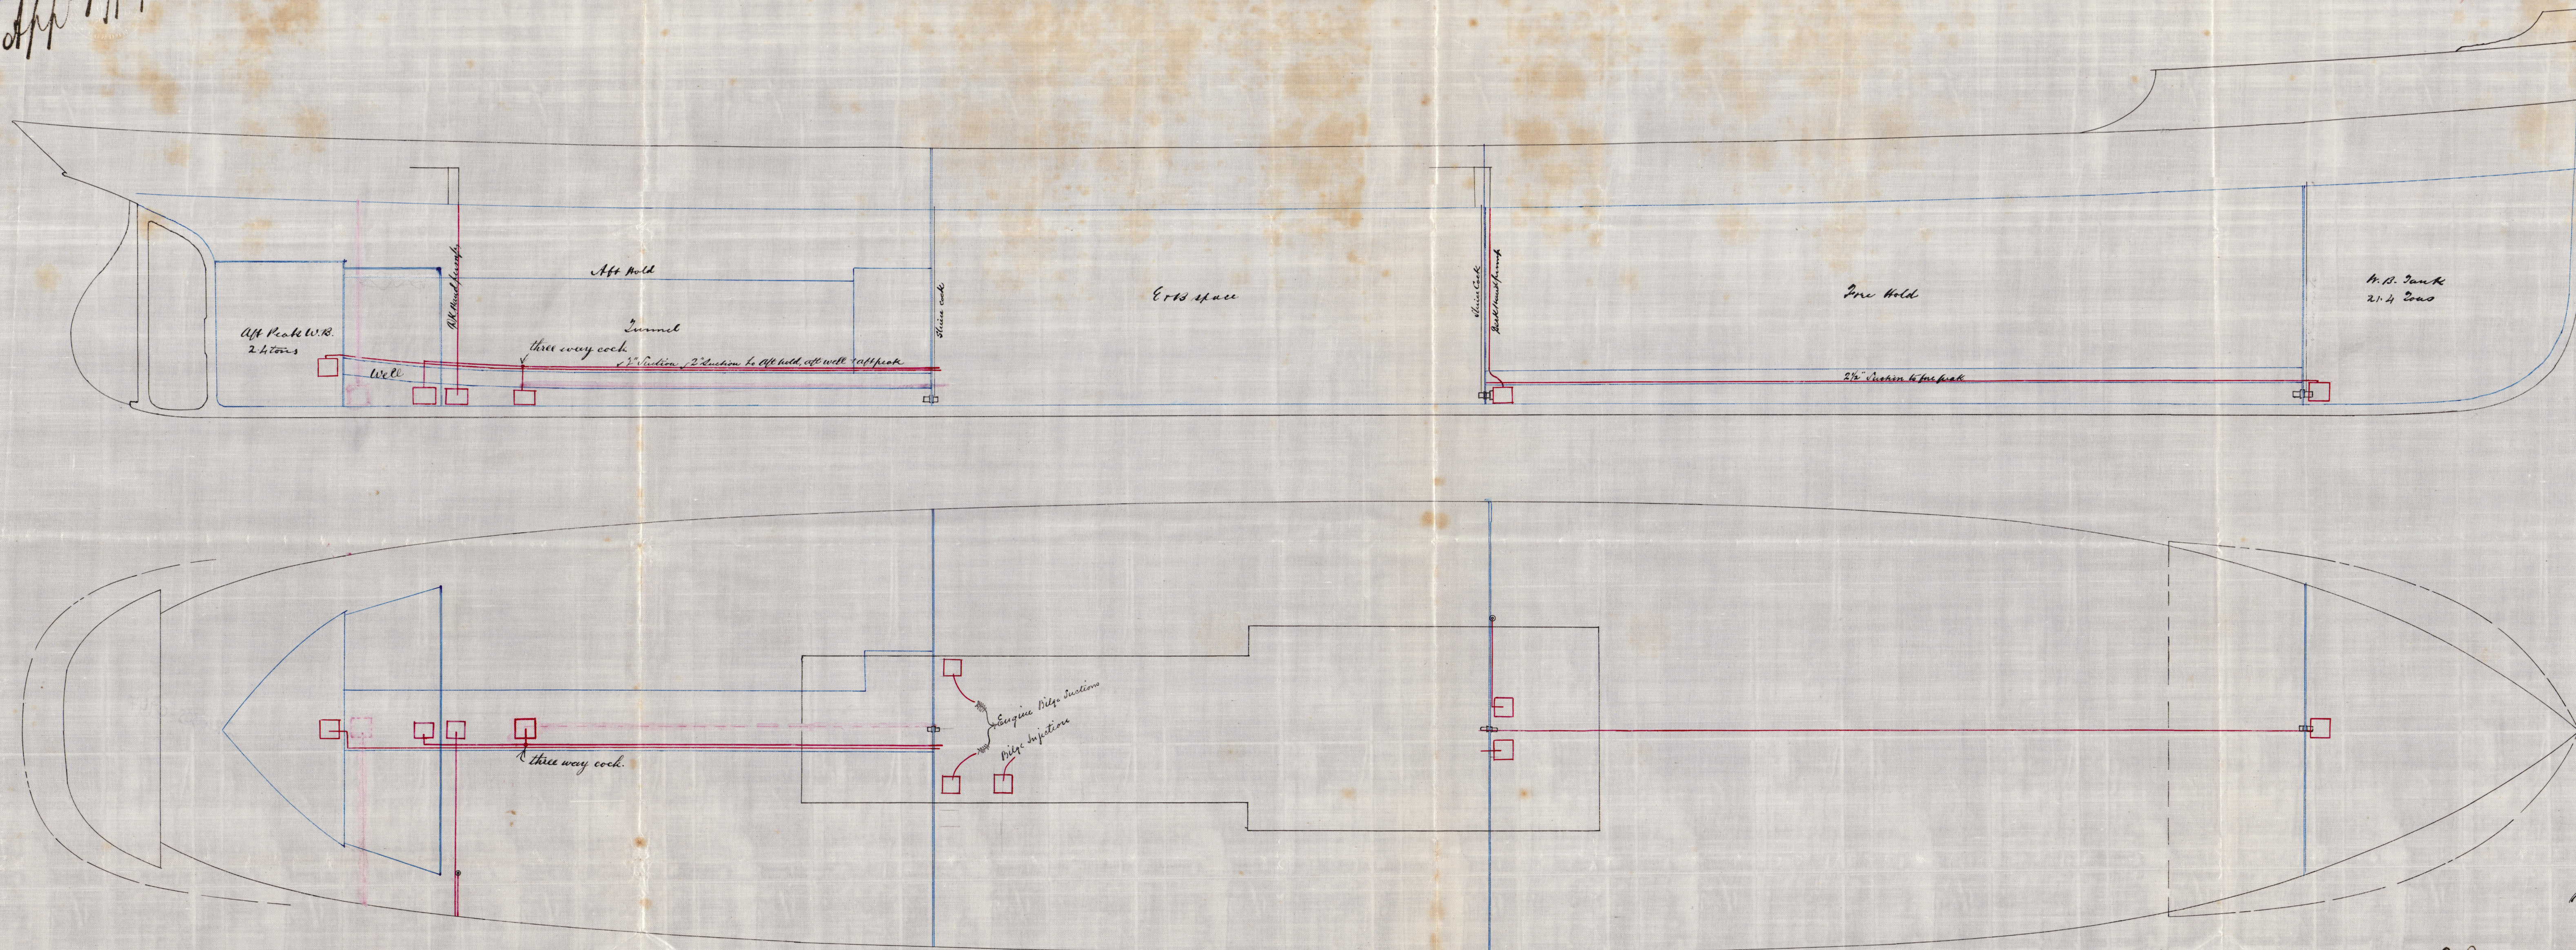

MP
17.11.85

Pumping Arrangement
S.D. 7/11.
Scale 1/4 inch
JOHN REID & CO
SHIPBUILDERS,
PORT GLASGOW

3/11/85

© 2021
Lloyd's Register
Foundation