



21.9.85.

Midships section for No 206 S.S.
Length Keel & Forecastle 129' 6"
Breadth of Beam — 25' 0"
Depth of Hold — 10' 0"
Gross tonnage about — 250 tons
Class. 100 A1 ~~B~~.
Scale 1/2" = one foot.

S.S. Amherst:

Eng. Report No. 9057.


Numbers for scantlings

Depth from keel	11.25
Half beam	12.41
Half depth	21.14
Fore numeral	44.8
Length on deck	128.5
Second numeral	5756.8
Addition for outfit	383.8
Outfit numeral	6140.6

Proportions
11.42 Depth to length
5.17 Beams to length

Outfit

2 Bower Anchors 3/4" cut each & stock tested to 8 tons
7 Stream Anchors 1 1/2" cut & stock tested to 3 1/2 tons.
1 Kedge " 1 1/4" " " "
165 fathoms 1/16" Chain Cable Admiralty test 13 1/2 tons
Breaking test 20 3/8" tons
45 fathoms 1/16" Strain chain tested to Act of Parliament.
75 fathoms 1/16" towline & 90 fathoms 1/4" Hawser

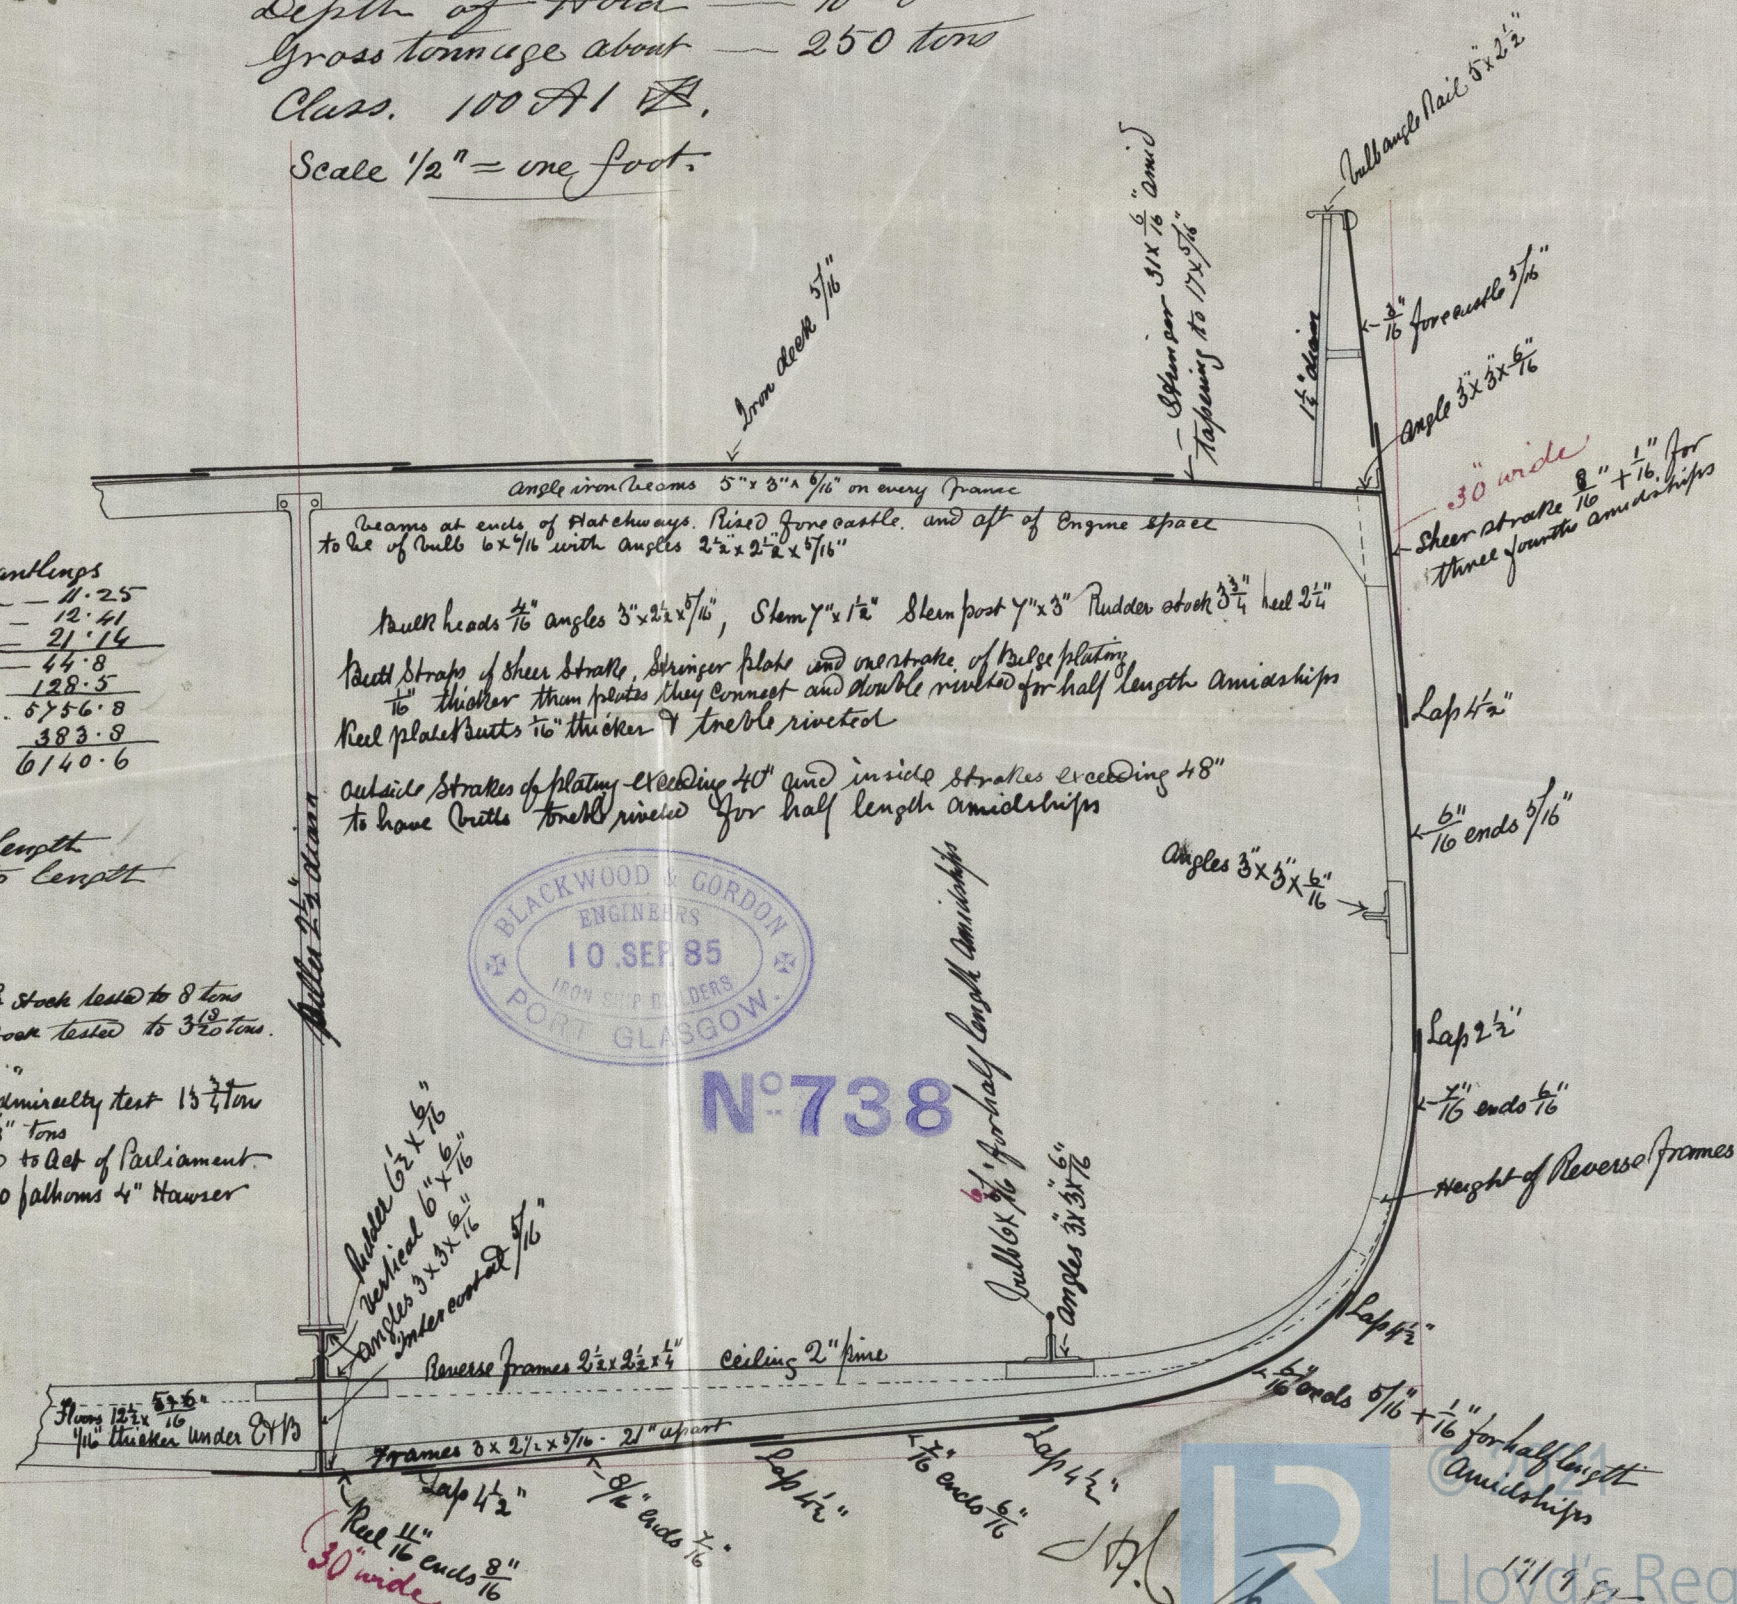

Lloyd's Register
Foundation

CRH 505-0158