


RECEIVED
18 SEP. 85
LONDON

21.9.85.

S.S. Amherst : Greenock
Report No. 9057

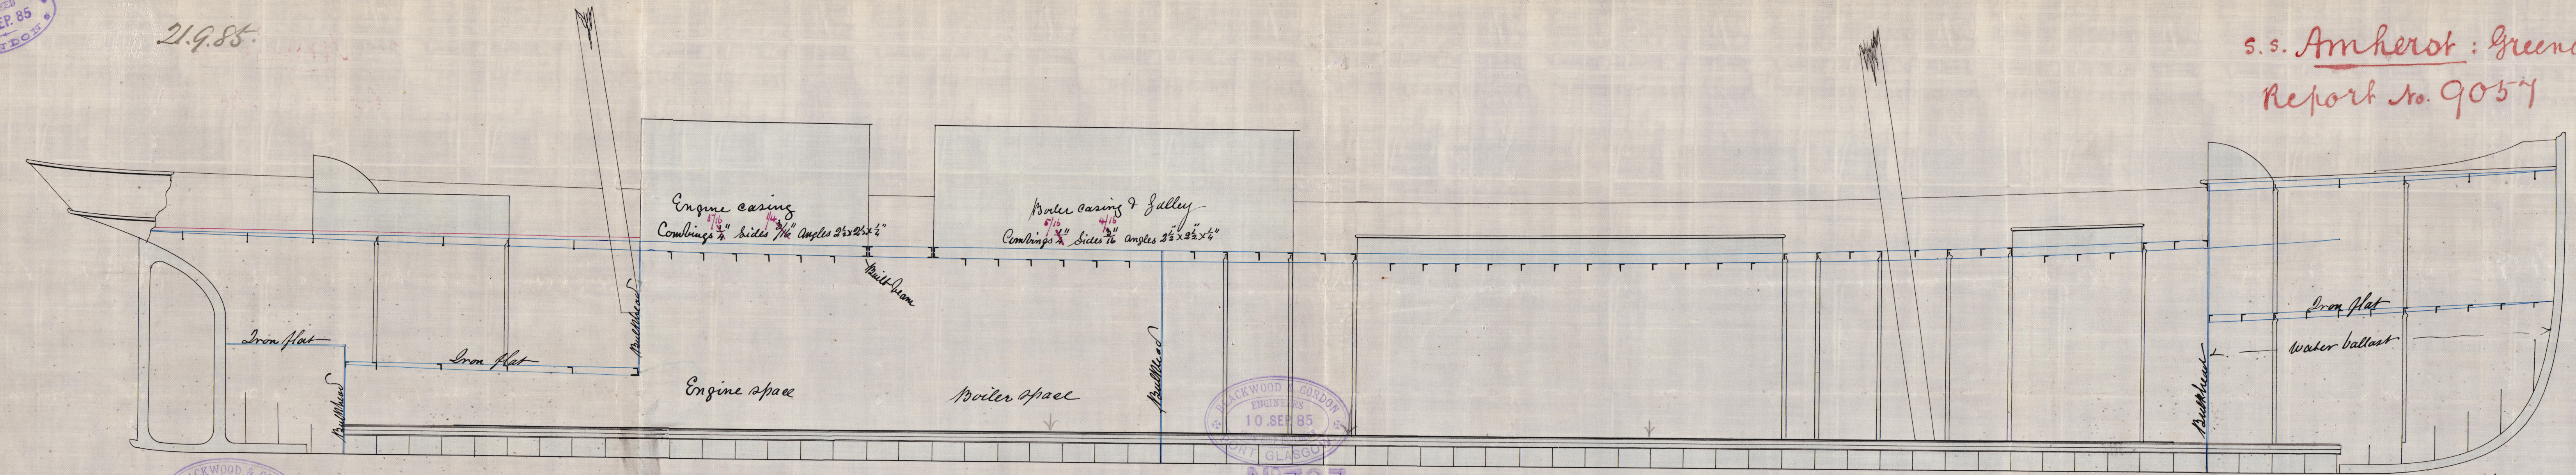


BLACKWOOD & GORDON
ENGINEERS
10 SEP 85
PORT GLASGOW

N^o 737

Longitudinal Elevation and deck Plan of N^o 206. S.S.
Length Rail & Forecastle — 129' 6"
Breadth of Beam — 25' 0"
Depth of Hold — 10' 0"
Tonnage Gross about — 250 tons
Class 100 A1

BLACKWOOD & GORDON
ENGINEERS
10 SEP 85
PORT GLASGOW

Tracing
N^o 737

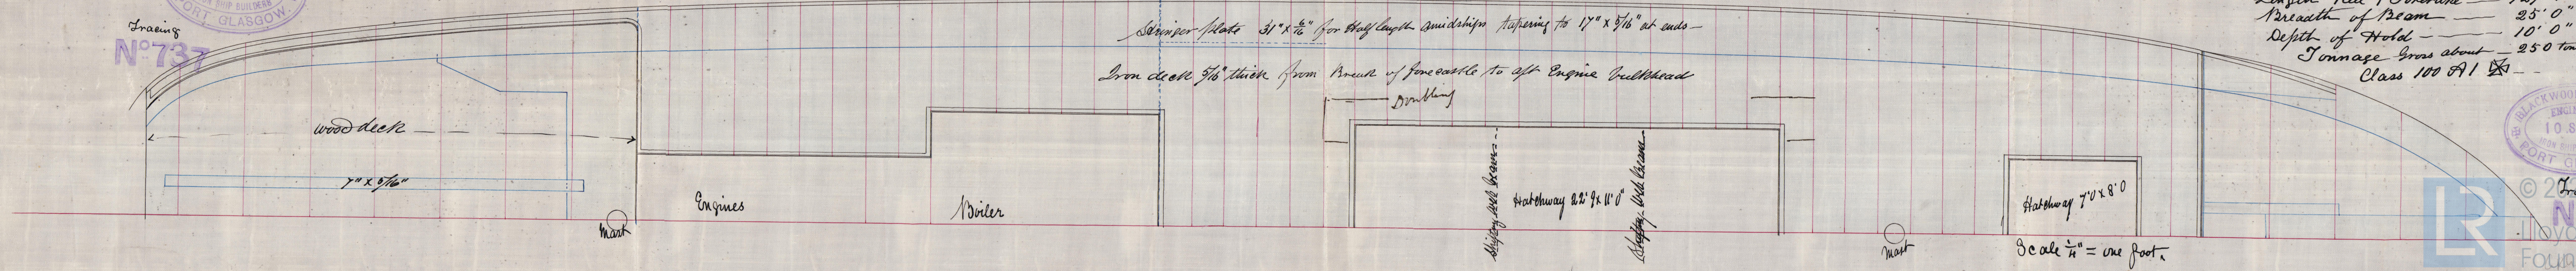

BLACKWOOD & GORDON
ENGINEERS
10 SEP 85
PORT GLASGOW

Tracing
N^o 737

Scale 1/4" = one foot.

© 2021
Lloyd's Register
Foundation