

Lloyd's Register of British and Foreign Shipping.

(Report on Vessel No. _____ Port _____)

No. 1118.

SHIP FORGINGS OR CASTINGS.

may be required.

I have to report that the undermentioned Iron or ~~Steel~~ Forgings or Castings, manufactured by The Lancefield Forge Co of Glasgow, for the Vessel No. 206, being built by Messrs Blackwood & Gordon of Port Glasgow, have been inspected by me as set forth below, and found to be, so far as can be seen, sound and efficient.

Mark on Forgings.


Lloyd's
No. 1118
G. N.

George Newcomb.
Glasgow.


9/12/85.

	STERN FRAME.	RUDDER FRAME.	STEM.
Material*	/	Scrap iron	/
How made		Forged	
Dimensions		3 3/4 & 2 1/4	
Progress on Inspection		Forging & smelting	
Days when Inspected		14.17.29/11/85. 2.4.7/12/85.	

SKETCHES OF FRAMES SHEWING POSITION AND DESCRIPTION OF WELDS OF FORGINGS, OR PARTICULARS OF TESTS APPLIED TO CASTINGS.

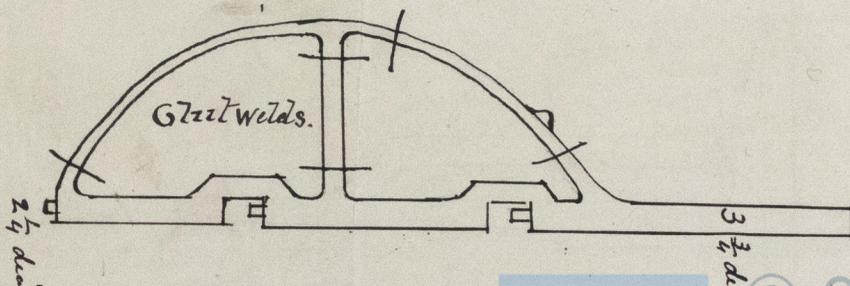

* If of Iron, state whether scrap or puddled iron.

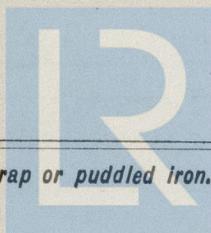

© 2019

Lloyd's Register
Foundation

GRH305-0165