

Lloyd's Register of British and Foreign Shipping.

(Report on Vessel No. _____ Port _____)

No. 315. a

SHIP FORGINGS OR CASTINGS.

I have to report that the undermentioned Iron or Steel Forgings or Castings, manufactured by

Messrs G H Reed & Co. Limited of Sunderland.

for the Vessel No. *144*, being built by *Messrs Russell & Co.*

of *Greenock* have been inspected by me as set forth below, and found to be, so far as can be seen, *sound.*

Mark on Forgings.

Lloyd's

No. 315. a


G.H.C.

Hugh Cameron.

Sunderland.

	STERN FRAME. Port	RUDDER FRAME.	STEM.
Material* - - - -	<i>Scrap iron</i>	<i>scrap iron</i>	<i>Scrap iron</i>
How made - - - -	<i>Forged</i>	<i>Forged</i>	<i>Forged</i>
Dimensions - - - -	<i>8" x 2 1/2"</i>	<i>5 1/2" - 3"</i>	<i>8" x 2 1/2"</i>
Progress on Inspection -	<i>Forged & smithed</i>	<i>Forged & smithed</i>	<i>Forged</i>
Dates when Inspected	<i>June 3. 9. 10. 15. 17. 20. 25/85</i>	<i>June 17. 20. 25. 30/85</i>	<i>June 17/85</i>

SKETCHES OF FRAMES SHEWING POSITION AND DESCRIPTION OF WELDS OF FORGINGS, OR PARTICULARS OF TESTS APPLIED TO CASTINGS.

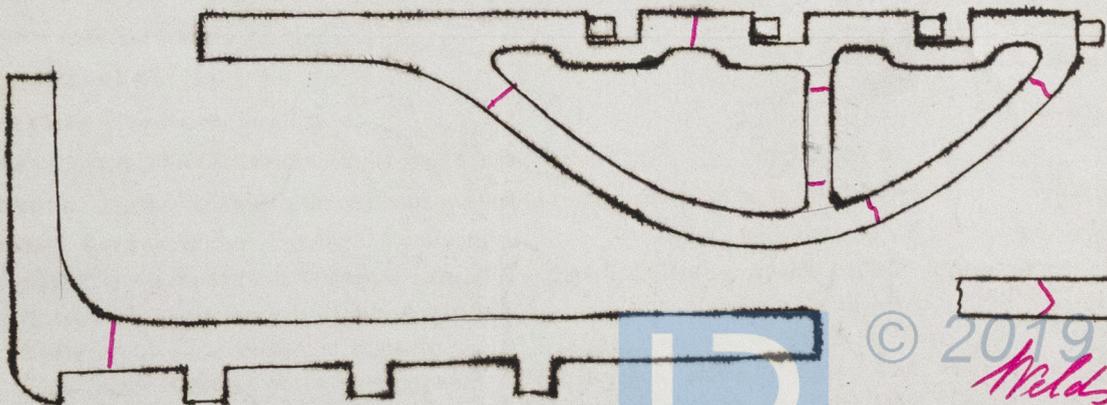

© 2019
Welds

Lloyd's Register
Foundation

* If of Iron, state whether scrap or puddled Iron.