

# Lloyd's Register of British and Foreign Shipping.

(Report on Vessel No. \_\_\_\_\_ Port \_\_\_\_\_)

No. 316.2

## SHIP FORGINGS OR CASTINGS.

I have to report that the undermentioned Iron or Steel Forgings or Castings, manufactured by

*Messrs C H Reid & Co Ltd of Sunderland*

for the Vessel No. *145*, being built by *Messrs Russell & Co.*

of *Greenock* have been inspected by me as set forth below, and found to be, so far as can be seen, *sound.*


Work on Forgings.

Lloyd's  
No. 316.2  
26.6

*Hugh Cameron*  
*Sunderland.*

	STERN FRAME. <i>Port</i>	RUDDER FRAME.	STEM.
Material*	<i>Scrap iron</i>	<i>Scrap iron</i>	<i>Scrap iron</i>
Made	<i>Forged</i>	<i>Forged</i>	<i>Forged</i>
Dimensions	<i>8" x 2 1/2"</i>	<i>5 1/2" - 3"</i>	<i>8" x 2 1/2"</i>
Process on Inspection	<i>Forged Smithed</i>	<i>Forged Smithed</i>	<i>Forged</i>
When Inspected	<i>June 3-9-10-15-17-20-25/85</i>	<i>June 17-20-25 July 16-21-24-30/85</i>	<i>June 17/85</i>

ETCHES OF FRAMES SHEWING POSITION AND DESCRIPTION OF WELDS OF FORGINGS, OR PARTICULARS OF TESTS APPLIED TO CASTINGS.

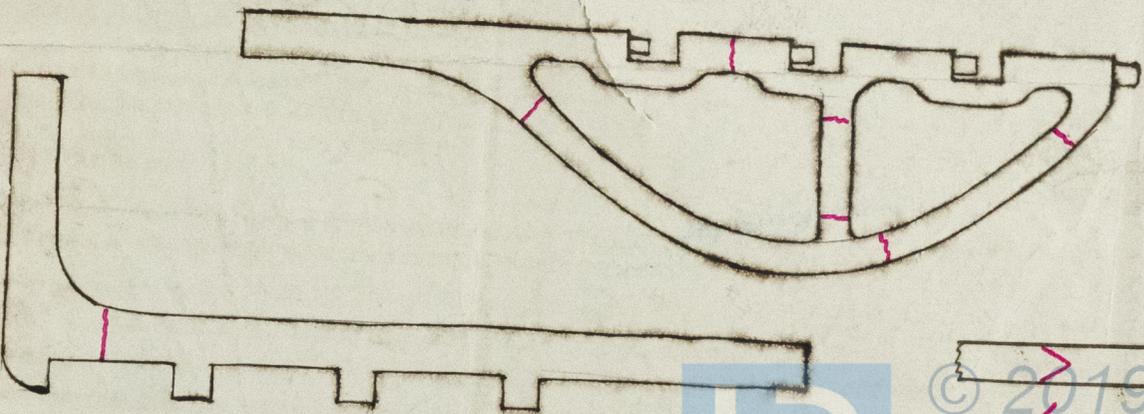

© 2019  
*Mills*  
Lloyd's Register  
Foundation

\* If of Iron, state whether scrap or puddled Iron.

*GRW 305*