



13.3.85.


ship Bothwell: Greenock Report No. 9110

WILLIAM HAMILTON & CO
Shipbuilders
PORT GLASGOW.


5th March 1885

W.H.


Mizzen Upper Topsail Yard.

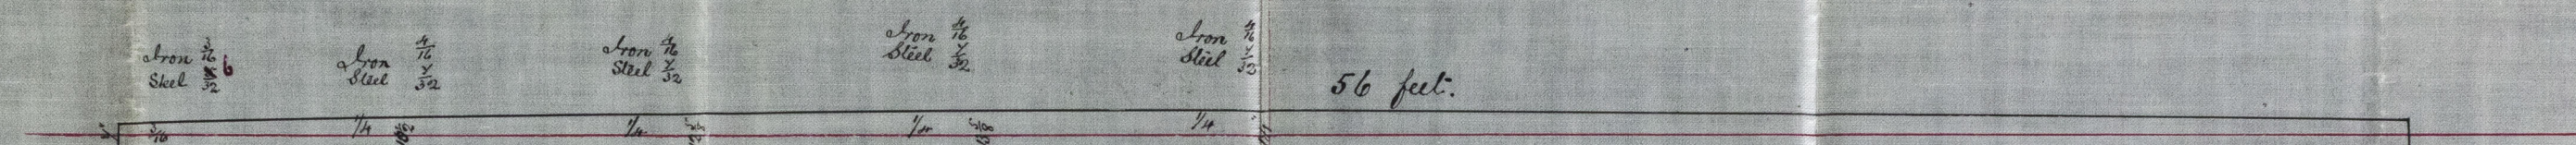


Mizzen Lower Topsail Yard.

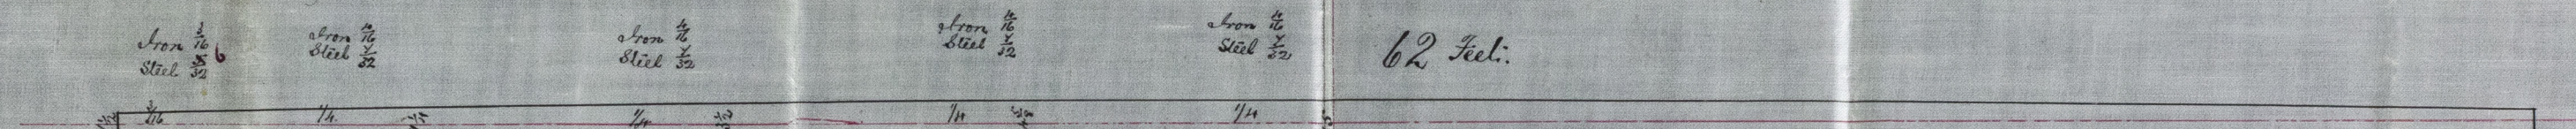


Mizzen Lower Yard.

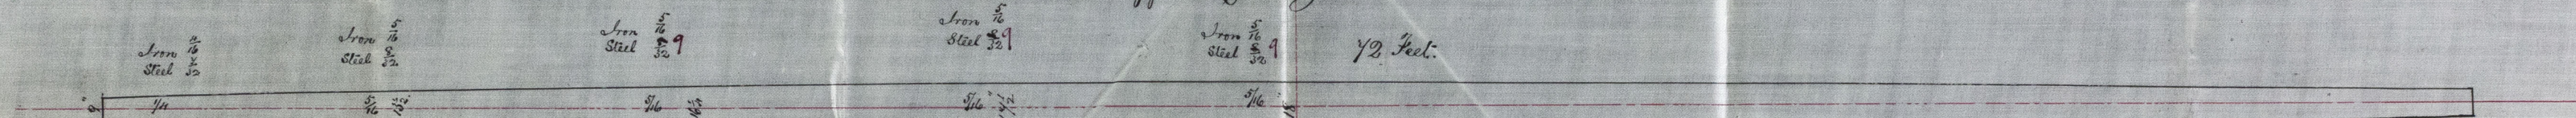


Fore & Main Upper Topsail Yard.

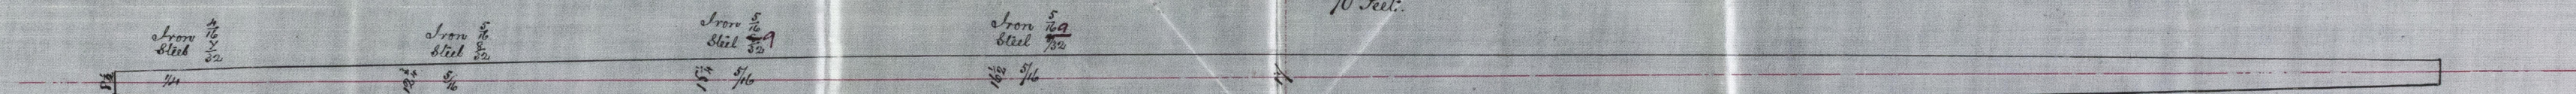

Fore & Main Lower Topsail Yard.

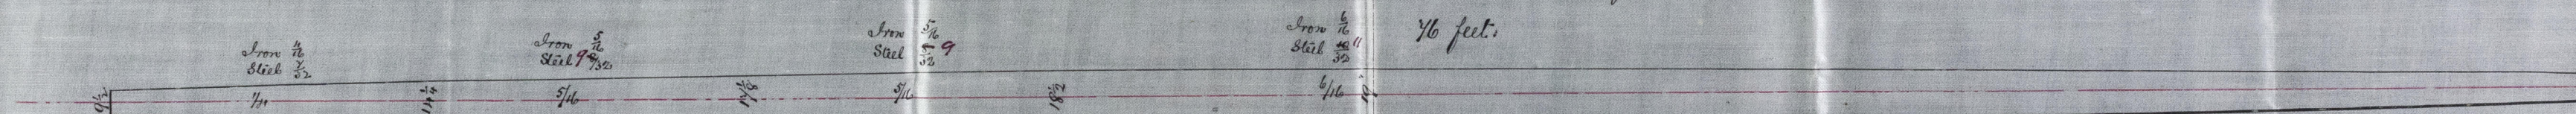

Fore & Main Lower Yard.

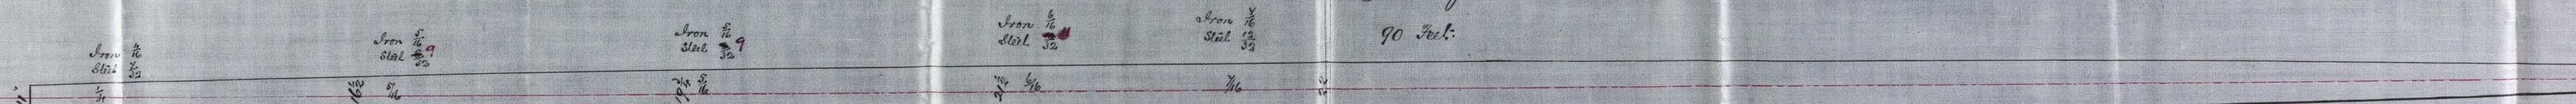

Doubling plates to all yards 8'0" long.

Scale $\frac{1}{2}$ Inch = one Foot

No 63

© 2019

Lloyd's Register
Foundation

Delivered
13/3/85