




Ship Boswell:

Greenock Report No. 9110

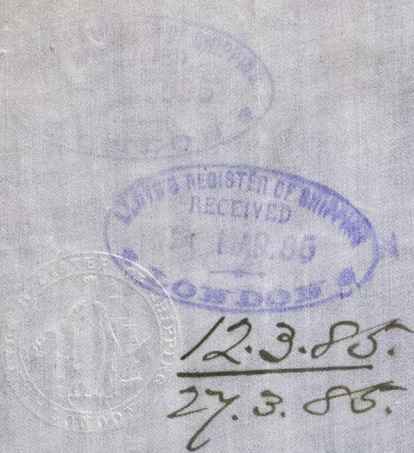

Proposed Side Stringers
in steel.

"Steel Ship" No 63

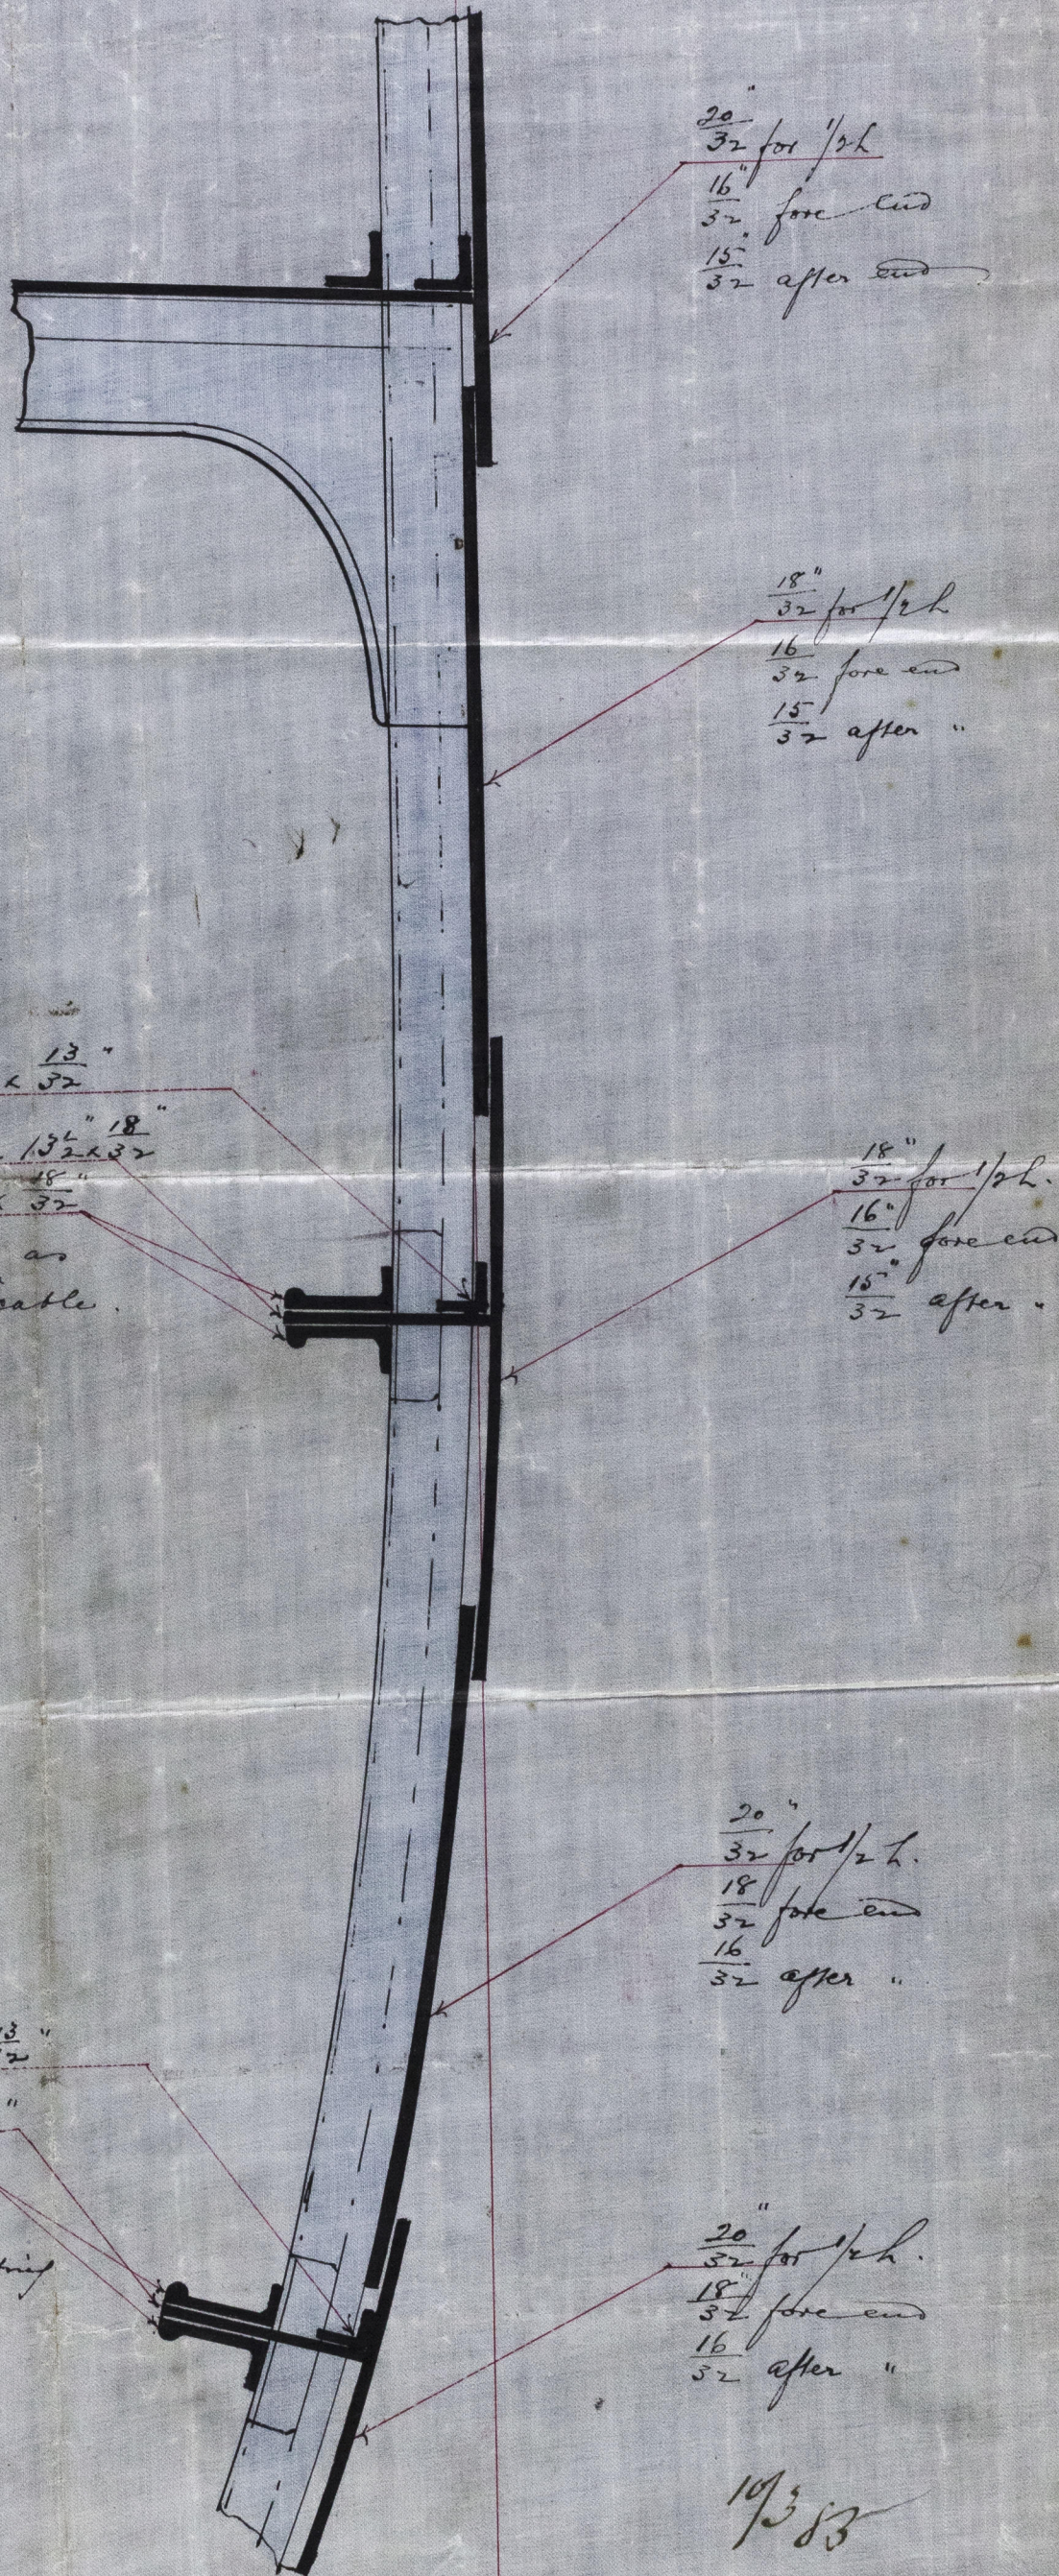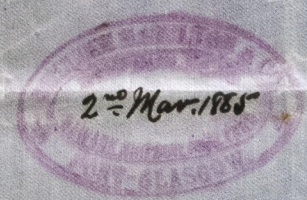

Scale 1" = 1 foot

12/3/85



© 2019
Lloyd's Register
Foundation