

# Lloyd's Register of British and Foreign Shipping.

(Report on Vessel No. \_\_\_\_\_ Port \_\_\_\_\_)

No. 1038

## SHIP FORGINGS OR CASTINGS.

may be required.

I have to report that the undermentioned Iron or ~~Steel~~ Forgings or Castings, manufactured by Messrs J & W. Beardmore of Glasgow for the Vessel No. 63, being built by Messrs W. Hamilton & Co of Port Glasgow have been inspected by me as set forth below, and found to be, so far as can be seen, sound and efficient

Mark on Forgings.


George Newcomb  
Glasgow

30/5/85.

Lloyd's  
No. 1038  
G.N.

	STERN FRAME.	RUDDER FRAME.	STEM.
Material*	/	Scrap iron	/
How made		Forged	
Dimensions		6 3/4 and 3 1/2	
Progress on Inspection		Smithing & completed	
Dates when Inspected		15. 24. 30/4/85. 6. 13. 20. 28/5/85.	

SKETCHES OF FRAMES SHEWING POSITION AND DESCRIPTION OF WELDS OF FORGINGS, OR PARTICULARS OF TESTS APPLIED TO CASTINGS.

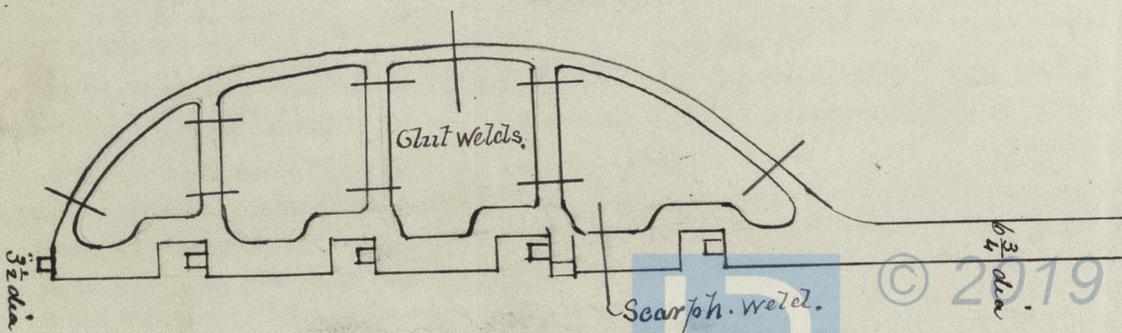

\* If of Iron, state whether scrap or puddled Iron.