29 Oct/85.

S. S. Isabella: Greenock Report No. 9113

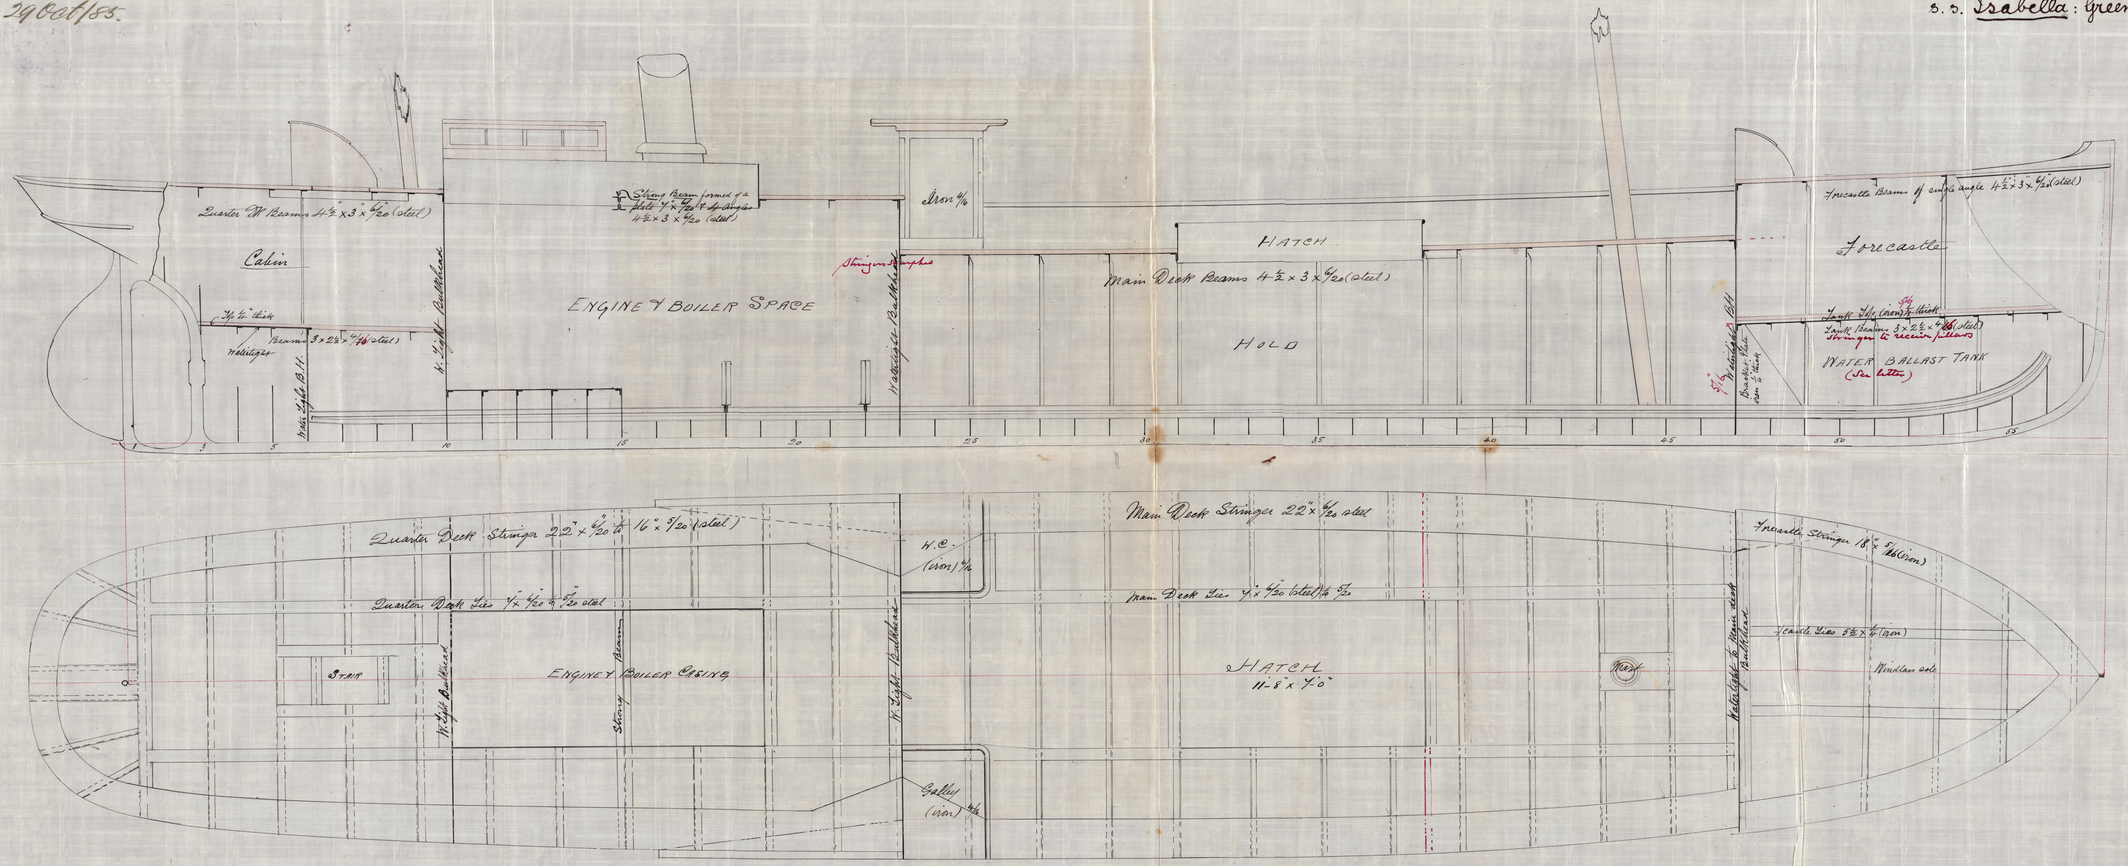

Longitudinal Section & D.K. Plan of

Steel S.S. No 24

To Class 100 A1 @ Lloyds

Dim.s 95.09 x 18.0 x 8.66

Scale 3/8 = one foot

Culzean Shipbg & Eng. Co.

27/10 85

© 2021 Lloyd's Register Foundation