


3/12/85.

3.3.86

10.3.86

Longitudinal Plan Steel Twin S.S. N^o 180
Scale $\frac{1}{8}$ Inch = One Foot

"Satellite": Greenock Report No. 9122

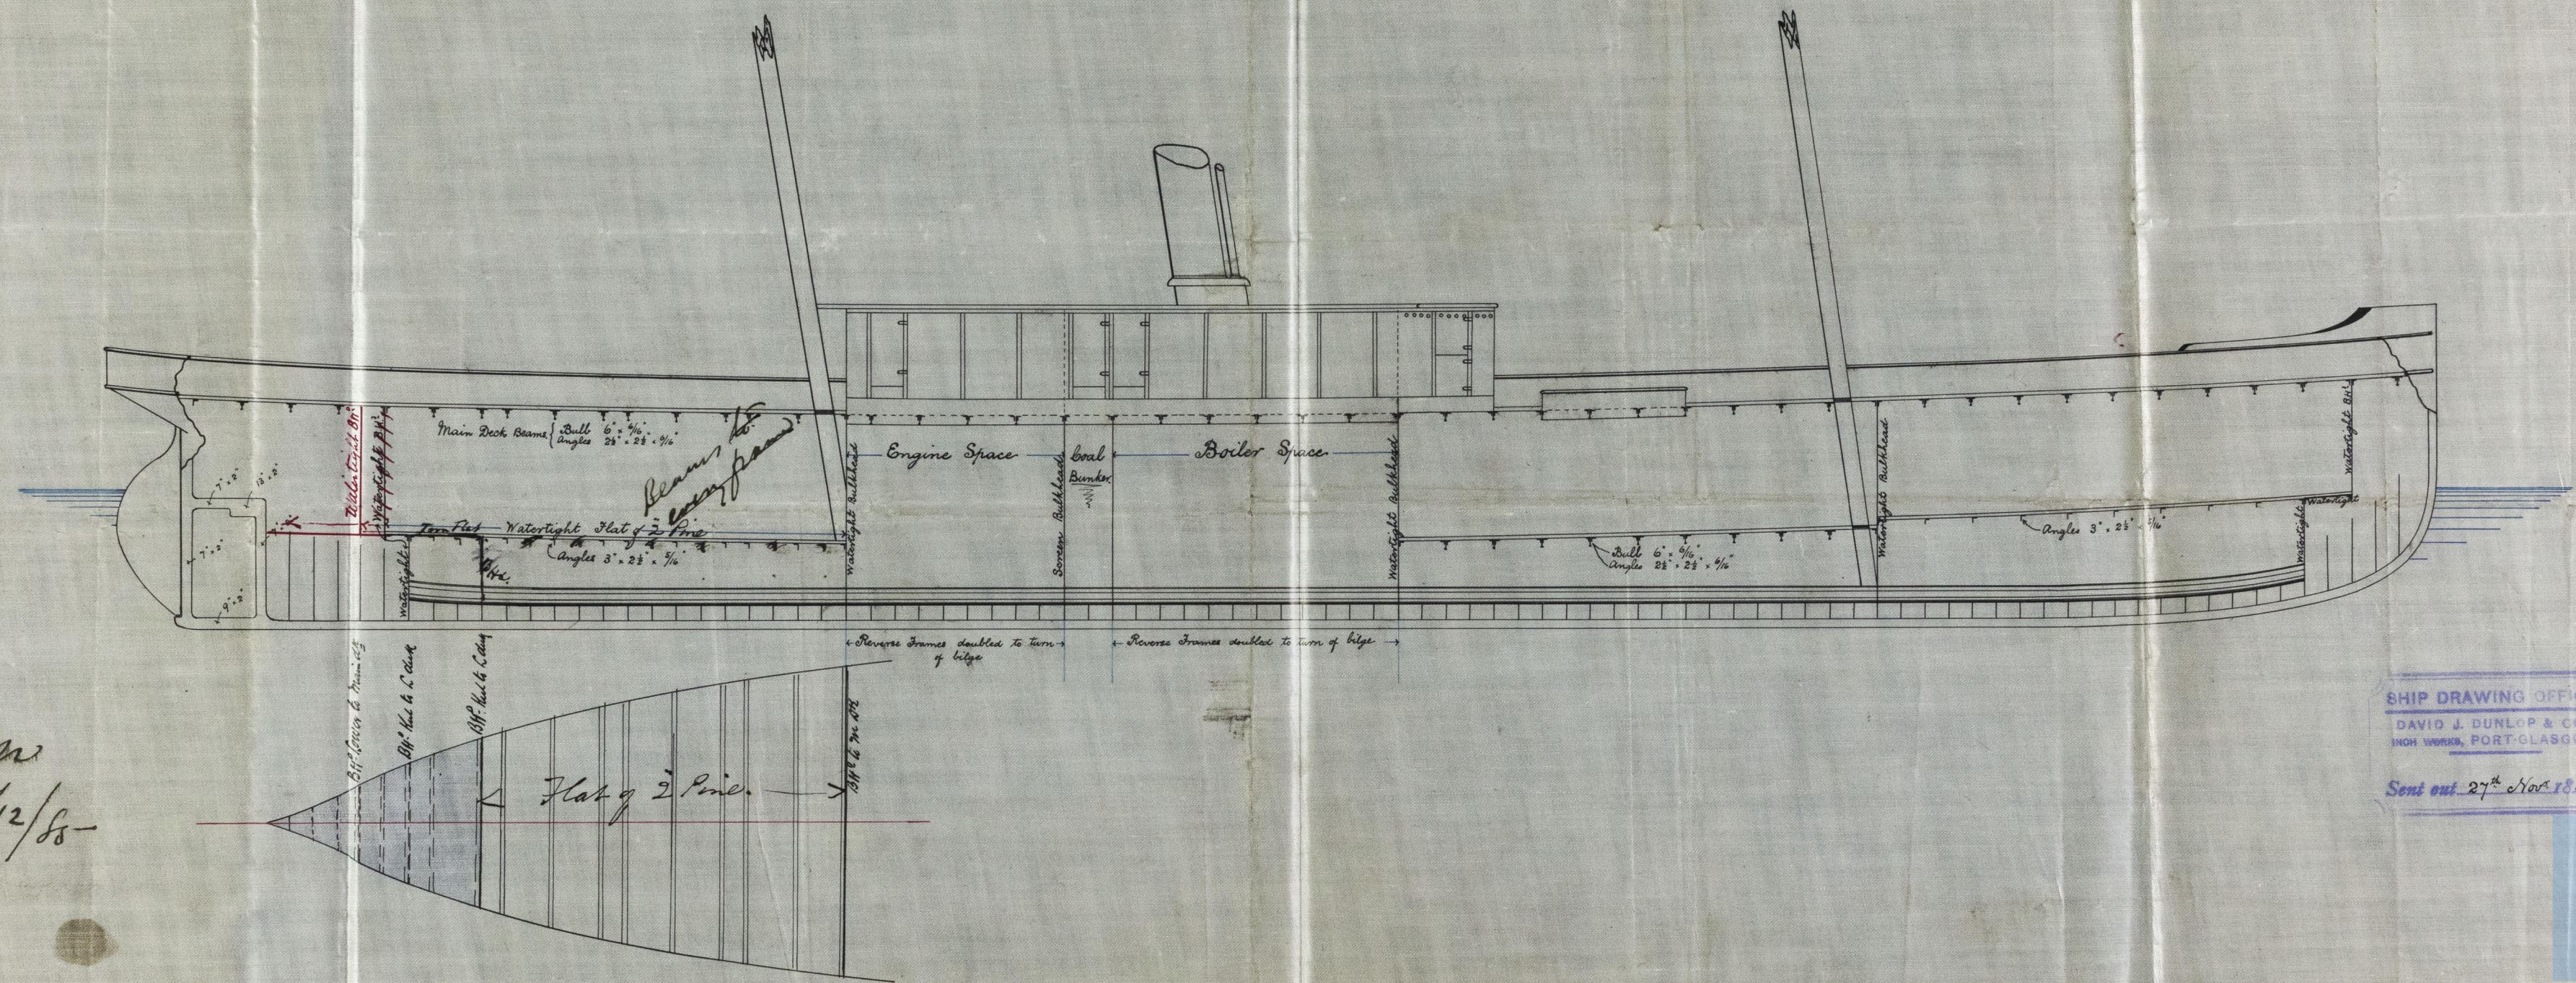

18m
2/12/85

SHIP DRAWING OFFICE
DAVID J. DUNLOP & CO.
IRON WORKS, PORT-GLASGOW.
Sent out 27th Nov 85