



LAST MONTHS OF WORKING
 12 DEC. 85
 LONDON


Atk to Gmk: 12/12/85

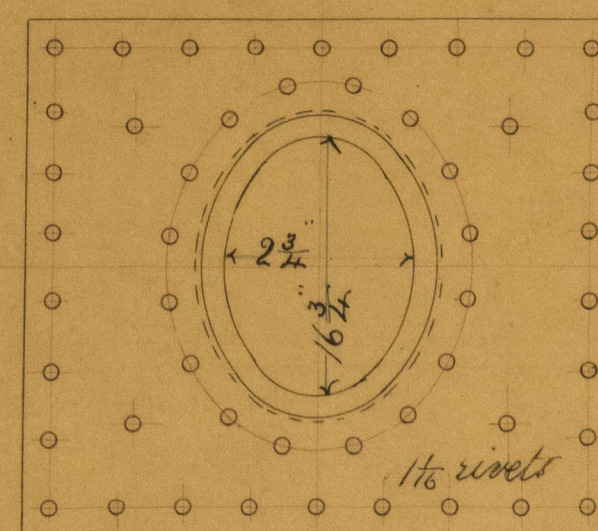

Plan of Manhole

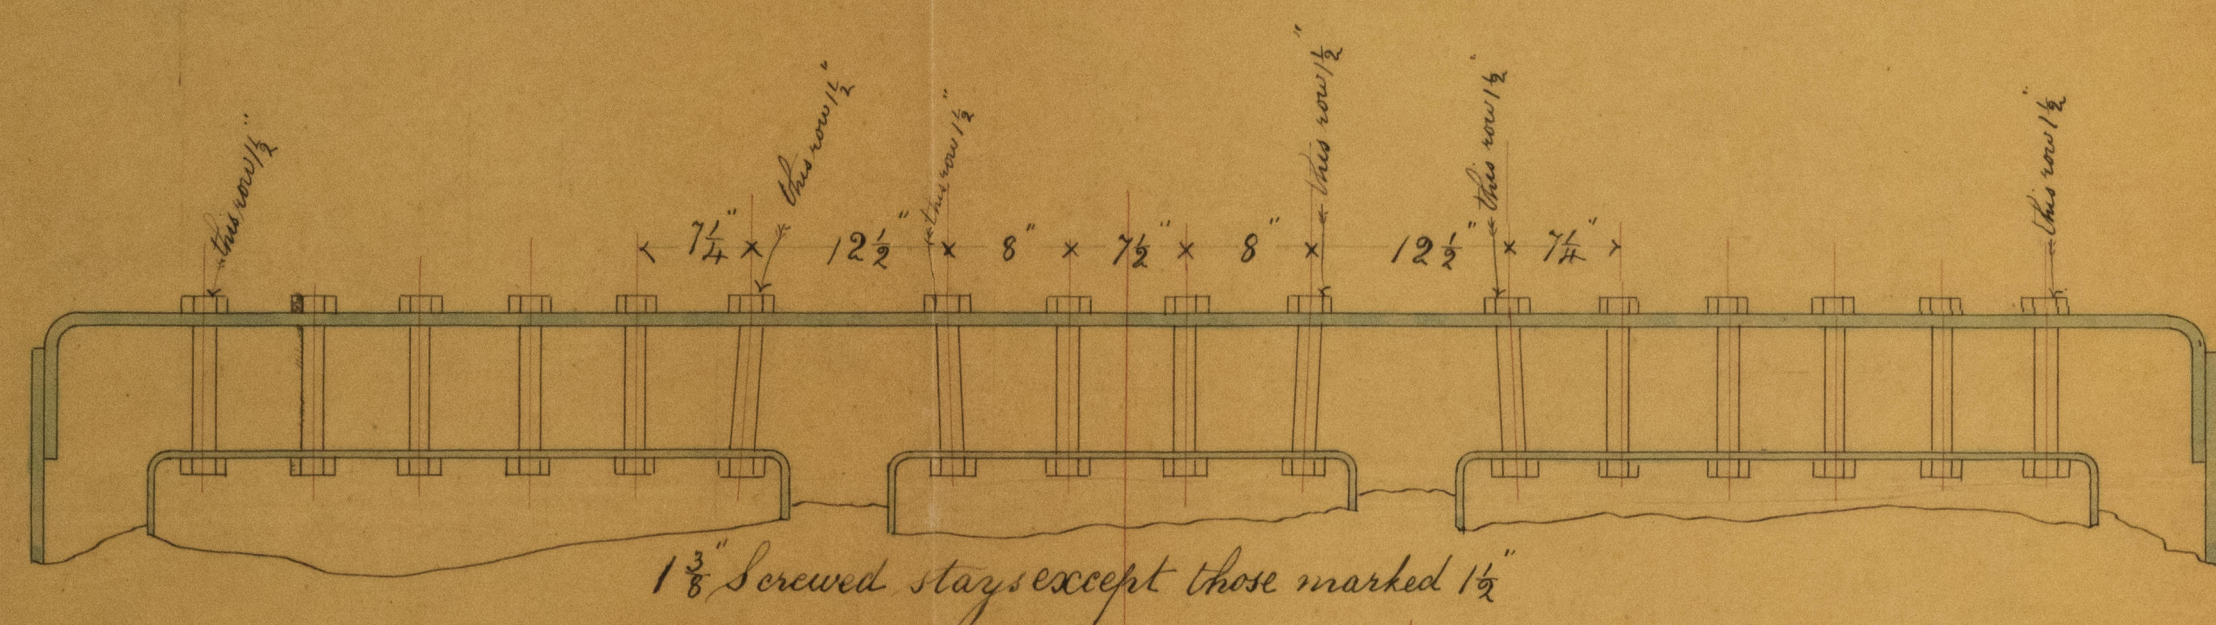


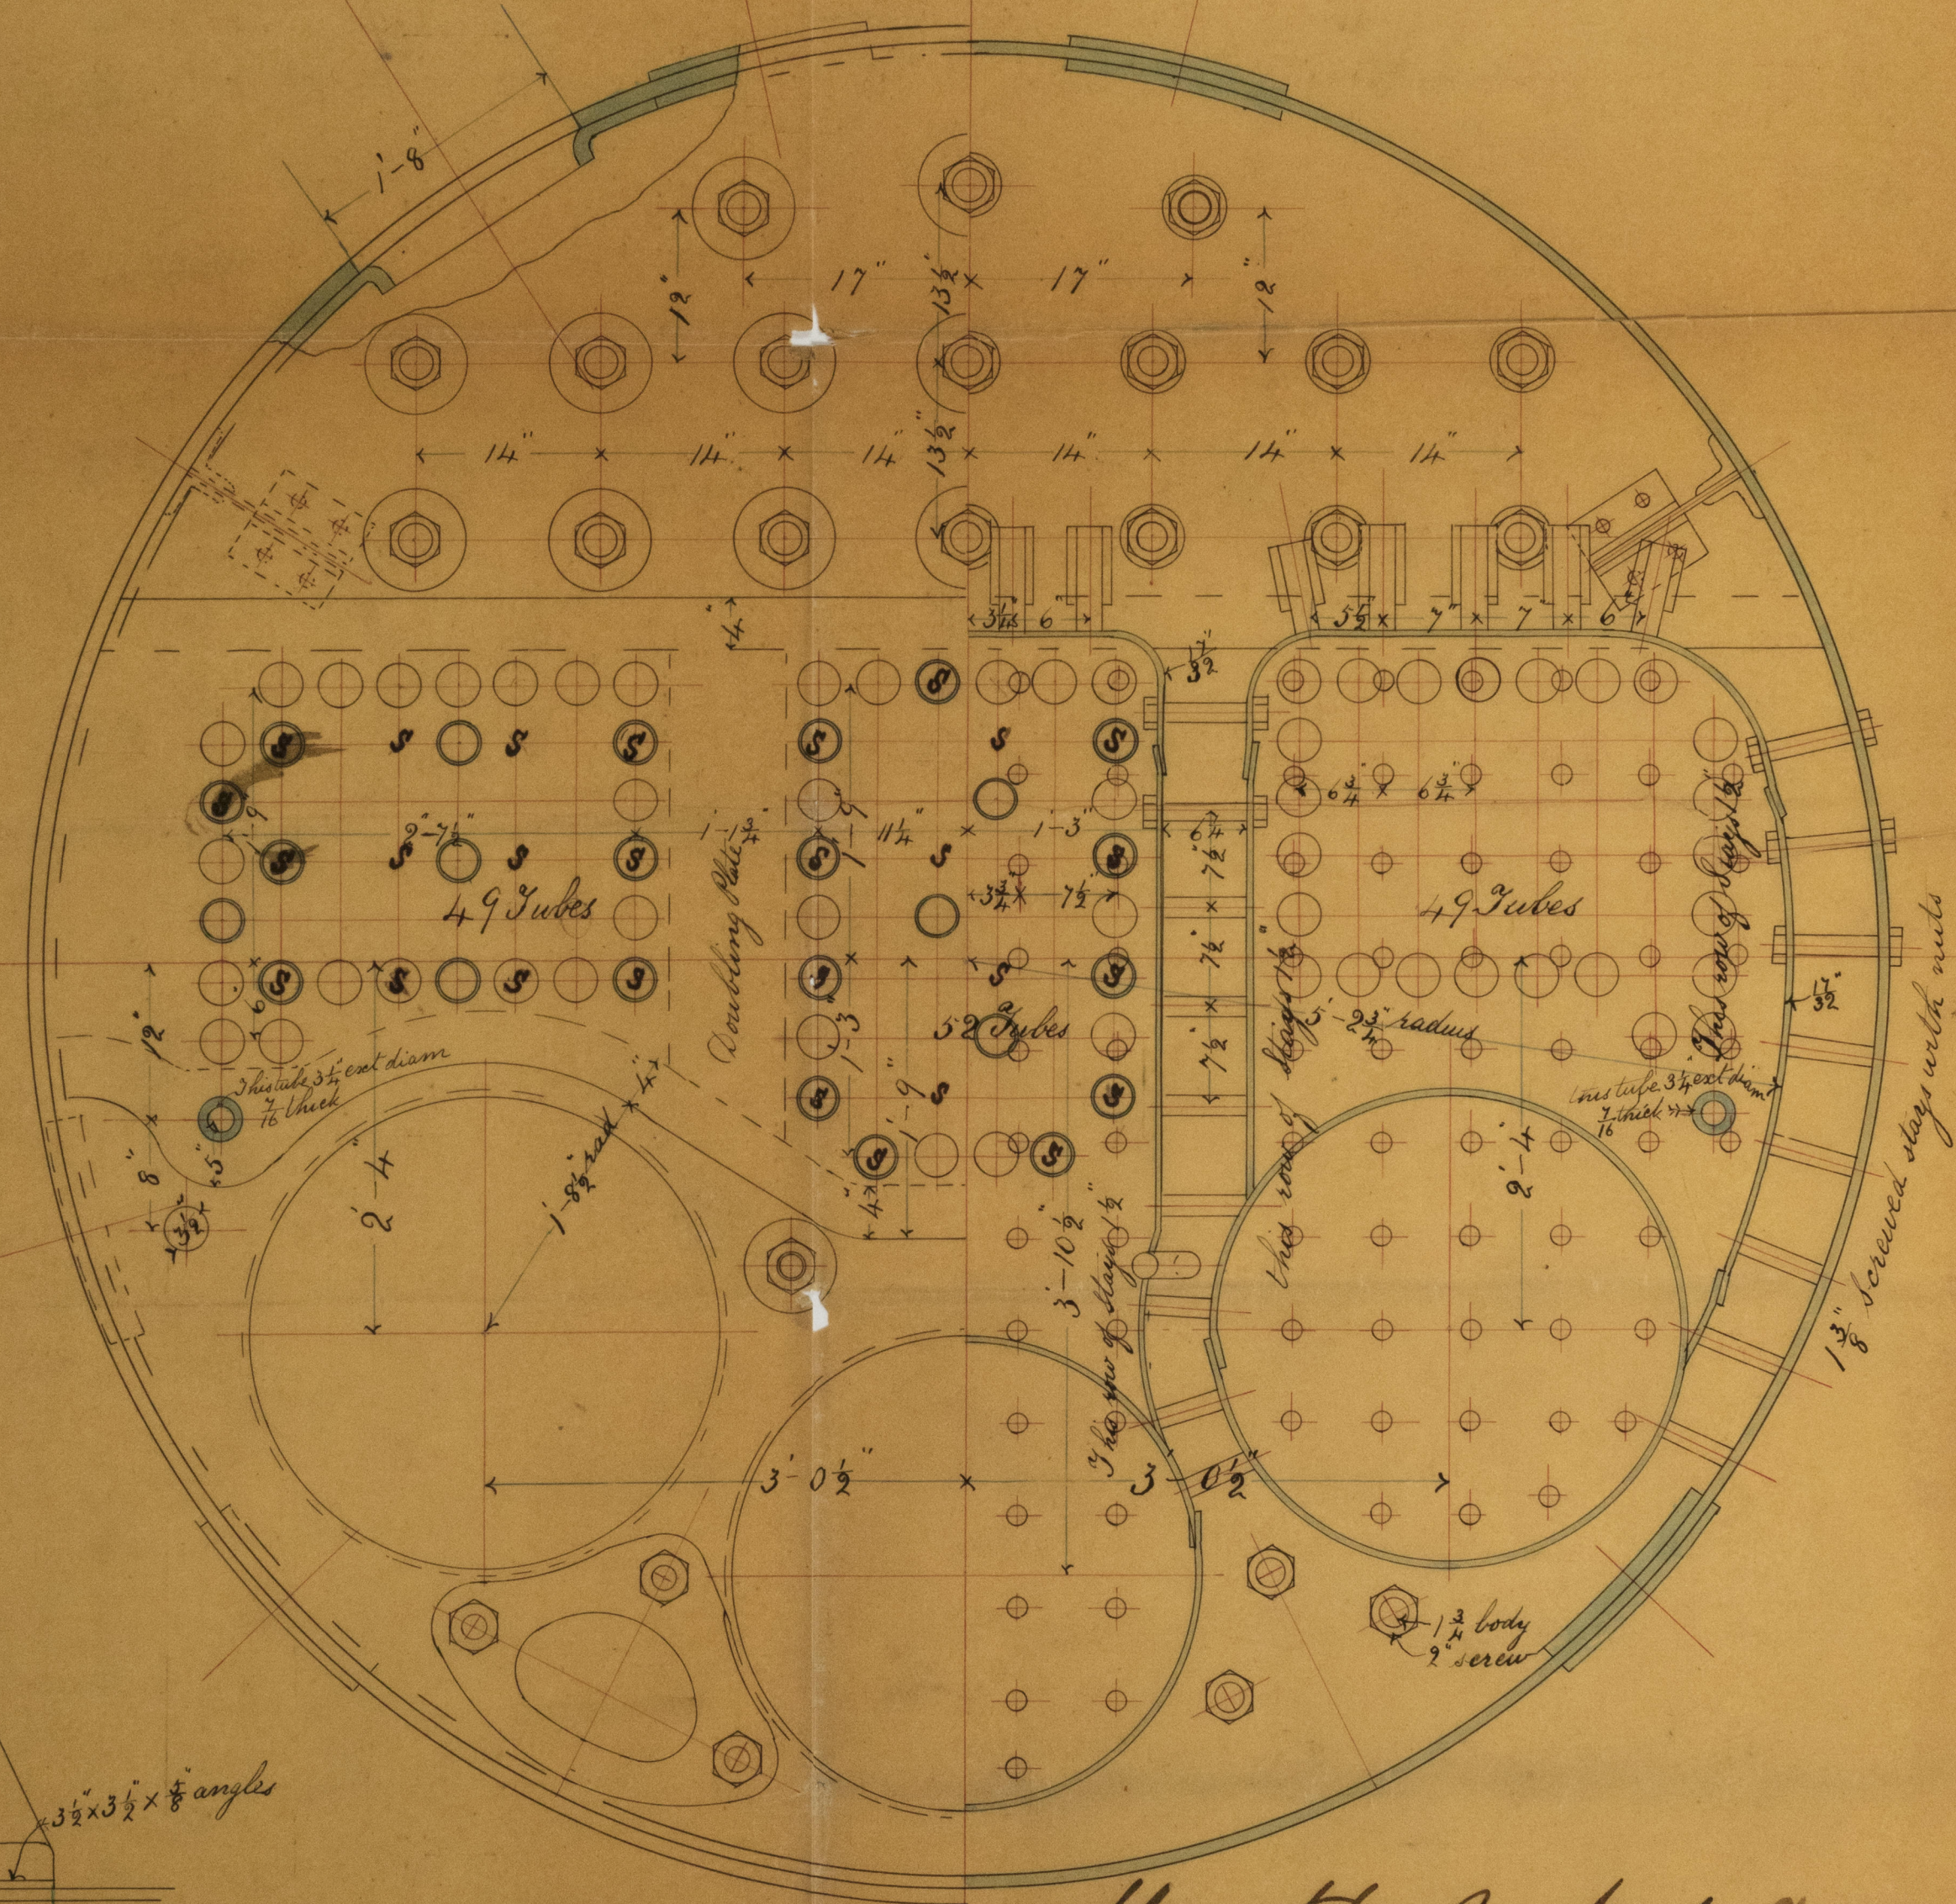


Stay tubes marked S

Nº 180

Boiler
 Scale 1 inch to the foot
 Steel throughout
 Stay tubes 1/2" thick
 Do. outside rows 3/8" thick
 to be screwed into both tube plates & beaded over
 Plane tubes Nº 9 W. G.

DAVID J. DUNLOP & CO
 ENGINEERS & SHIPBUILDERS
 PORT GLASGOW.


Working Pressure 150 lbs

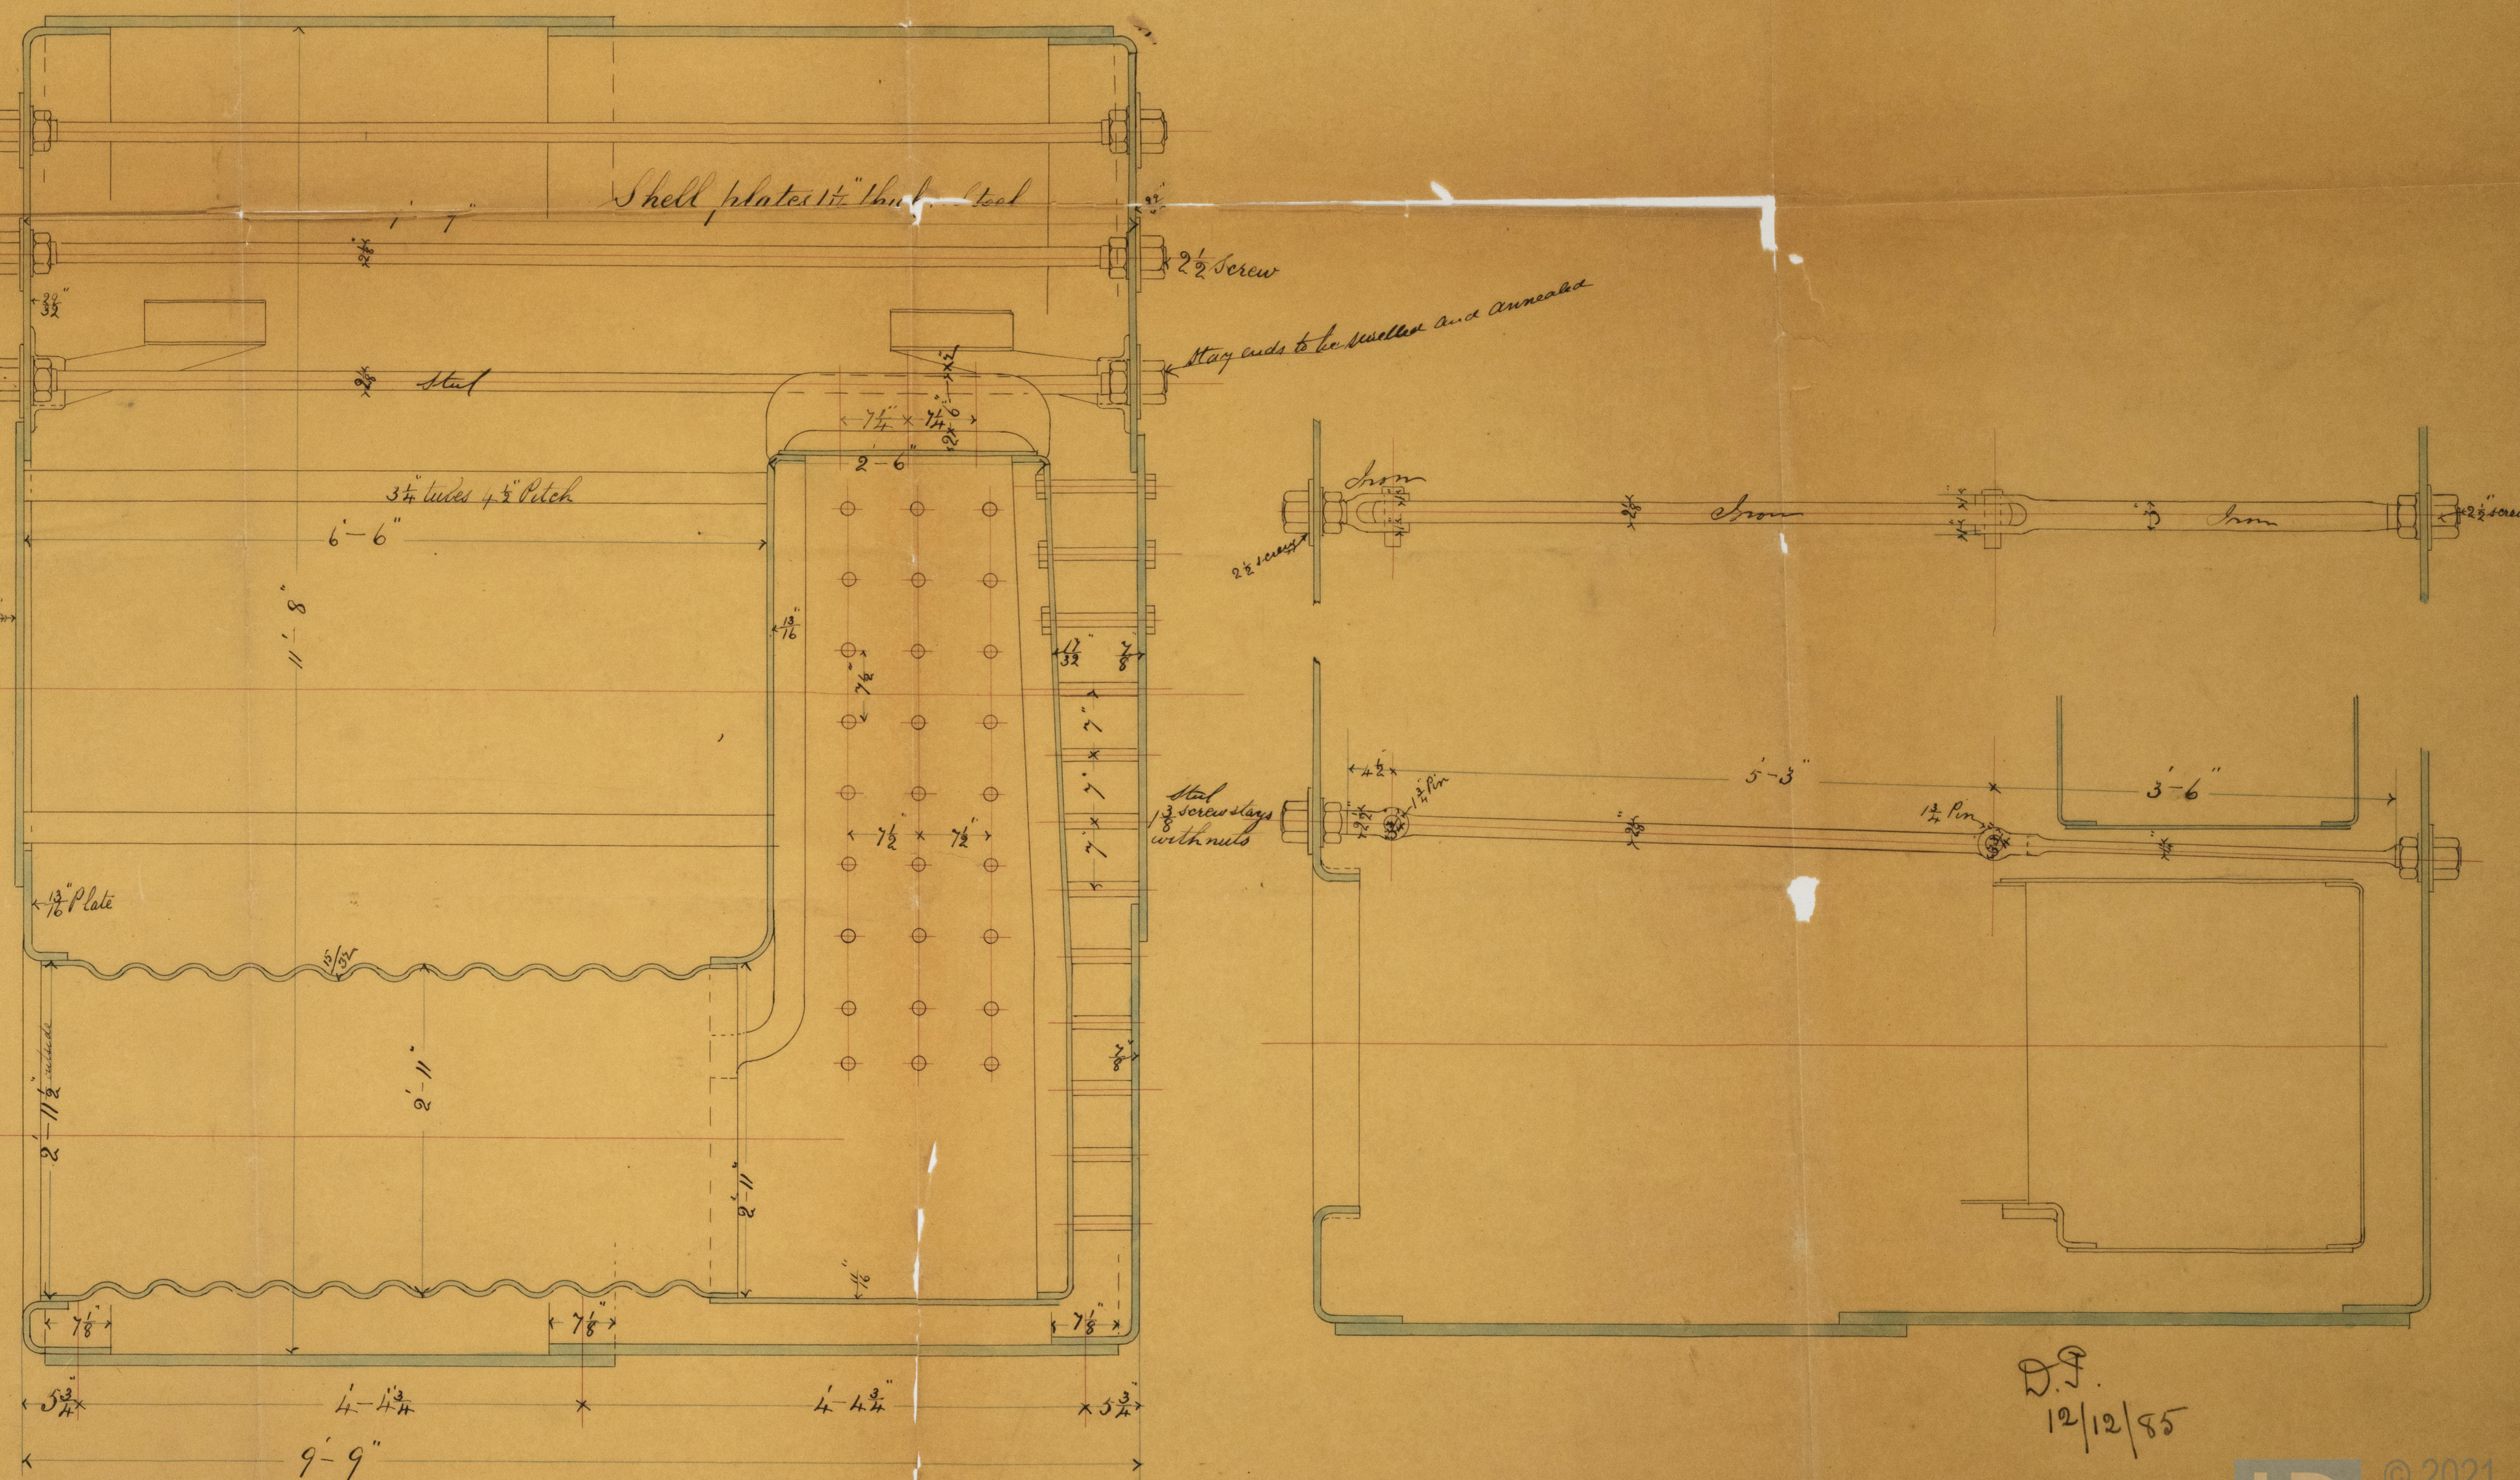

Exam'd 11/12/85
 A.C.B.

Twin s.s. "Satellite": Greenock Report No. 9122

Twin s.s. "Satellite":
 Greenock Report No. 9122

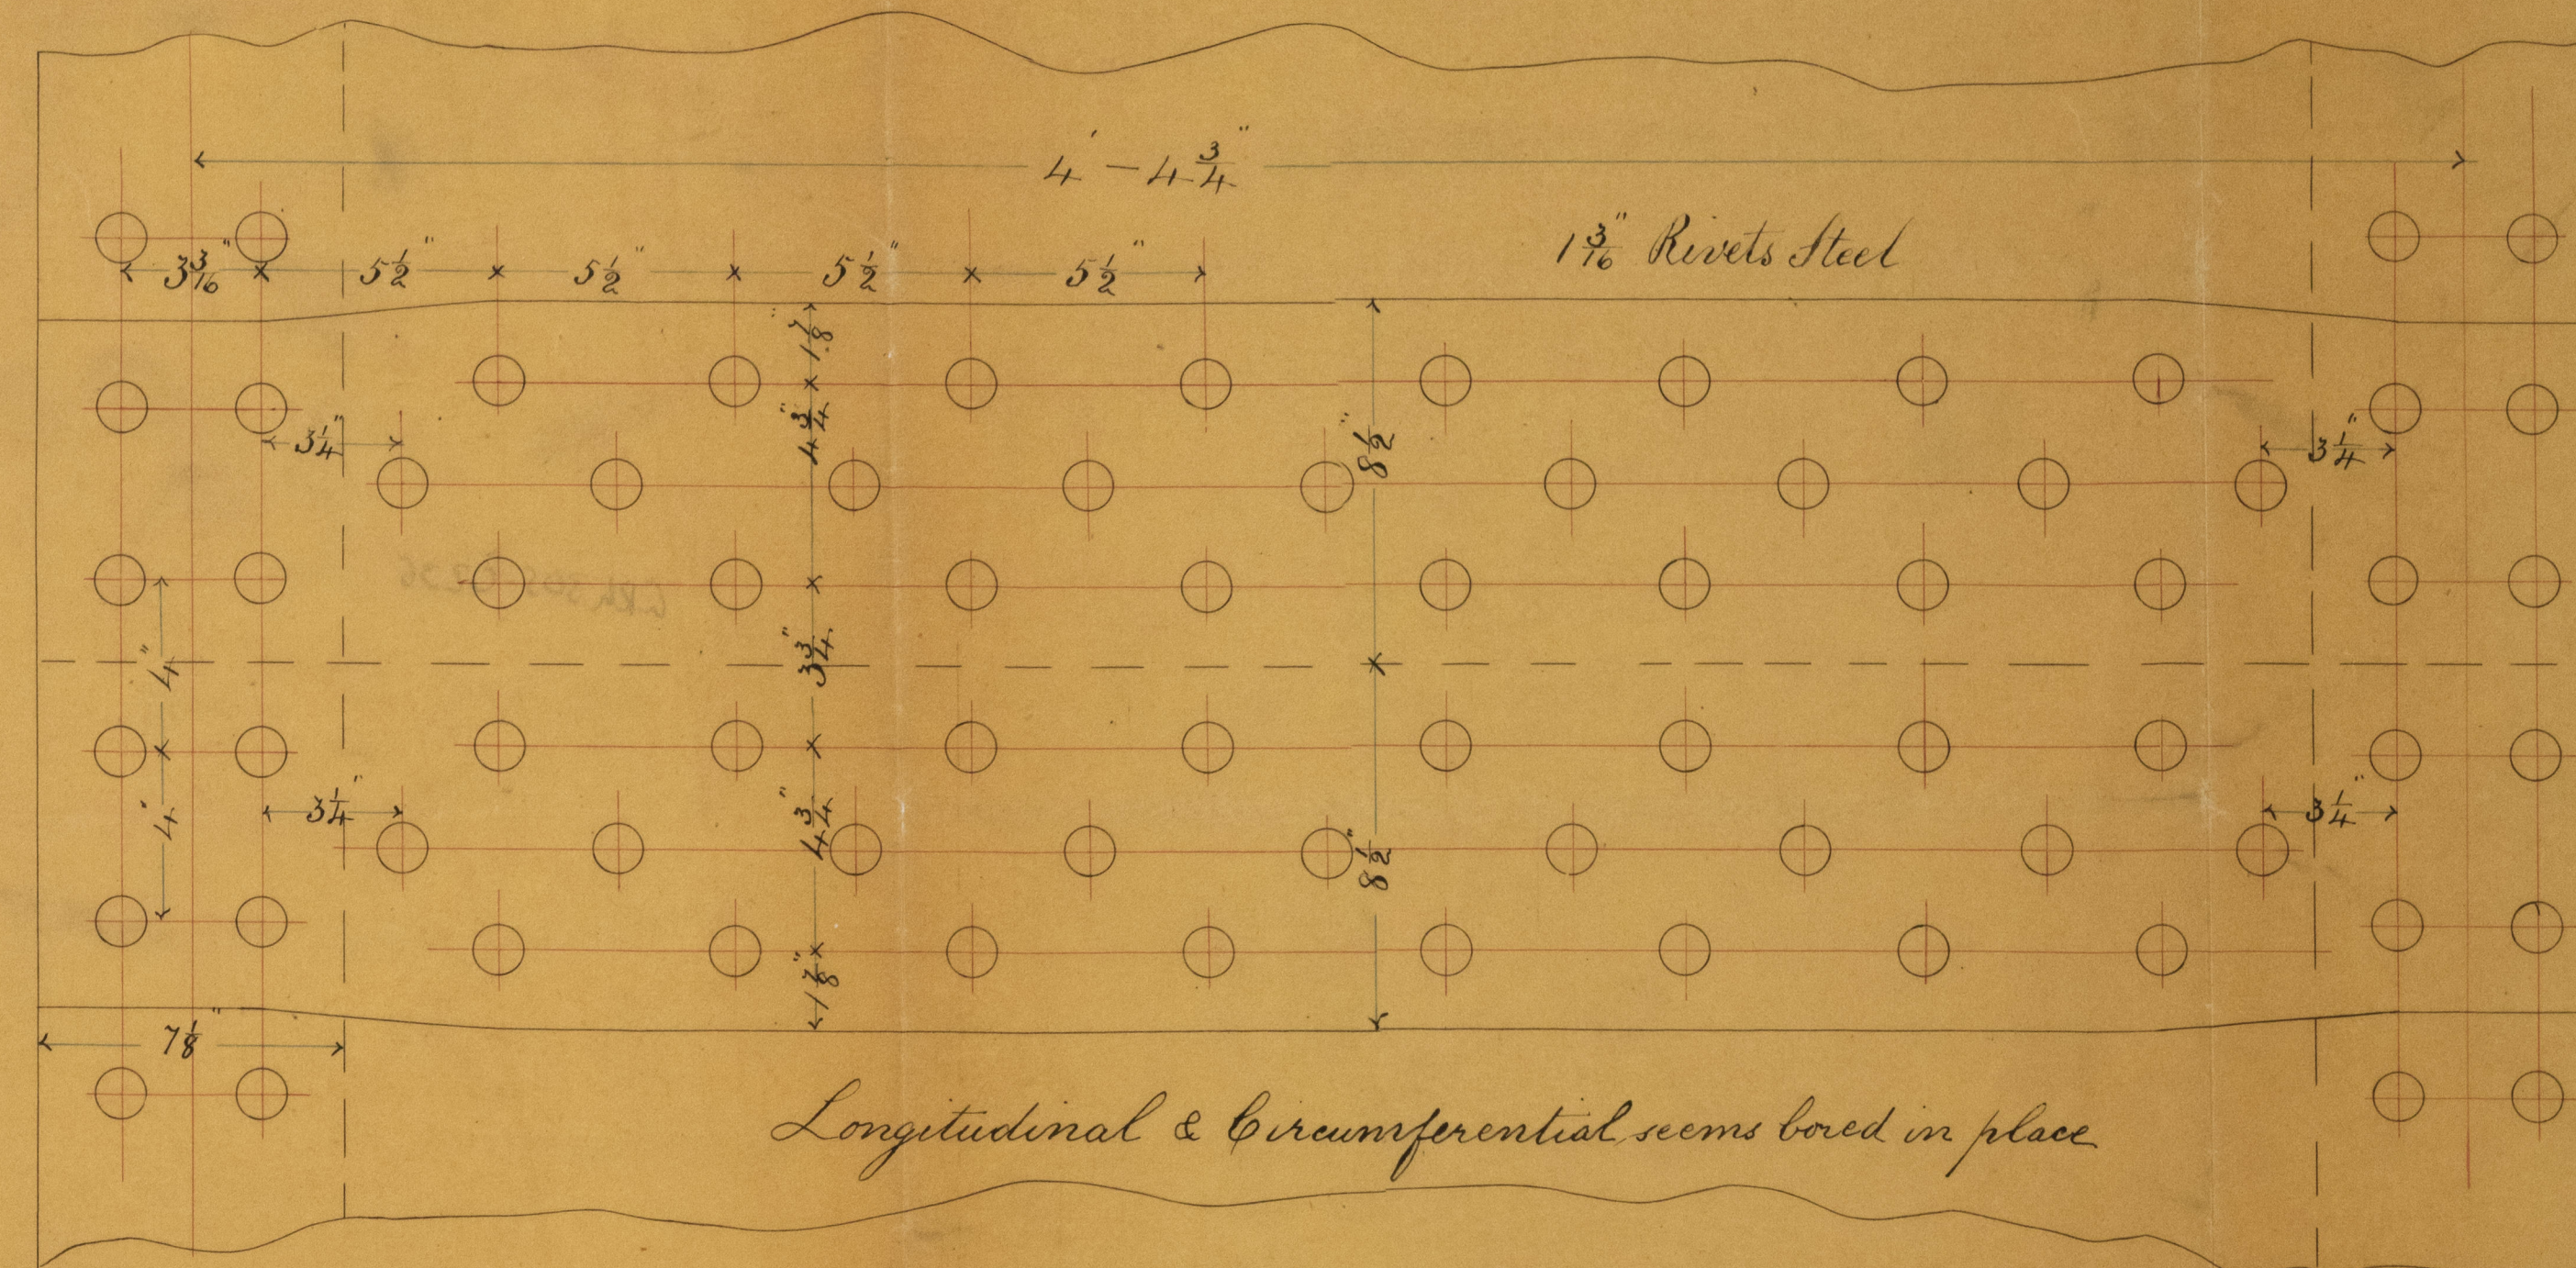

Longitudinal & Circumferential seams bored in place

D.J.
 12/12/85