

Lloyd's Register of British and Foreign Shipping.

(Report on Vessel No. _____ Port _____)

To. 390. a.

SHIP FORGINGS OR CASTINGS.

I have to report that the undermentioned Iron or ~~Steel~~ Forgings or Castings, manufactured by *Messrs W & A Reed Co* of *Sunderland* for the Vessel No. *180*, being built by *Messrs J & Dunlop & Co* of *Port Glasgow* have been inspected by me as set forth below, and found to be, so far as can be seen, *sound*.


on Forgings.

Lloyd's
No. 390. a.
16. 6.

Hugh Cameron,
Sunderland.

	STERN FRAME.	RUDDER FRAME.	STEM.
Material*	<i>Scrap Iron</i>	<i>Scrap Iron</i>	<i>Scrap Iron</i>
Made	<i>Forged</i>	<i>Forged</i>	<i>Forged</i>
Dimensions	<i>9" x 9"</i>	<i>4 1/2" - 2 1/2"</i>	<i>7" x 1 3/4"</i>
Process on Inspection	<i>Forged Smithed</i>	<i>Forged Smithed</i>	<i>Forged</i>
When Inspected	<i>July 7-8-11-14-18-20/86</i>	<i>July 12-15-20-23-25-27/86</i>	<i>Dec 19/85</i>

ETCHES OF FRAMES SHEWING POSITION AND DESCRIPTION OF WELDS OF FORGINGS, OR PARTICULARS OF TESTS APPLIED TO CASTINGS.

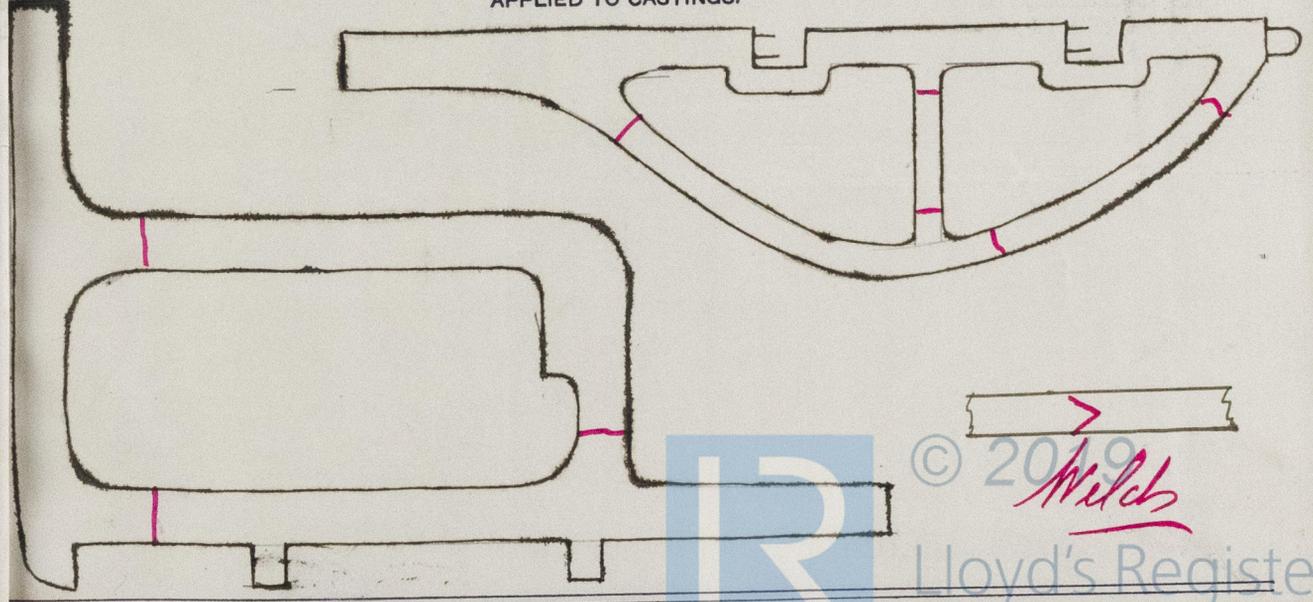

* If of Iron, state whether scrap or puddled Iron.

390

LRH3050244