

# s.s. 'Danube': Greenock Report No. 9159

11.2.86.



## Midship Section S.S. No. 181


To Class 100 A Lloyds  
"Steel"

Length 80 feet, Breadth 18 feet, Depth 9 feet 9"


Scale 1/2 inch = 1 foot

### Outfit of Anchors, Cables, &c.

- 2 Power Anchors 3 1/2 Cwt. ex stock
- 1 Stream --- 3/4 ---
- 1 Kedge --- 1/2 ---
- 120 Fathoms 1/6" Stud link cable
- 45 --- 8/16" Stream chain
- 75 --- 5 1/2" + 90 fathoms 3 Hawsers & warps

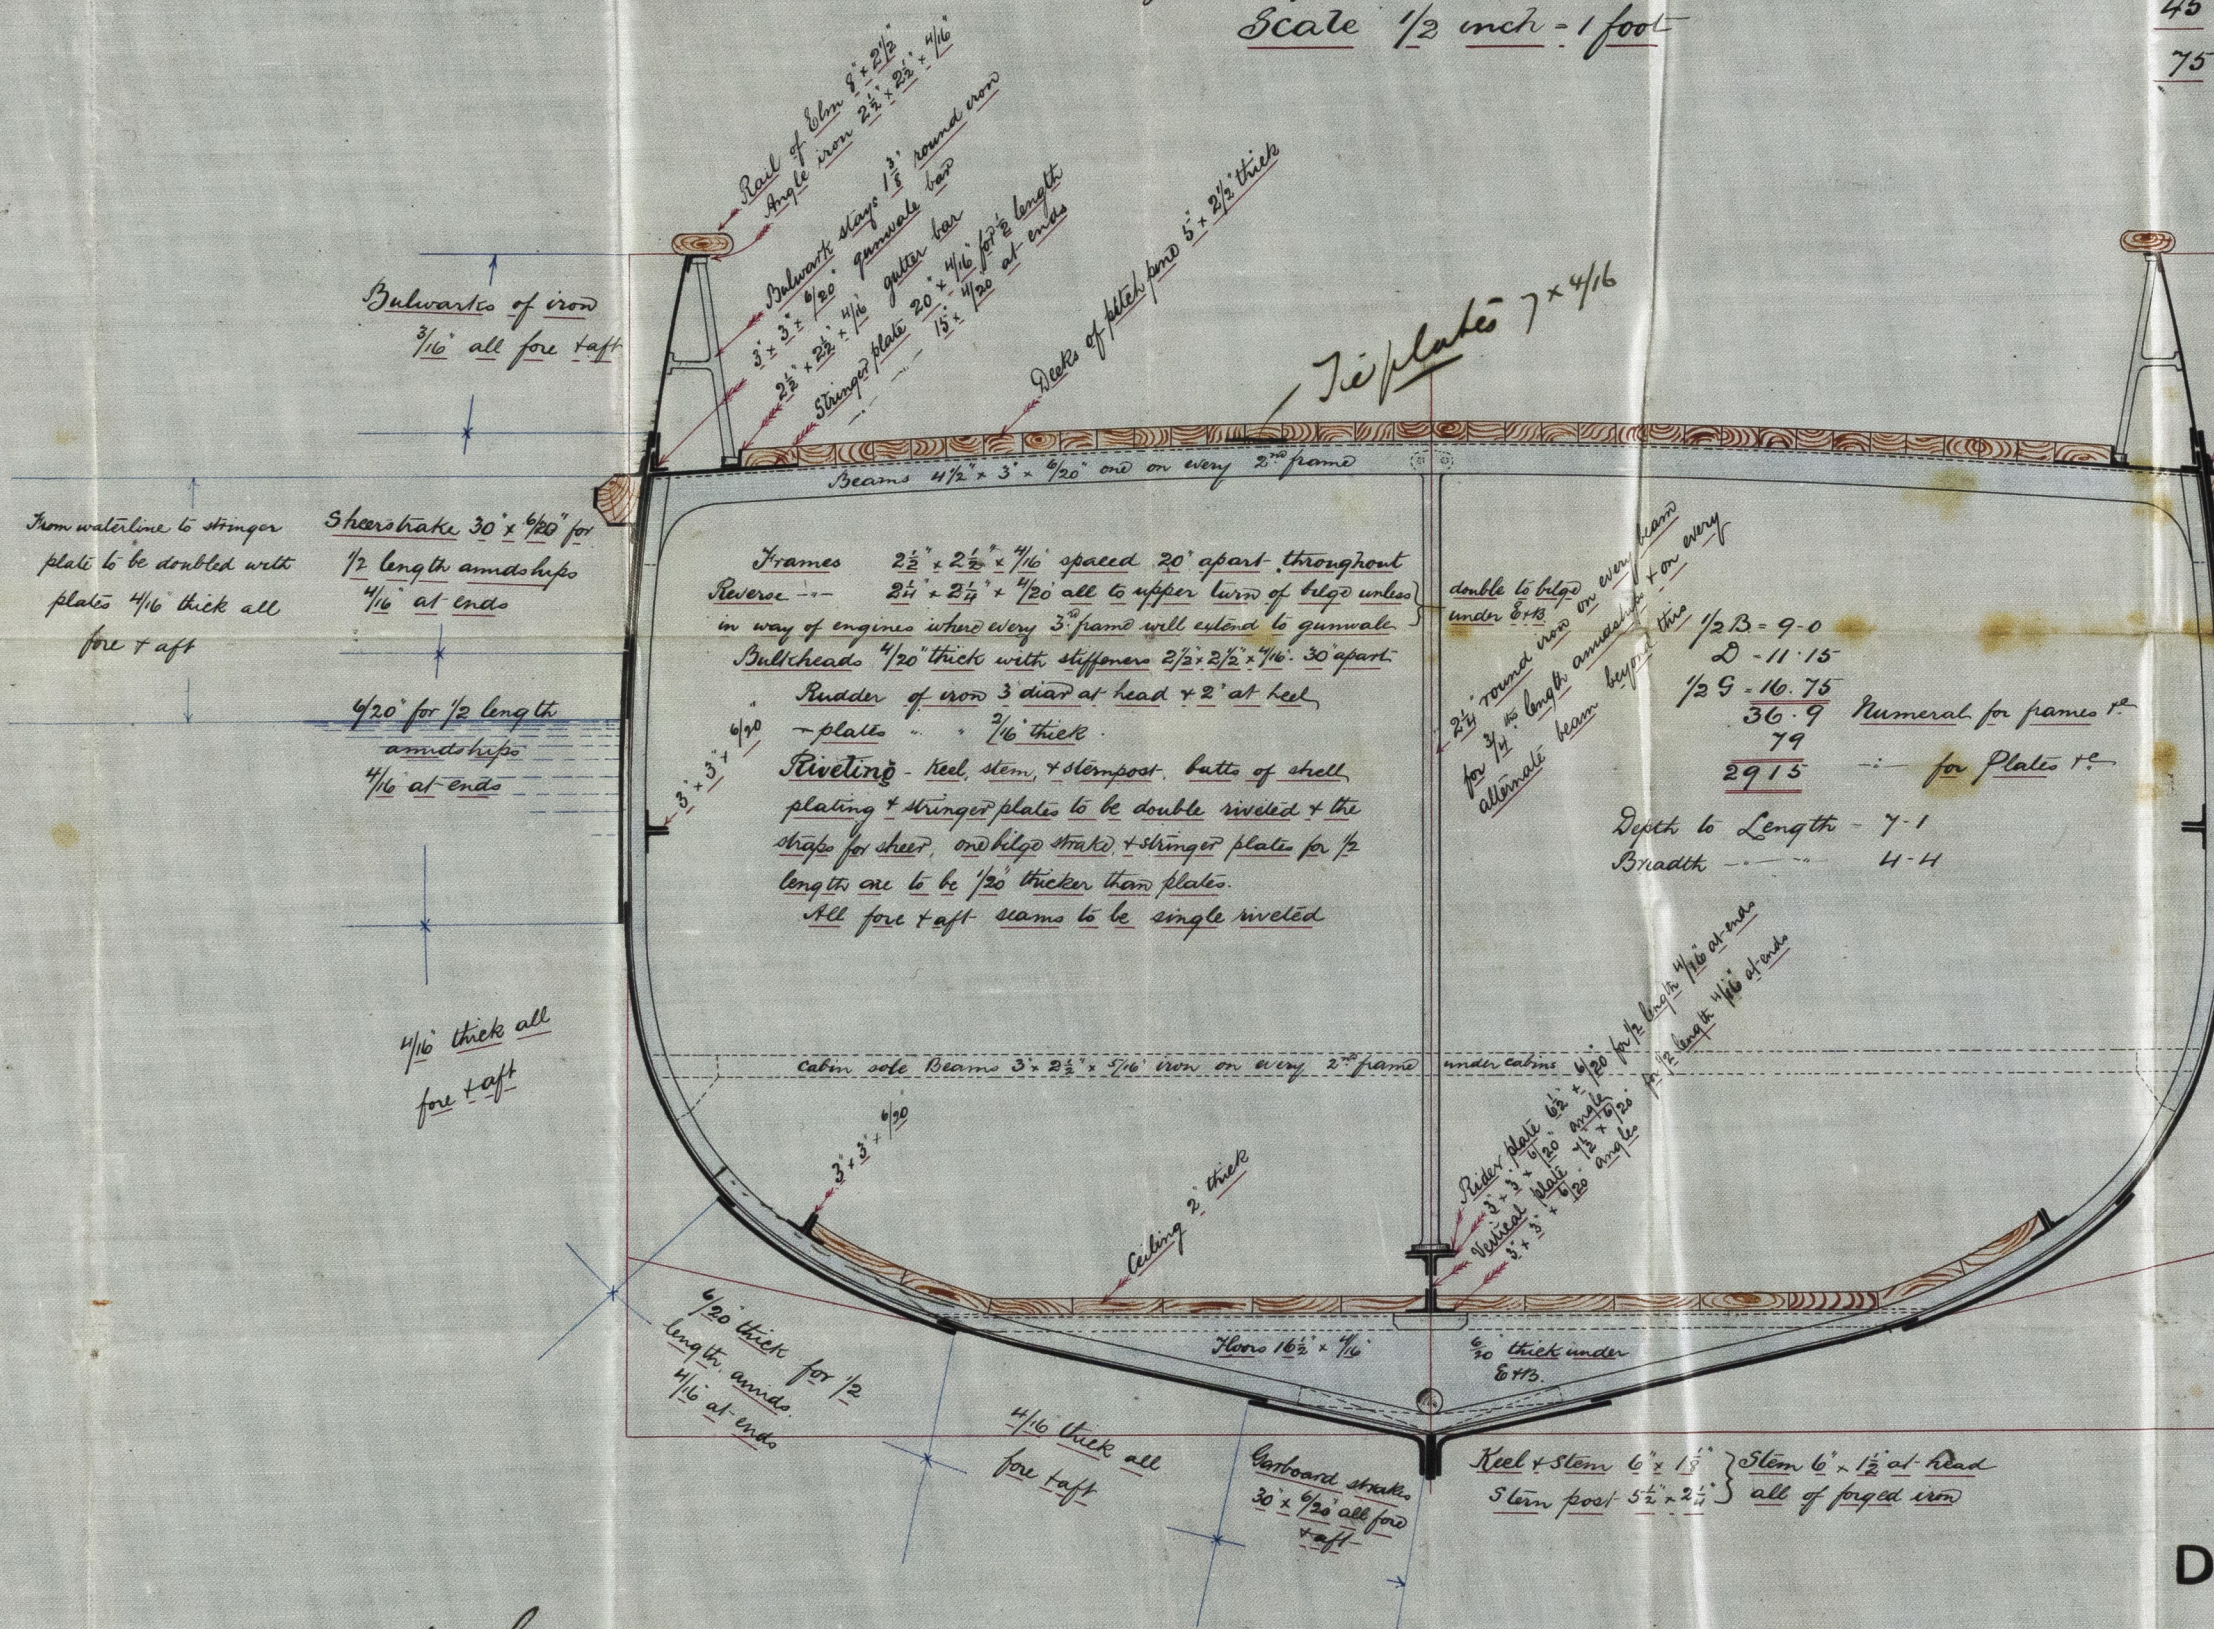

Amended as shown in Red

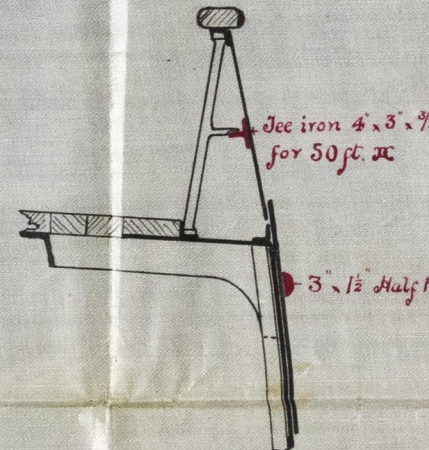

DAVID J. DUNLOP & CO  
ENGINEERS & SHIPBUILDERS  
PORT GLASGOW.

J.H.  
10/2/86