

# Lloyd's Register of British and Foreign Shipping.

(Report on Vessel No. 181 Port Greenock)

## No. 1211 SHIP FORGINGS OR CASTINGS.

I have to report that the undermentioned Iron ~~or Steel~~ Forgings ~~or Castings~~, manufactured by The Irvine Forge Co of Irvine for the Vessel No. 181, being built by Messrs D & J. Dunlop & Co of Port Glasgow, have been inspected by me as set forth below, and found to be, so far as can be seen, sound.



Mark on Forgings.

Lloyd's  
No. 1211  
G. N.

George Newcomb.  
Glasgow. 27/4/86.

	STERN FRAME.	RUDDER FRAME.	STEM.
Material*	/	Scrap iron	/
How made		Forged,	
Dimensions		3 and 2"	
Progress on Inspection		Forging & smithing	
Dates when Inspected		25/3/86. 4.21/4/86.	

SKETCHES OF FRAMES SHEWING POSITION AND DESCRIPTION OF WELDS OF FORGINGS, OR PARTICULARS OF TESTS APPLIED TO CASTINGS.

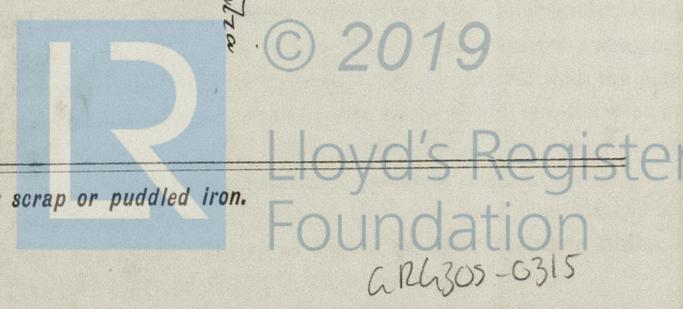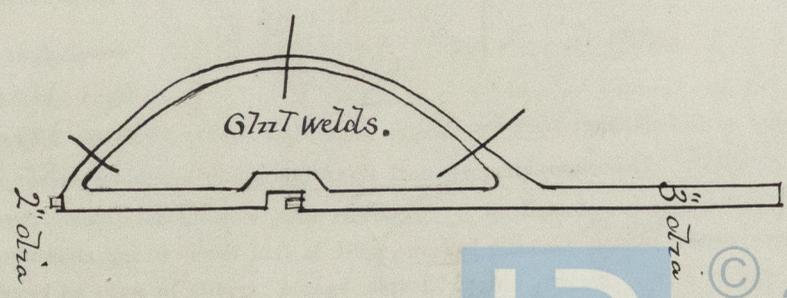

\* If of Iron, state whether scrap or puddled iron.