

Lloyd's Register of British and Foreign Shipping.

(Report on Vessel No. _____ Port _____)

No. 1246

SHIP FORGINGS OR CASTINGS.

The words FORGINGS or CASTINGS, IRON or STEEL, should be struck out as may be required.

We have to report that the undermentioned Iron ~~or Steel~~ Forgings ~~or Castings~~, manufactured by The Lancefield Forge Co of Glasgow for the Vessel No. 212, being built by Messrs Blackwood & Gordon, of Port Glasgow have been inspected by us as set forth below, and found to be, so far as can be seen, sound and efficient.

Mark on Forgings.


Lloyd's
No. 1246
G. N.

George Newcomb.
J. M. D. Glasgow.

1/9/86.

	STERN FRAME.	RUDDER FRAME.	STEM.
Material*	/	Scrap iron	/
How made		Forged	
Dimensions		5 1/2 x 3"	
Progress on Inspection		Forging & smithing	
Dates when Inspected		15.19.26/6/86. 7/7/86. 5.9.13.23/8/86.	

SKETCHES OF FRAMES SHEWING POSITION AND DESCRIPTION OF WELDS OF FORGINGS, OR PARTICULARS OF TESTS APPLIED TO CASTINGS.

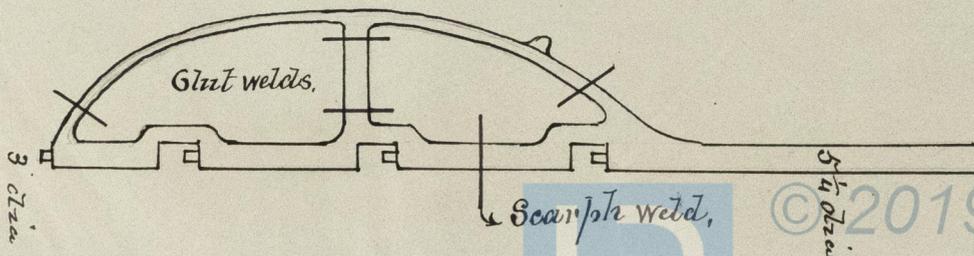

* If of Iron, state whether scrap or puddled iron.