


RECEIVED
27 APR. 86
LONDON

24.4.86.

S. S. Australind:
Greenock Report no. 9223.

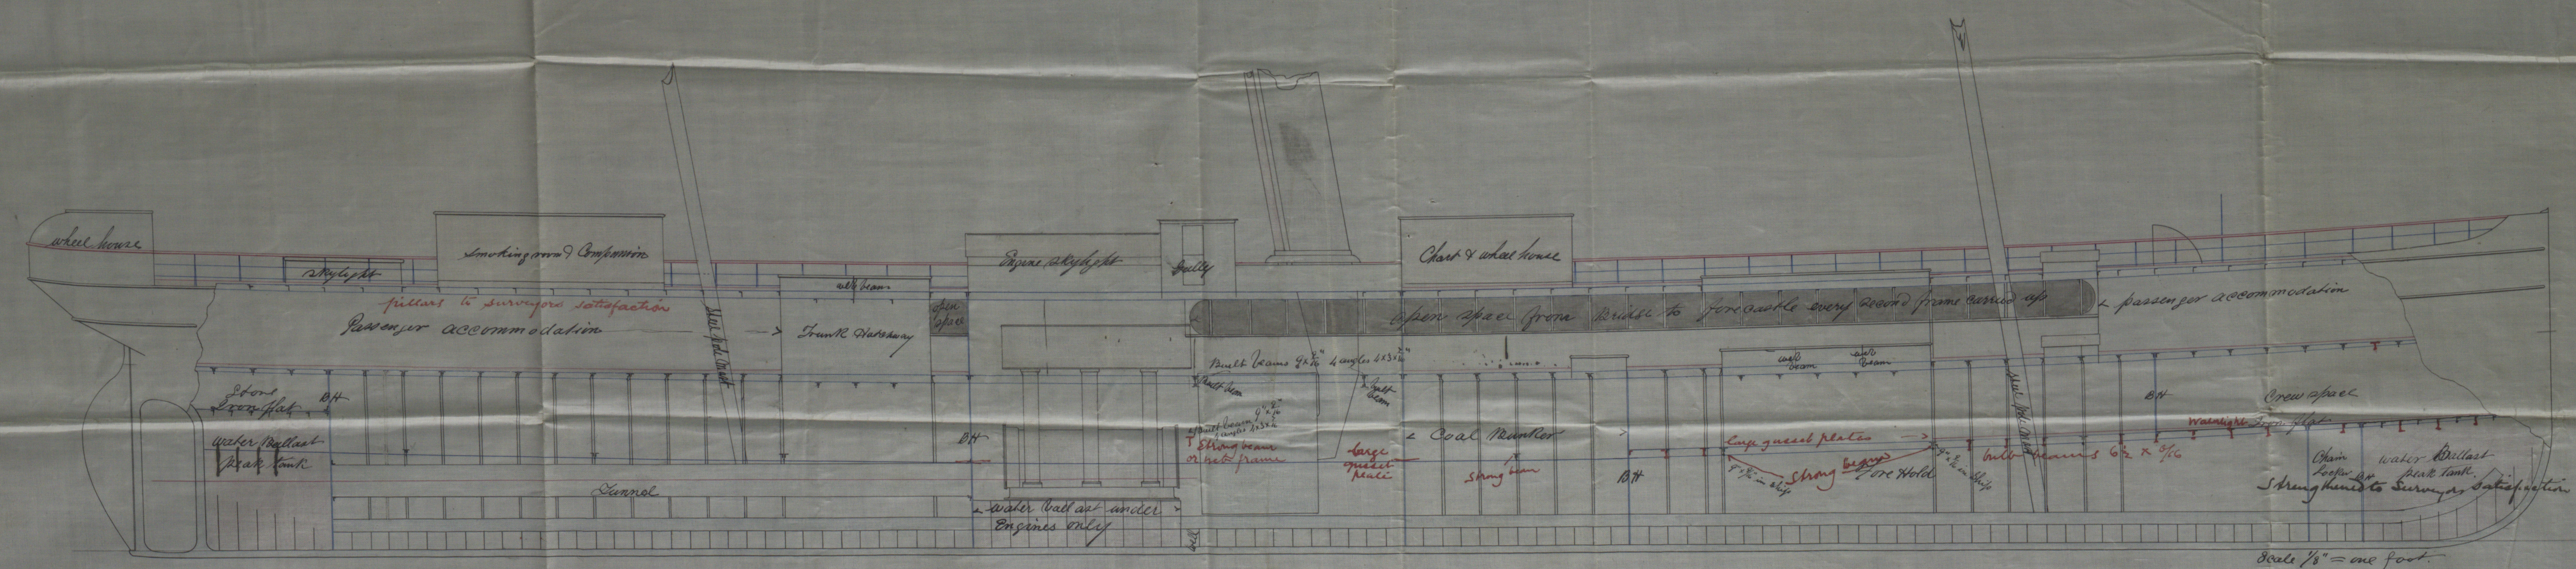

Longitudinal Section
of S.S. 212 Iron screw Steamer
Length Keel & Forecastle = 224' 10"
Breadth of Beam moulded = 31' 9"
Depth of Hold = 14' 6"
Tonnage Gross - about 2000 tons
Class 100 A1 A Survey

BLACKWOOD & GORDON
ENGINEERS
23 APR. 86
IRON SHIP BUILDERS
PORT GLASGOW
Drawing
No 870

J.H.
28/4/86