

LLOYD'S REGISTER OF SHIPPING  
LONDON

2/6/86

BLACKWOOD & GORDON  
ENGINEERS  
28 MAY. 86  
IRON SHIP BUILDERS  
PORT GLASGOW

REGISTER OF SHIPBUILDERS  
SURVEYORS  
OFFICE  
GREENOCK

S.S. 212.


S.S. Australind

Greenock Report No. 9223

25.6

bsk

Boiler for Engine No. 295  $19 \times 30 \times 50$   
36 x 150 lbs per sq inch  
End view of Tube plates & furnaces

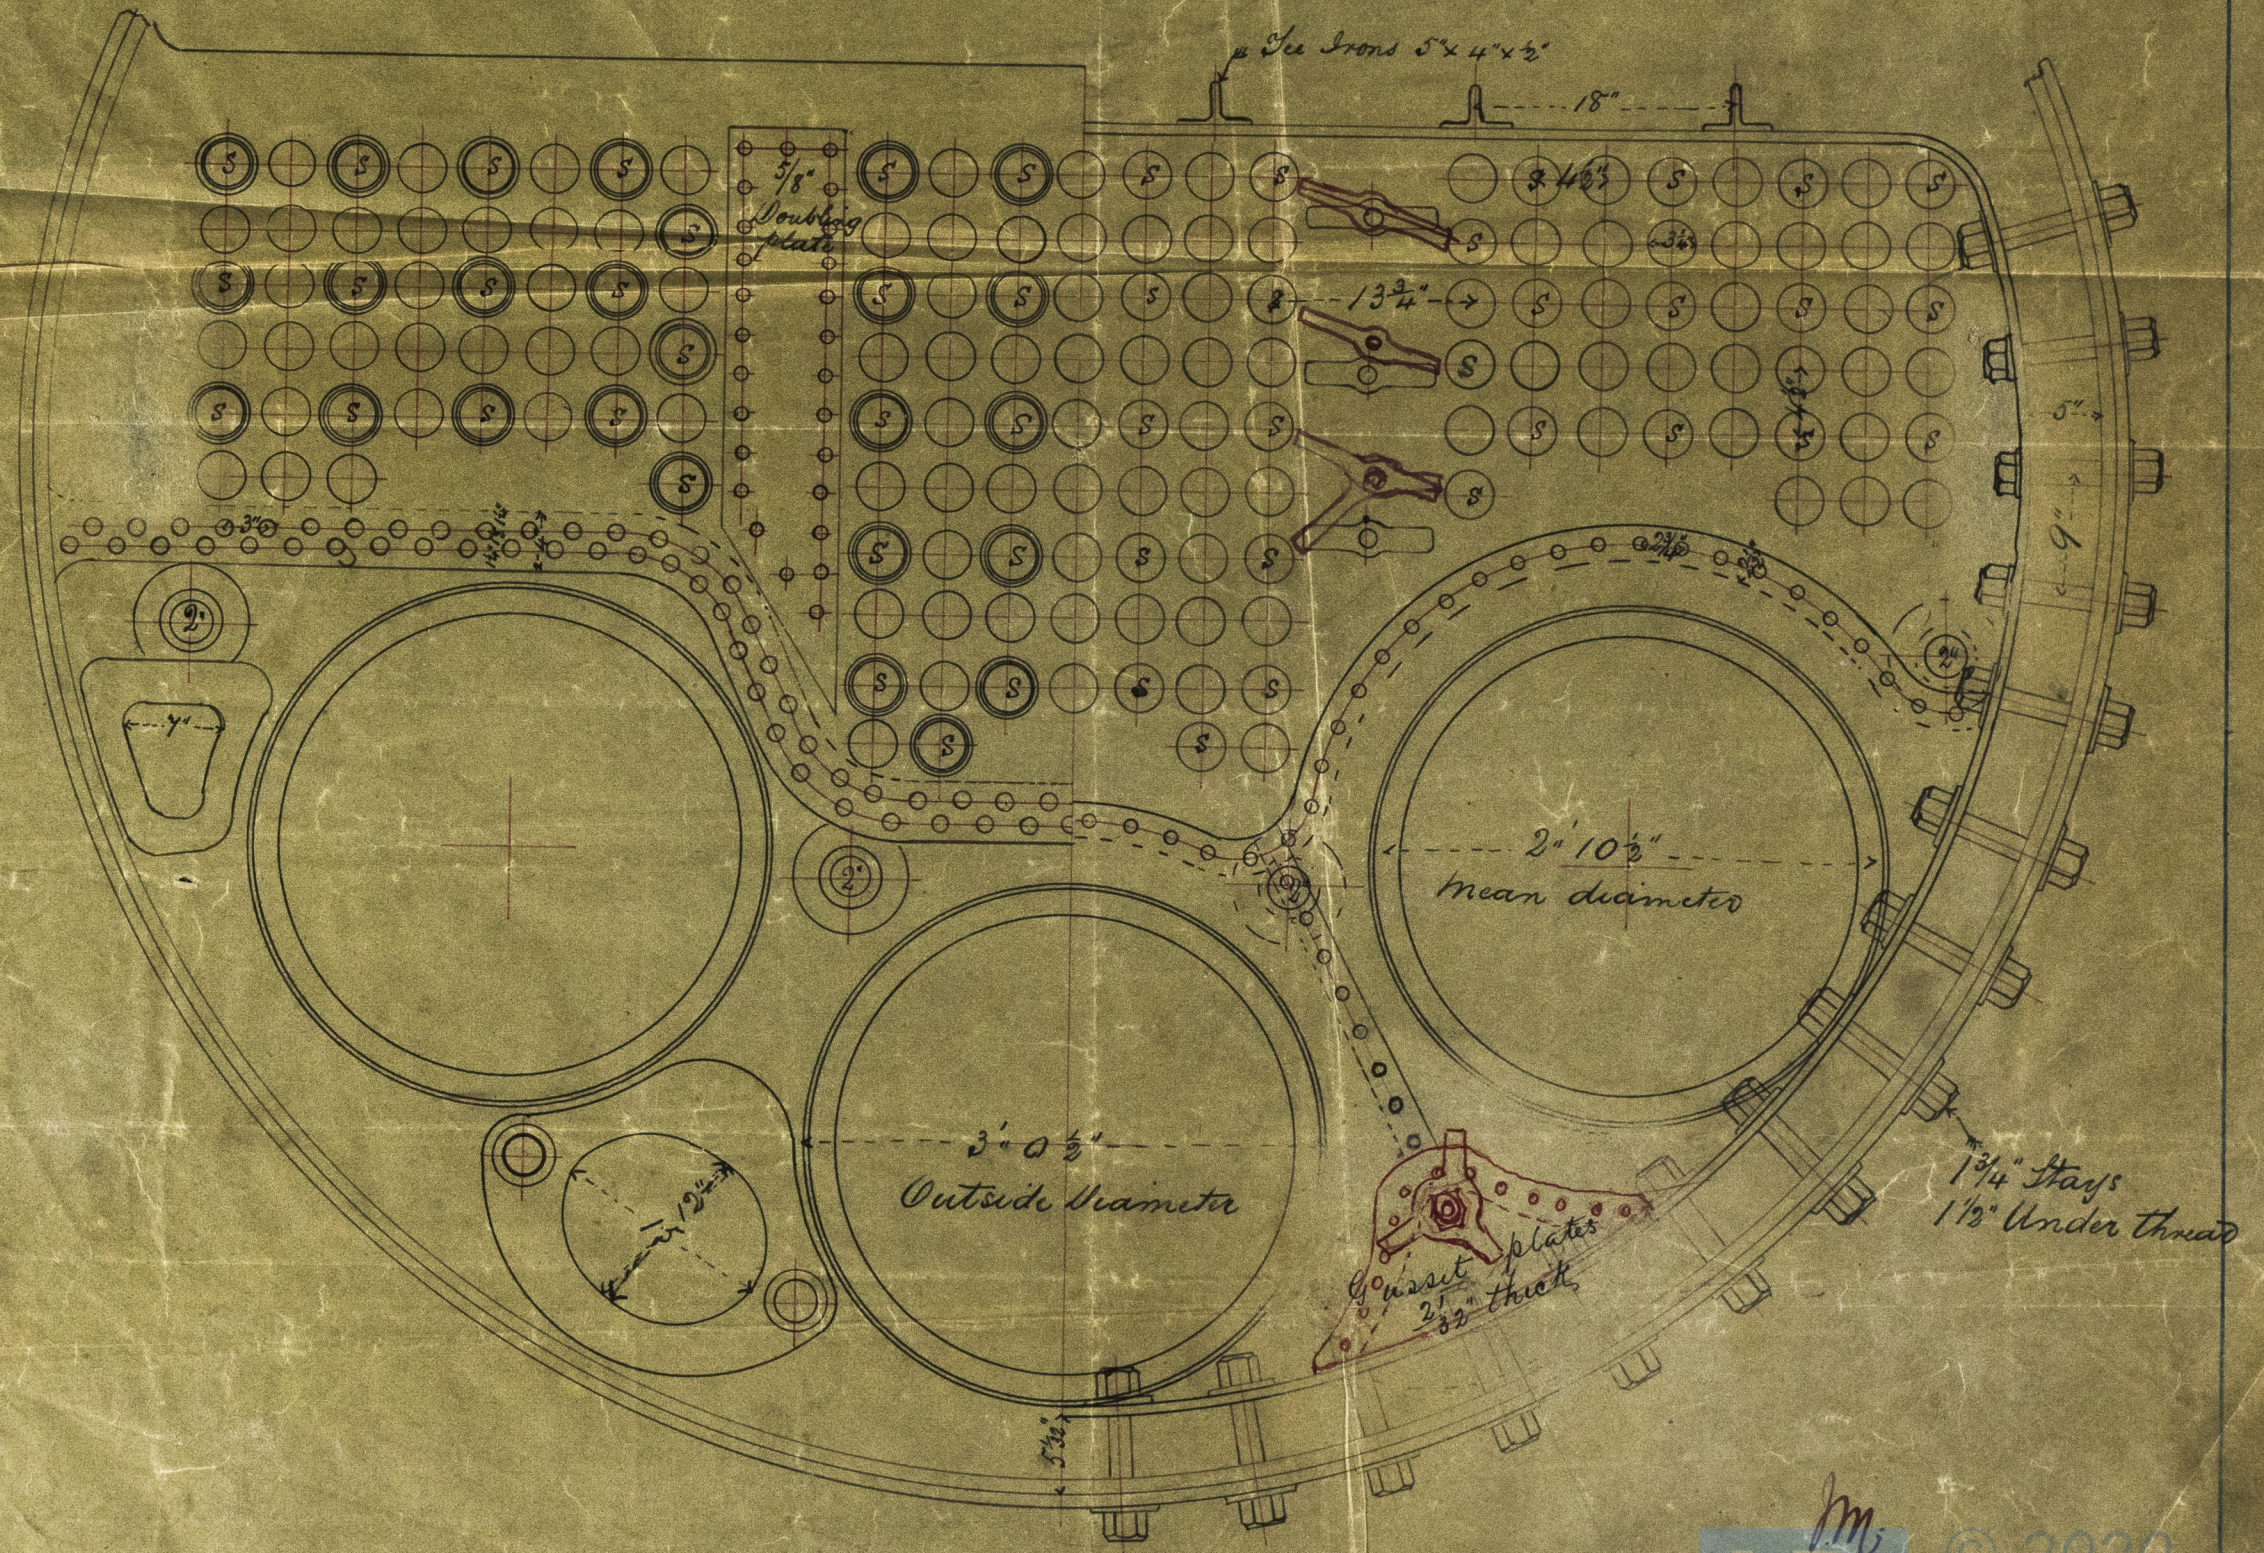

LM  
2/6/86

GRK 306 - 0150

© 2020  
Lloyd's Register  
Foundation