


17.2.87

Steel Masts


S S N^{os} 169 & 170

Scale $\frac{1}{2}$ inch = one foot.


s.s. "Jafso"
Greenock Report No. 9380

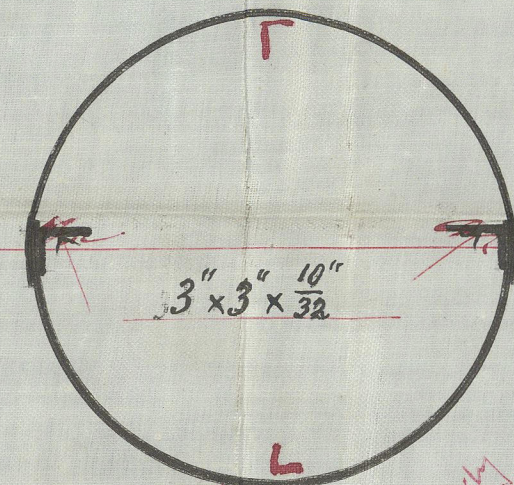


Angles to be fitted in
centre of plate.
Keels to be efficiently
strengthened.

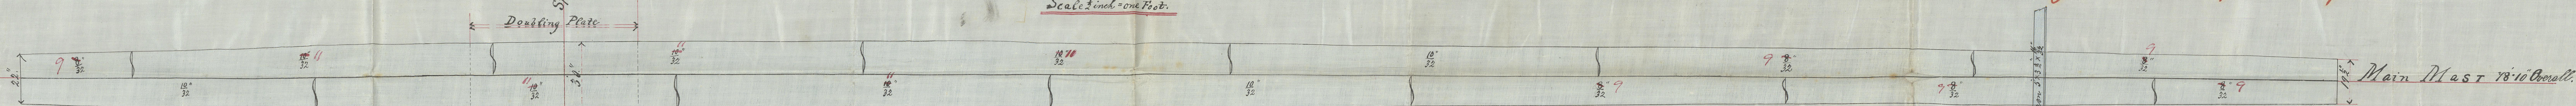

Straps below mast partners double riveted remainder treble
Straps to thicker than the plates they connect and fitted outside
Angle irons in Masts $3\frac{1}{2} \times 3 \times \frac{13}{32}$ whole length.
Lands of Mast $4\frac{1}{2}$ double riveted $\frac{3}{4}$ rivets
Treble riveted straps $12 \times 14\frac{1}{4}$ Double $8 \times 9\frac{3}{4}$

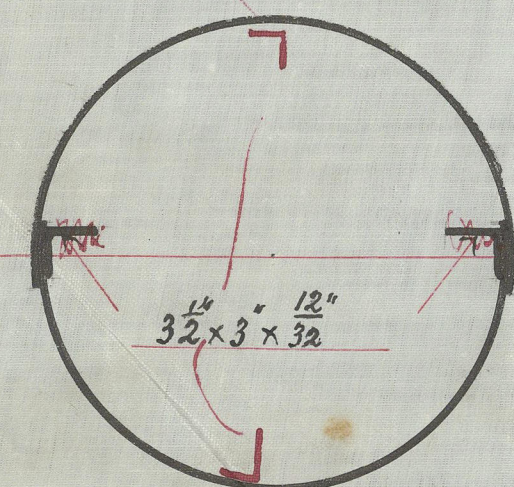

J.H.L.
7/2/87

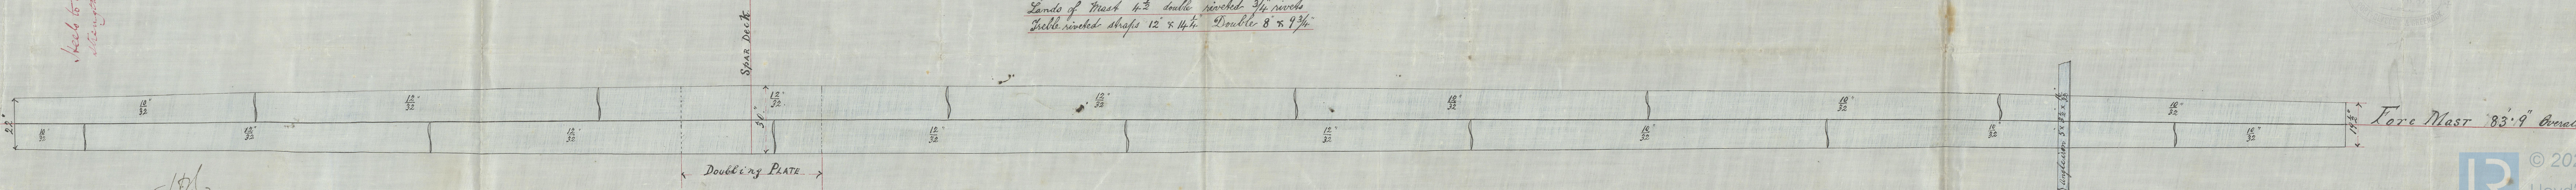

Fore Mast 83'9" Overall.

ARL307-0092