

# Lloyd's Register of British and Foreign Shipping.

(Report on Vessel No. 9380 Port Greenock)

No. 545-a

## SHIP FORGINGS OR CASTINGS.

I have to report that the undermentioned Iron or Steel Forgings or Castings, manufactured by

The Darlington Forge Co. of Darlington  
for the Vessel No. 169, being built by Messrs Russell & Co.  
of Port Glasgow have been inspected by me as set forth below, and found  
to be, so far as can be seen, sound

Mark on Forgings.

Lloyd's

No. 545-a


H.C.

Wm A Cameron

Sunderland  
13/6/84

	STERN FRAME.	RUDDER FRAME.	STEM.
Material* - - - -	<u>Scrap iron</u>	<u>Scrap iron</u>	<u>Scrap iron</u>
How made - - - -	<u>Forged</u>	<u>Forged</u>	<u>Forged</u>
Dimensions - - - -	<u>10' x 6'</u>	<u>8 1/4' - 4 1/4'</u>	<u>10' x 2 3/4'</u>
Progress on Inspection -	<u>Forged &amp; Smithed</u>	<u>Forged &amp; Smithed</u>	<u>Forged</u>
Dates when Inspected	{ <u>Jan 5-7-11-14-19-22-26-27-31/84</u> <u>Apr 1-20</u> <u>May 10-13-15-23-27</u> <u>June 7-10/84</u>		<u>Jan 5-7/84</u>

SKETCHES OF FRAMES SHEWING POSITION AND DESCRIPTION OF WELDS OF FORGINGS, OR PARTICULARS OF TESTS APPLIED TO CASTINGS.

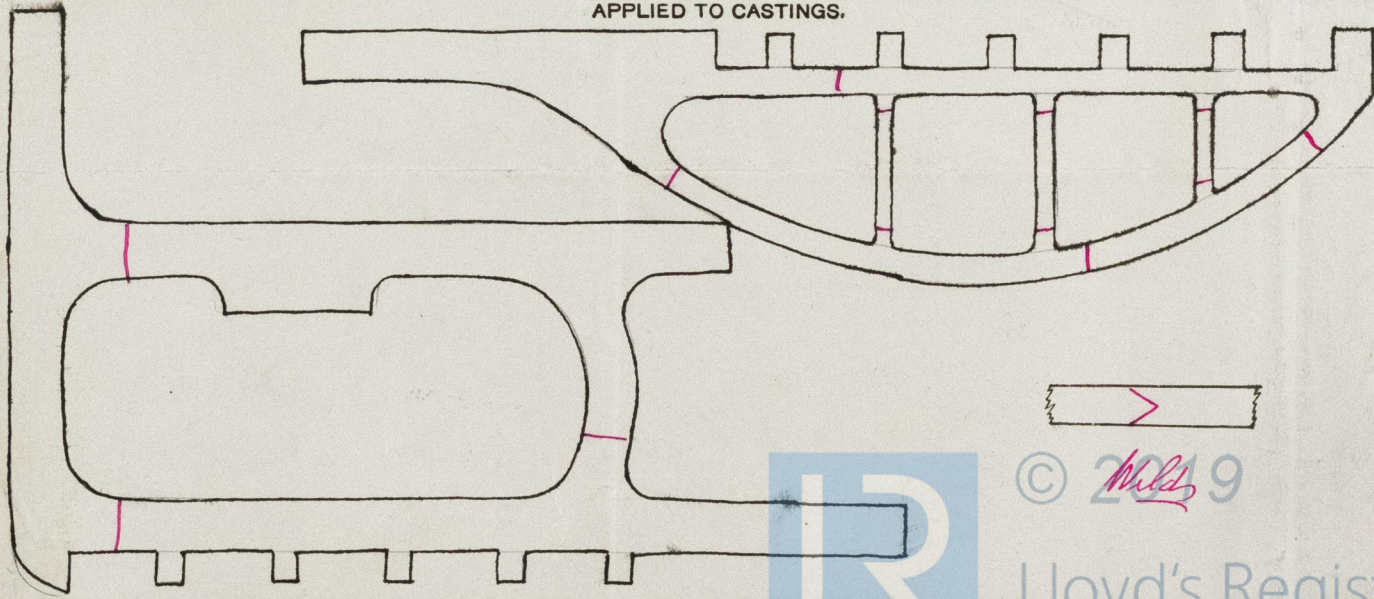

\* If of Iron, state whether scrap or puddled iron.