



s.s. "Jafso": Greenock Report No. 9380

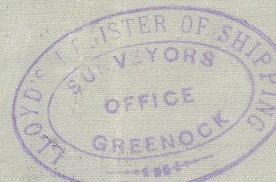


25.1.87
10.3.87.

— Midship Section —
— Shewing Web Frame —
— S.S. No. 169 + 70 —
Scale 1/2 inch = one foot

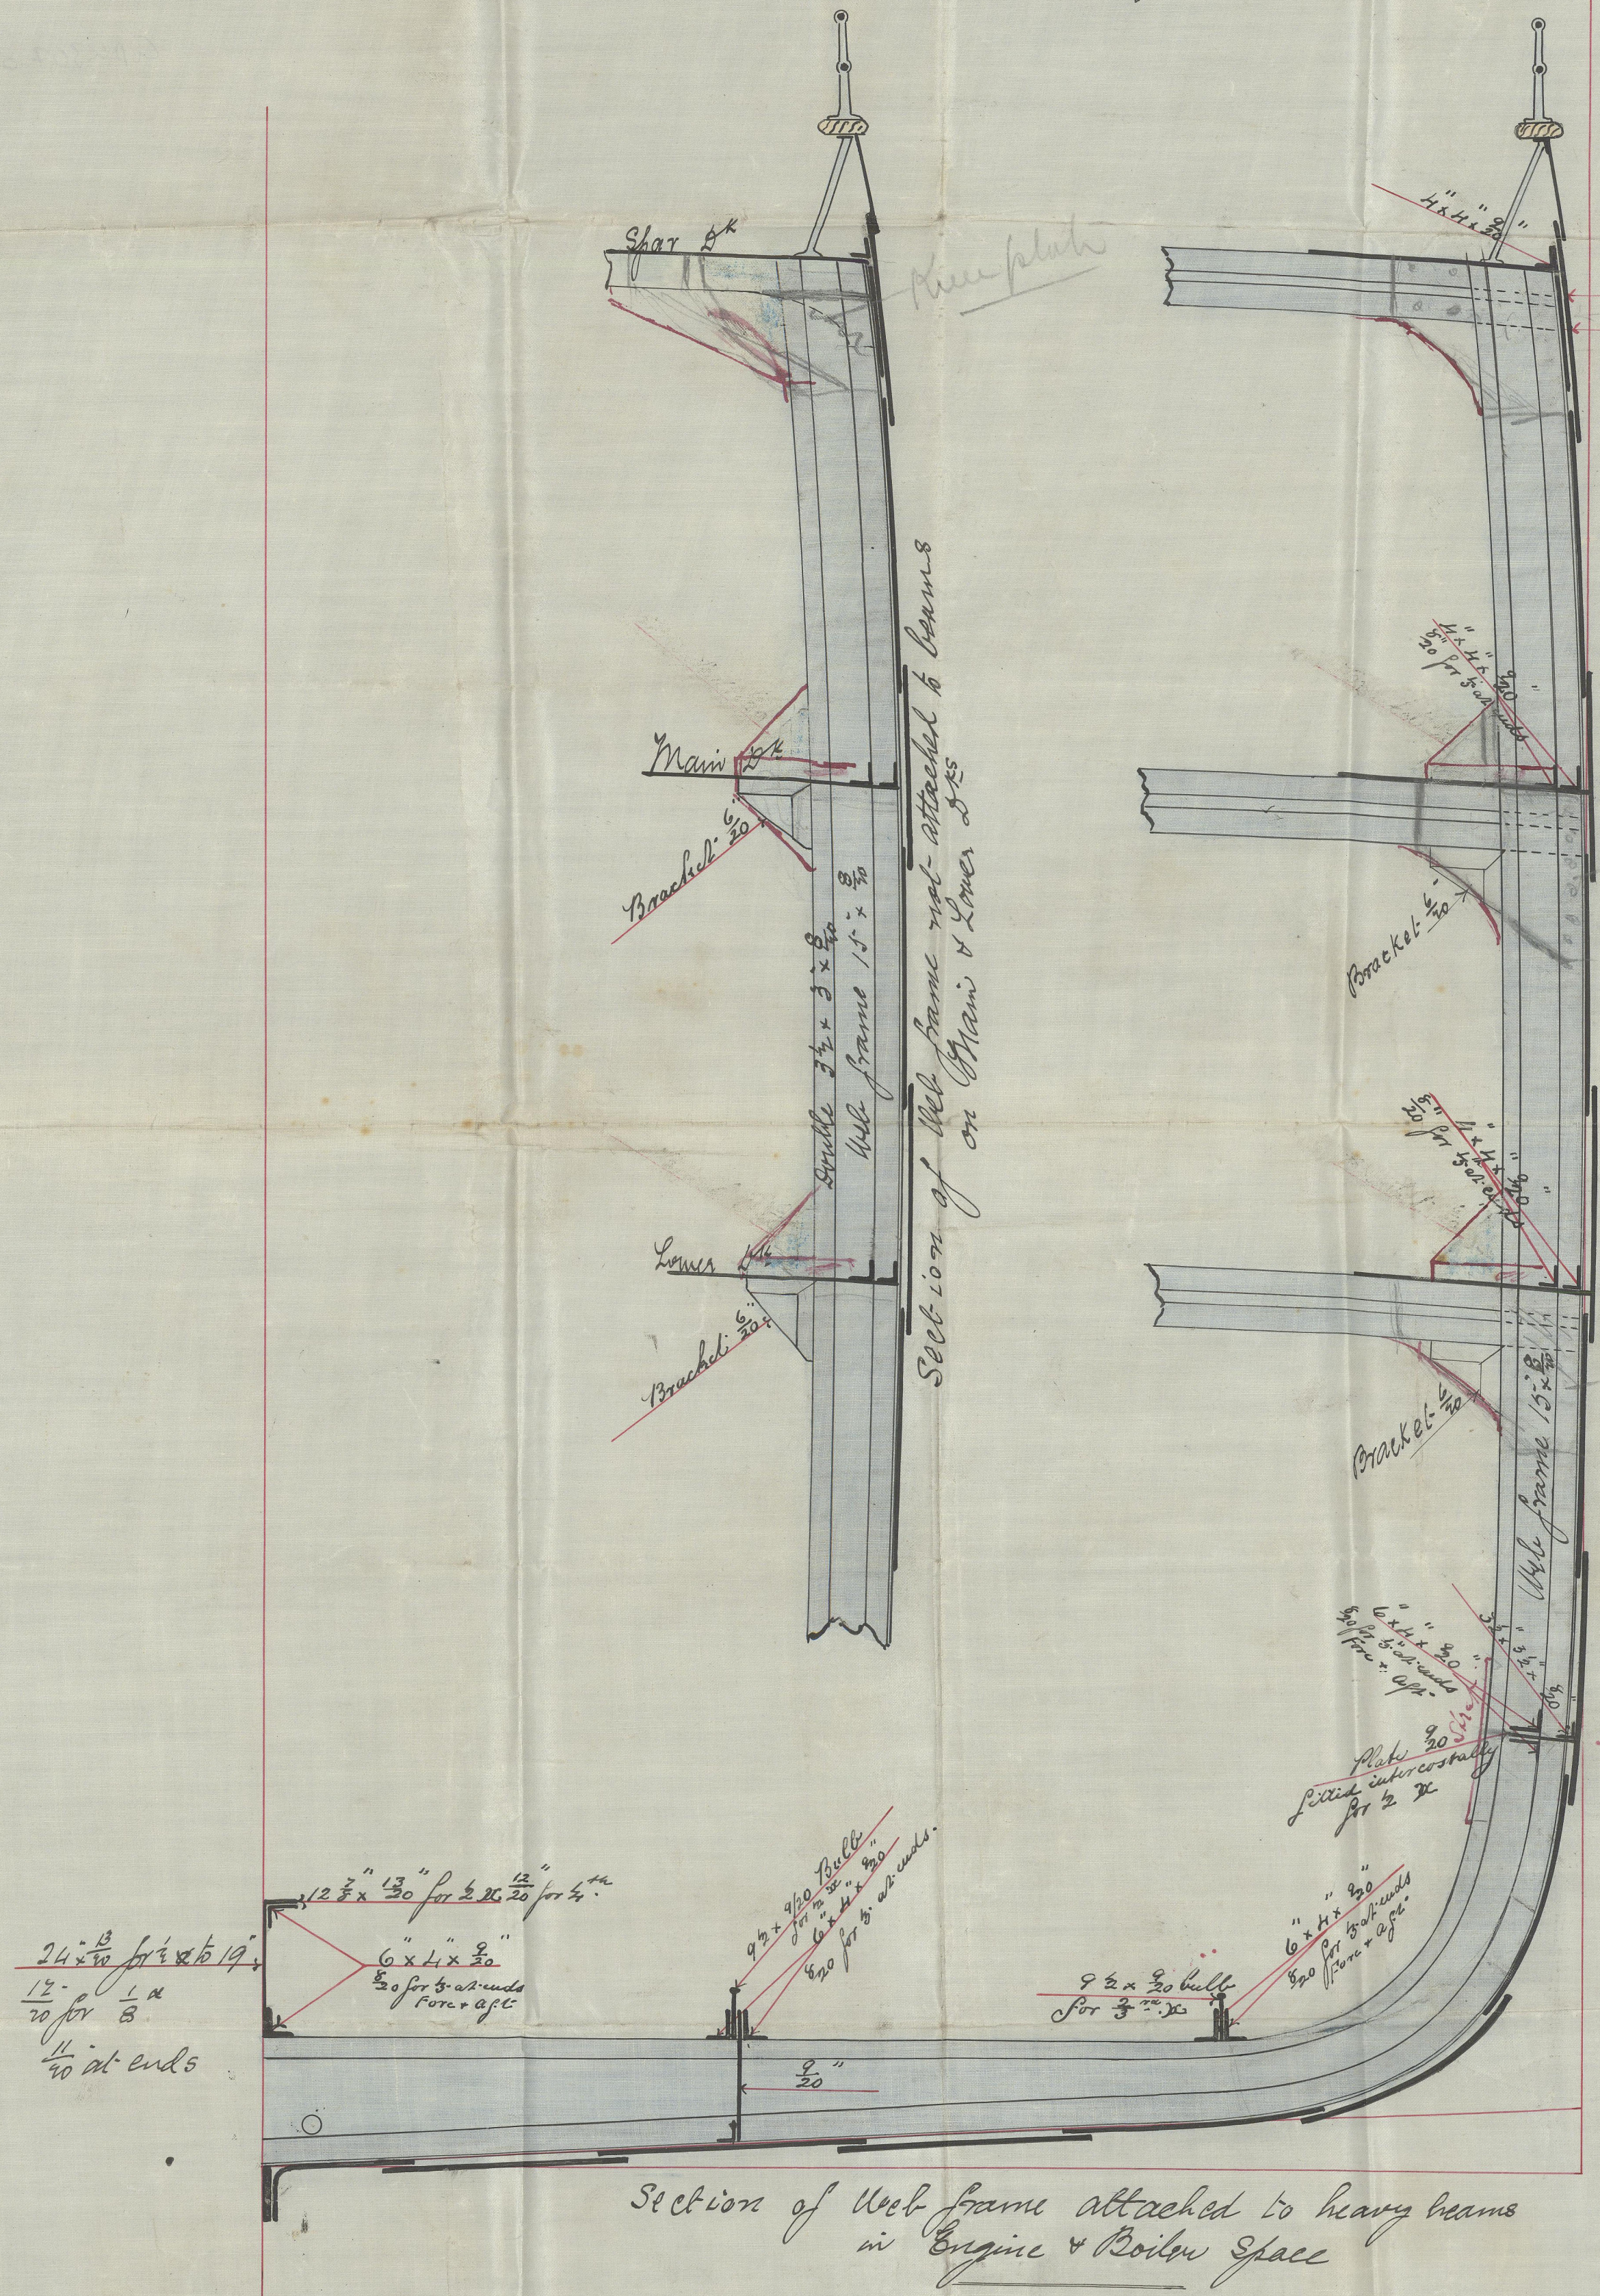


40 x 1 1/2 ft 1/2 x
Riveting Plate 20 x 10 ft 1/2 x
In line of Riveting Plate
Sheet plate to be 40 x 10 ft 1/2 x

Sketch of Buzz Straps.
Scale 1 inch = 1 foot.

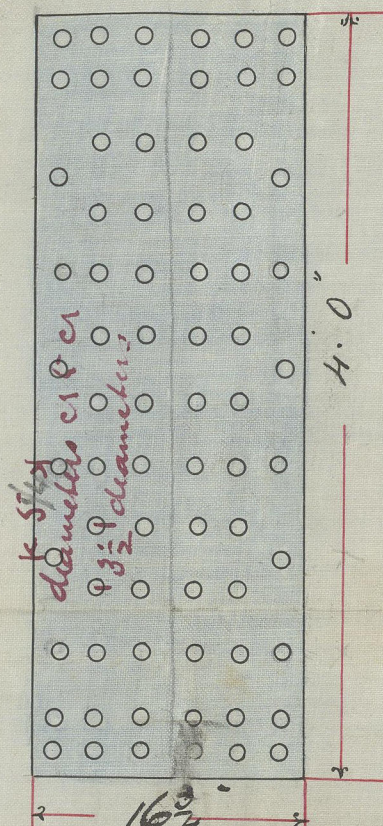

Double riveted strap

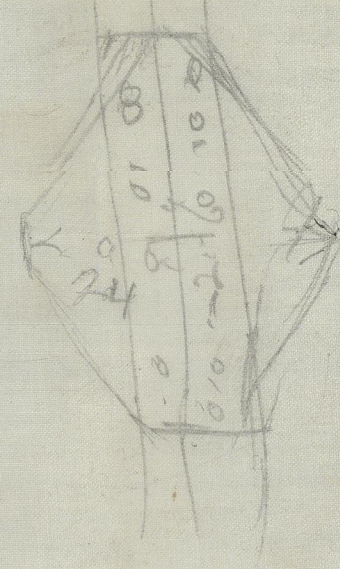

J.H.
24/1/87

