



SCALE $\frac{1}{2}$ INCH = 1 FOOT

25.1.87
31.1.87

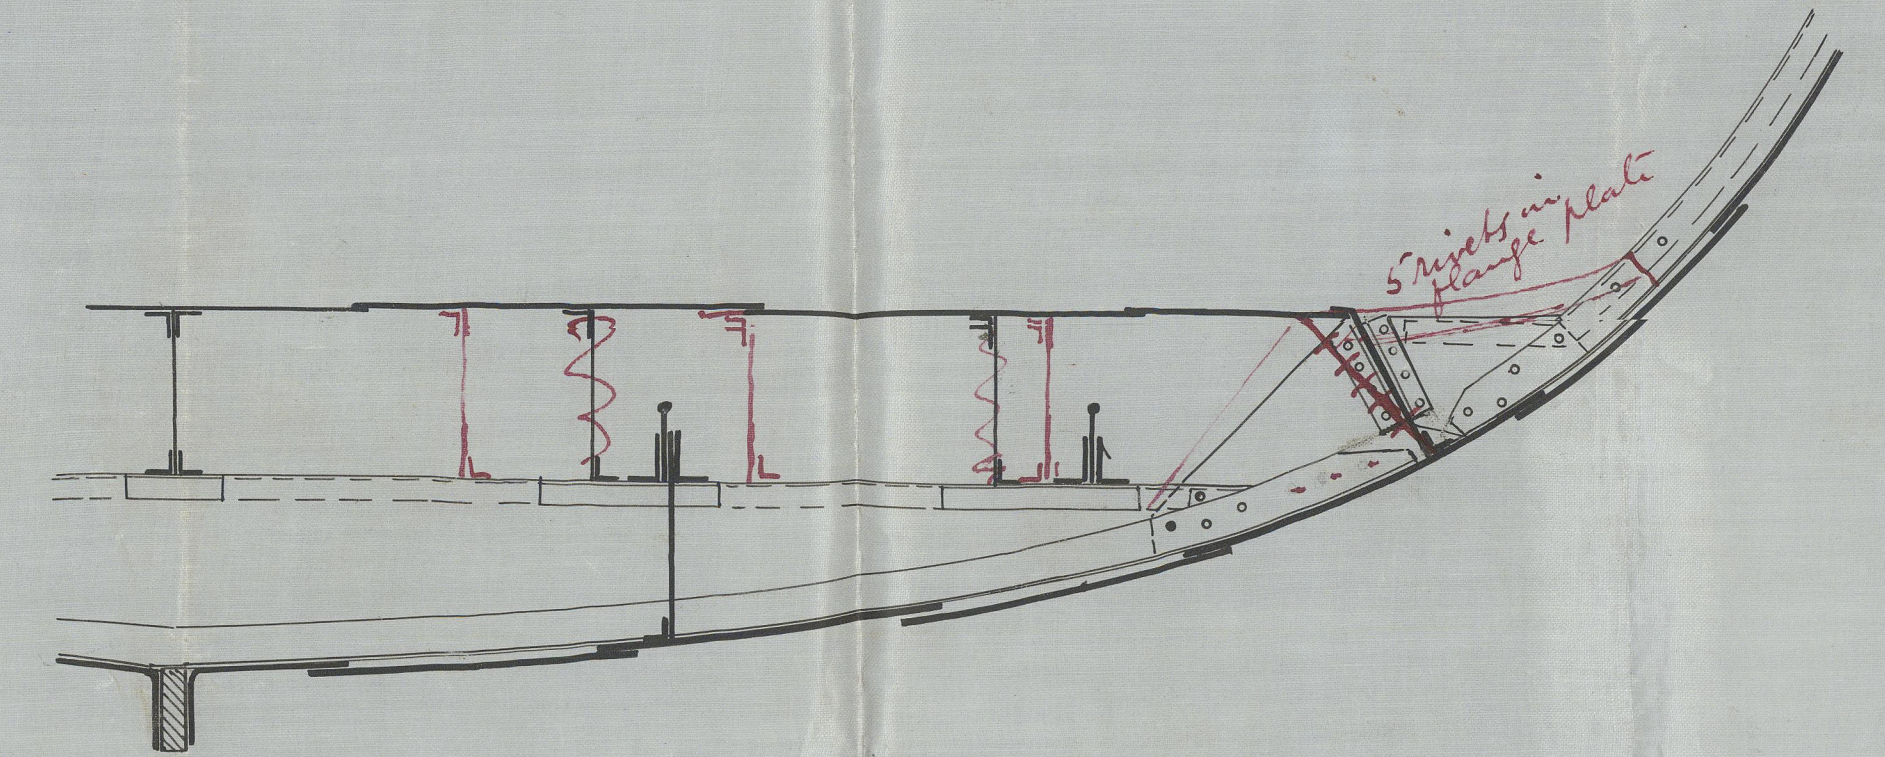

All strokes of Fluting (except Barbois strokes) in way of double bottom to be reduced to $\frac{1}{4}$

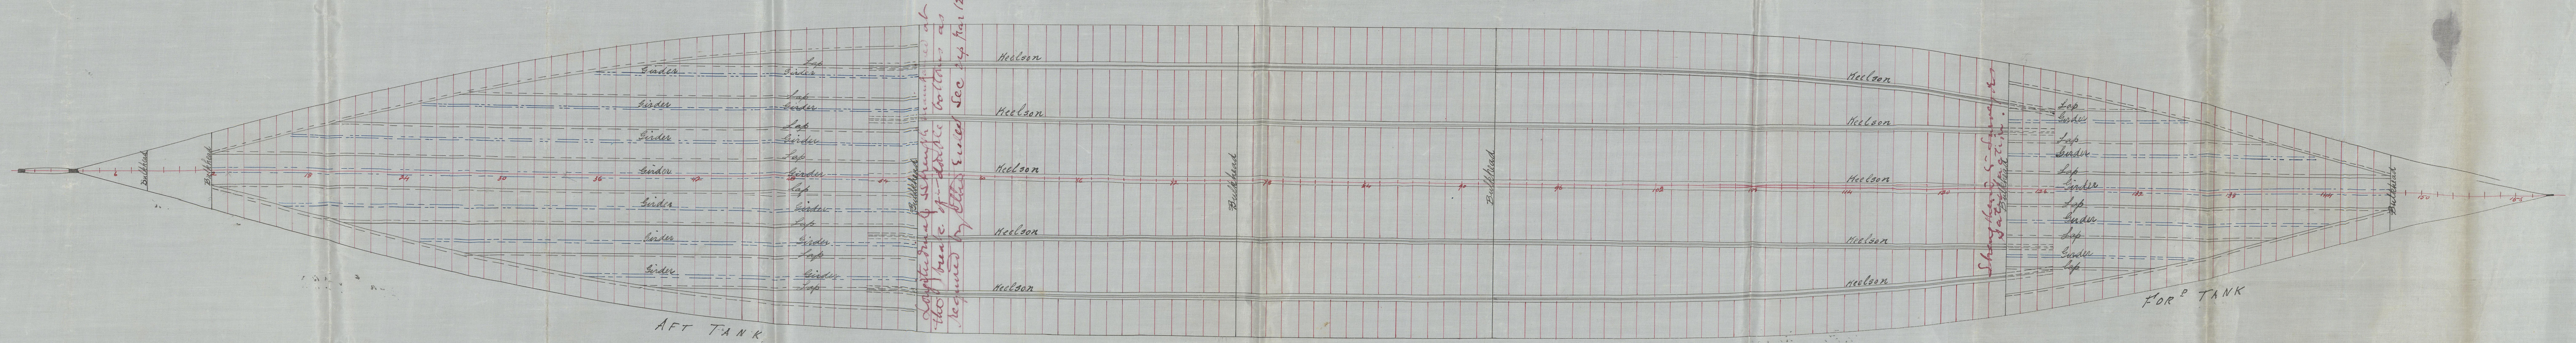

SCALE $\frac{1}{8}$ INCH = 1 FOOT

W. J. L.
24/1/87

