


See G. to G. 13. 8. 87.

S. S. "Hisanga":
Grk. Rept. No. 9428.

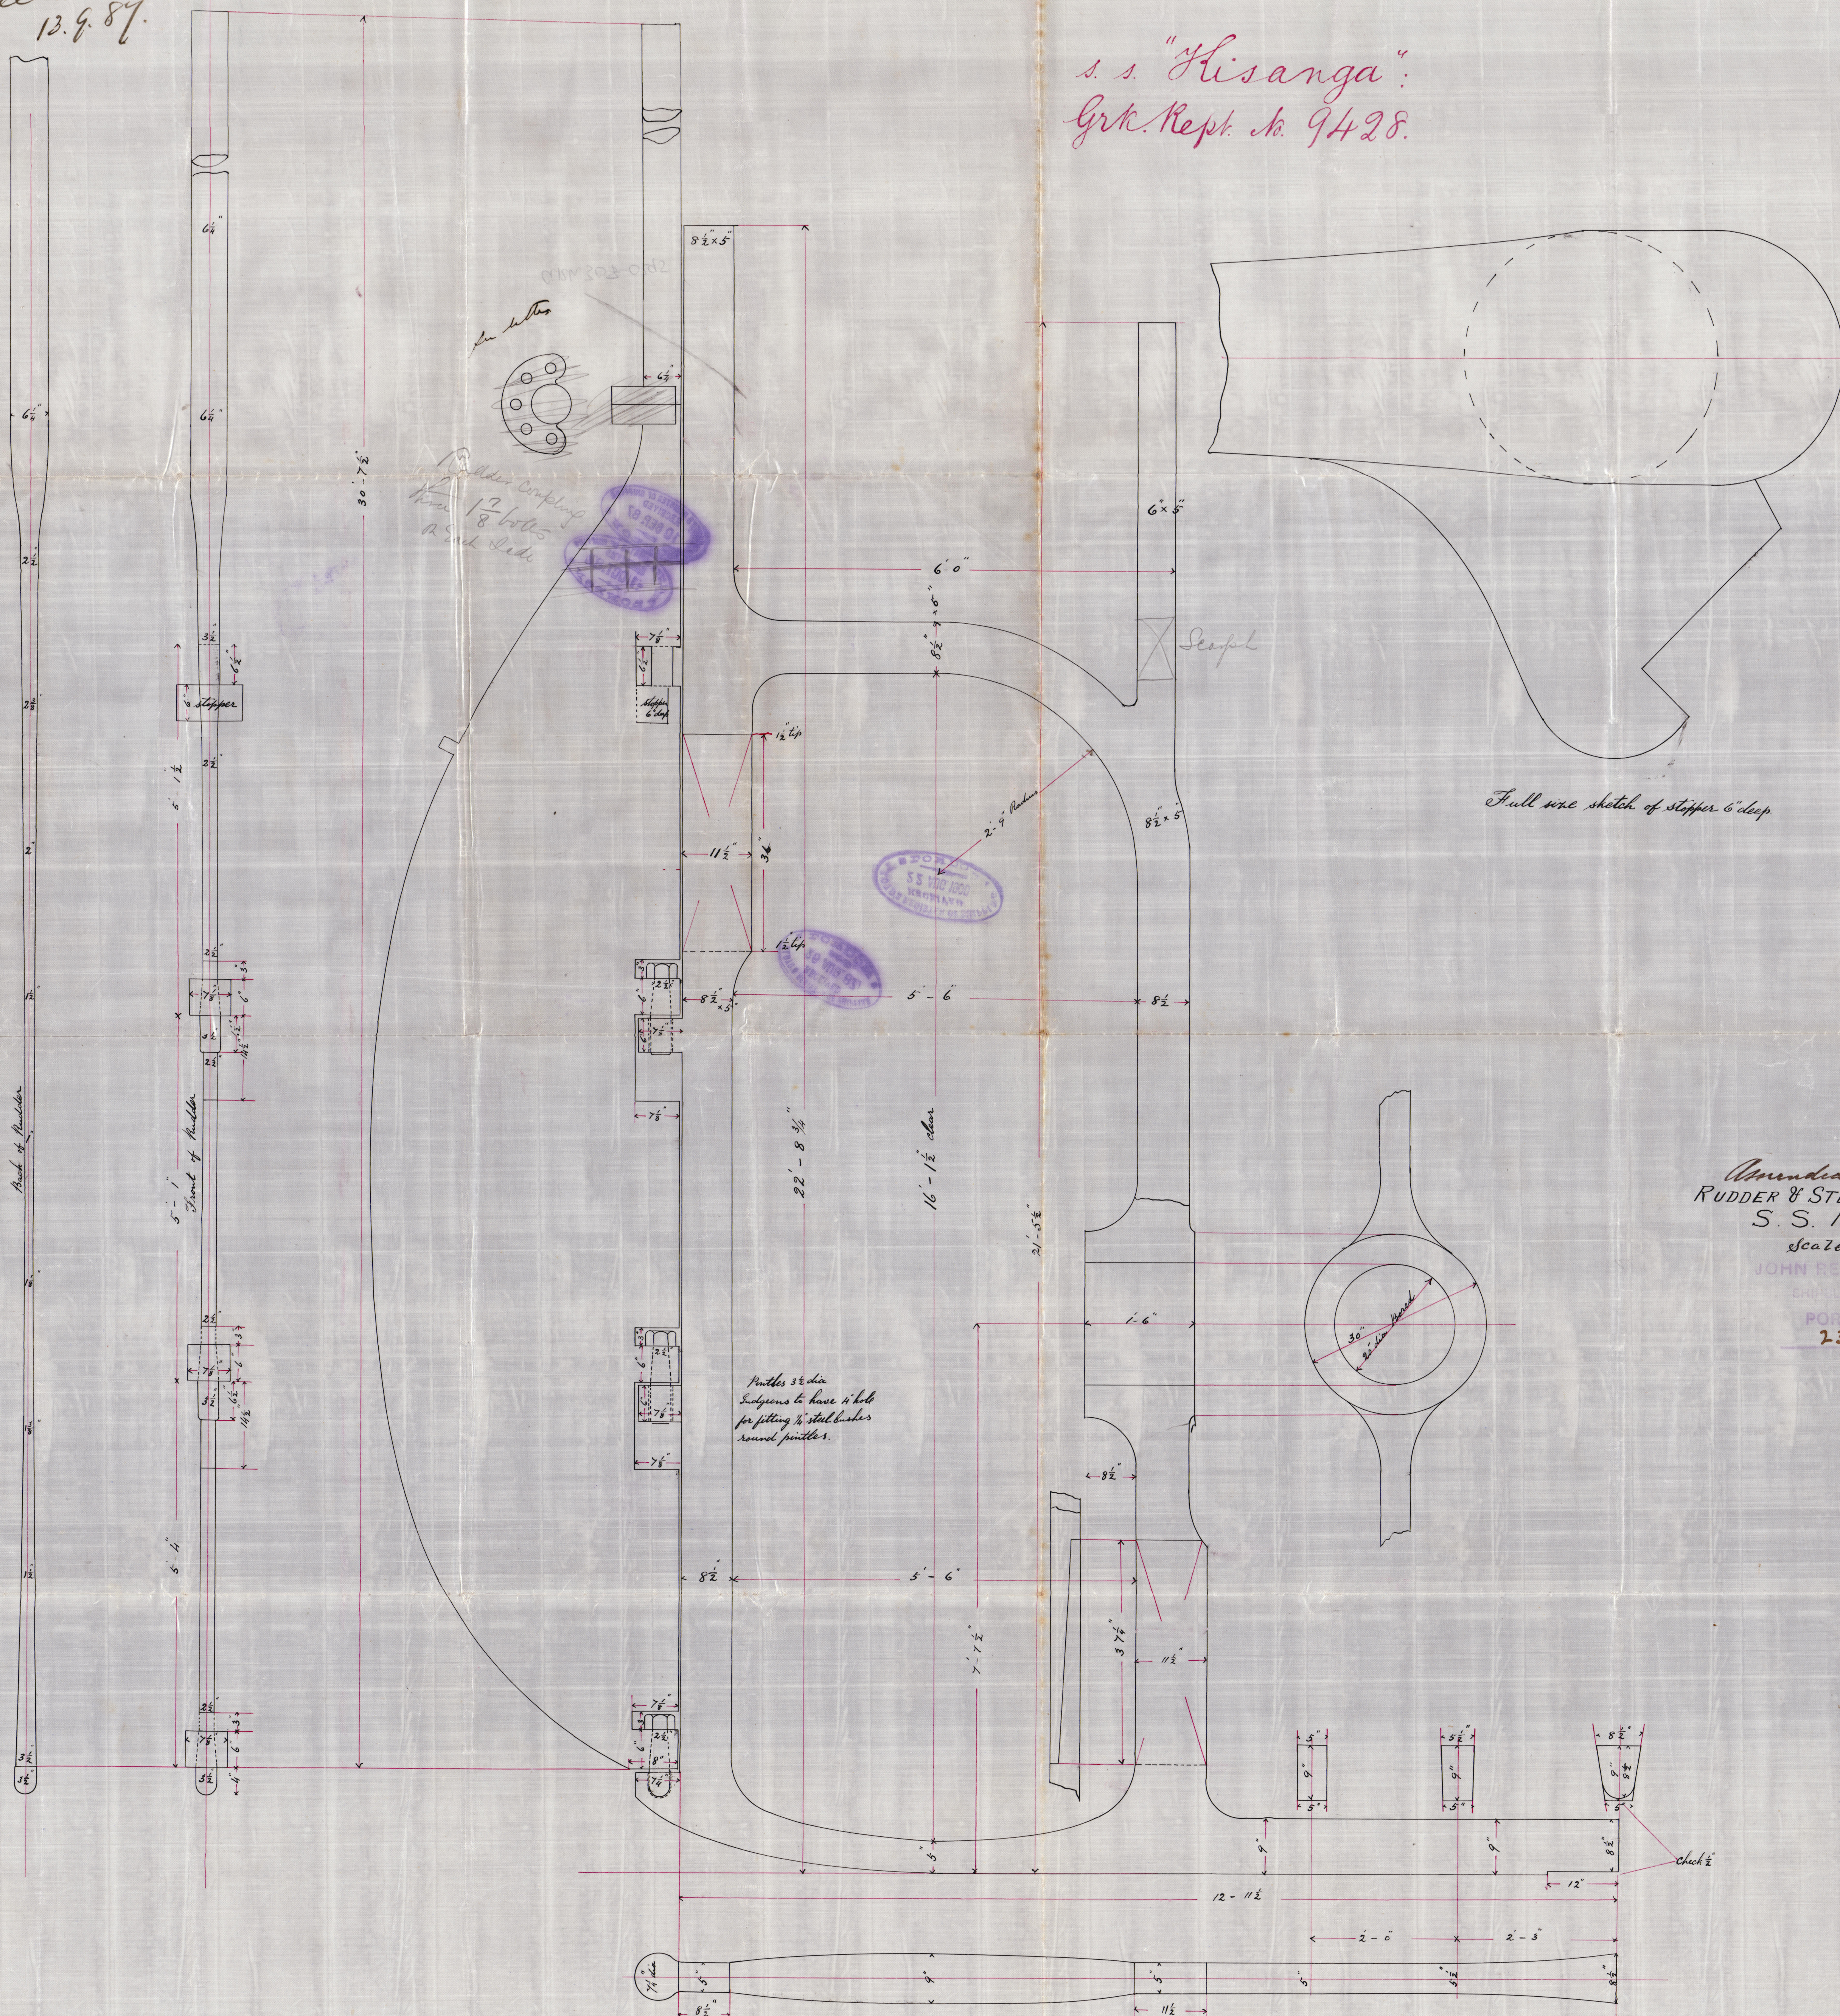

Full size sketch of stopper 6' deep

RUDDER & STERN FRAME
S. S. No 8/C
Scale 1" = 1 foot
JOHN REID & CO.
SHIPBUILDERS
PORT JOW
23rd Aug. 1887.

