



7.9.84

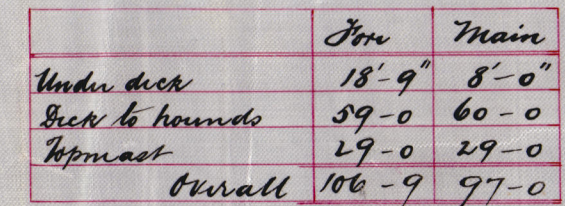

Steel Pole Masts for ^{ss.} No. 876-

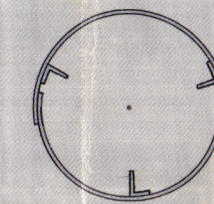

3 augus $3\frac{1}{2} \times 3 \times \frac{6}{20}$
from hnt to ~~hounds~~
head

7/9/87 *Ek*


JOHN REID & CO.
SHIPBUILDERS
PORT-GLASGOW.

24th Aug. 1887-

© 2007 Lloyd's Register Foundation

2/8

01/12/2012
01/12/2012

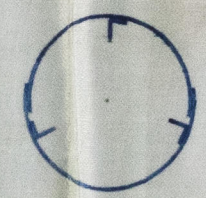

Wm 37-026


28. 4p. 80. dt. 58.