


25.7.84

S.S. "Hisanga":  
Grk. Rept. No. 9428

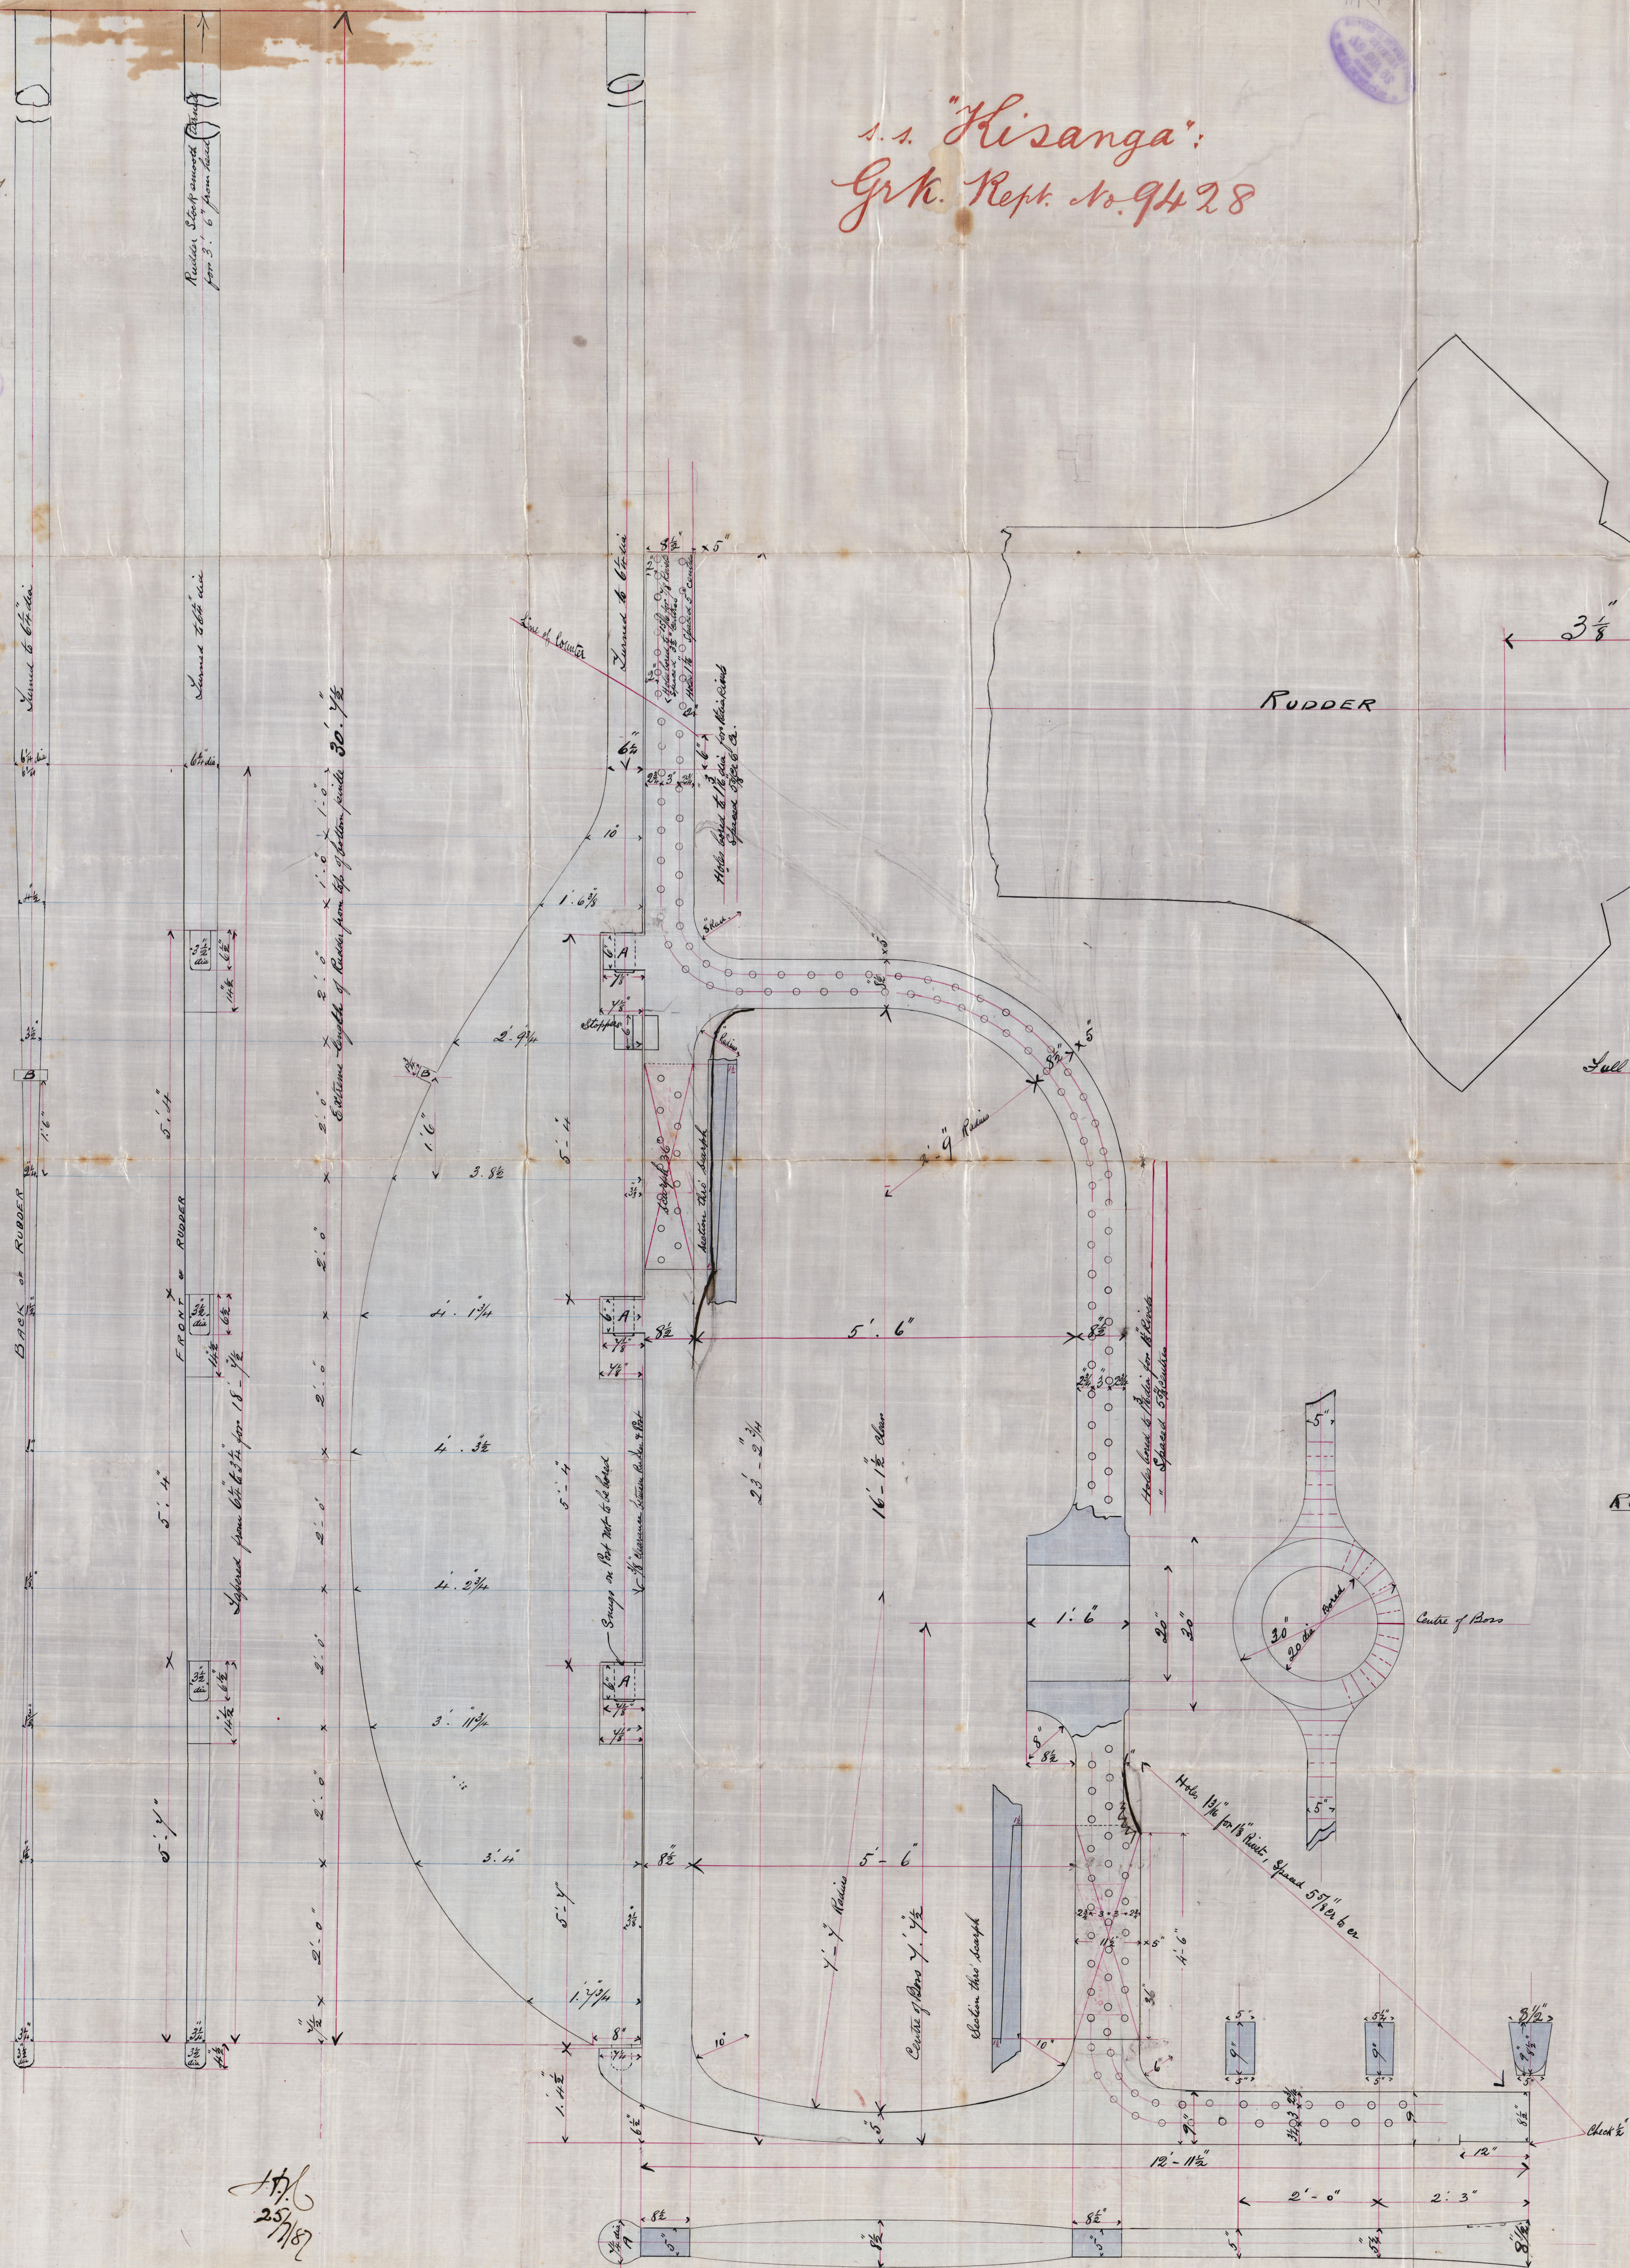


Full Sized Sketch of Rudder Steppings  
steppings 6" deep

RUDDER & STERN FRAMES  
S.S. No. 8/C  
Scale 1" = 1'0"

21-7-84

17/6  
25/18



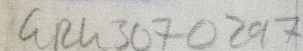

*[Handwritten notes in cursive script, likely bleed-through from the reverse side.]*

25th Nov 1882



18/11/11



© 2020

Lloyd's Register  
Foundation