


30.6.87.

S. S. "Kisanga":  
Jrk. Rept. No. 9428

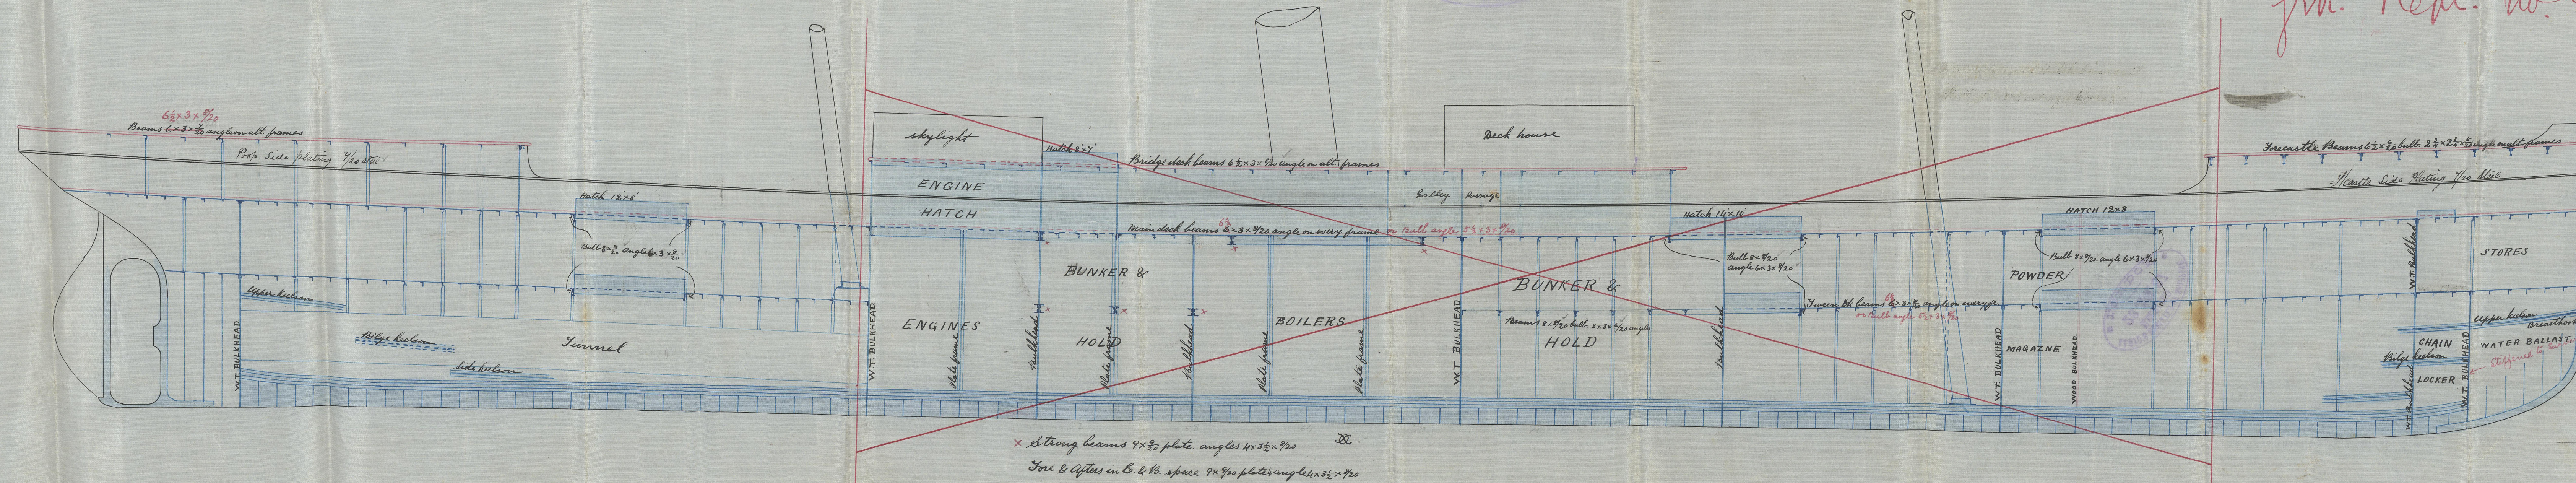

Steel. S. S. No 8/C.  
to class 100 A1 @ Lloyds  
 $263.5 \times 34 \times 20.3$   
Scale  $\frac{1}{8}'' = 1 \text{ foot.}$

23. 6.



