



30.6.87

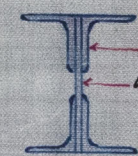

Section of Strong Beam and
Longitudinal Girder in E & B Room

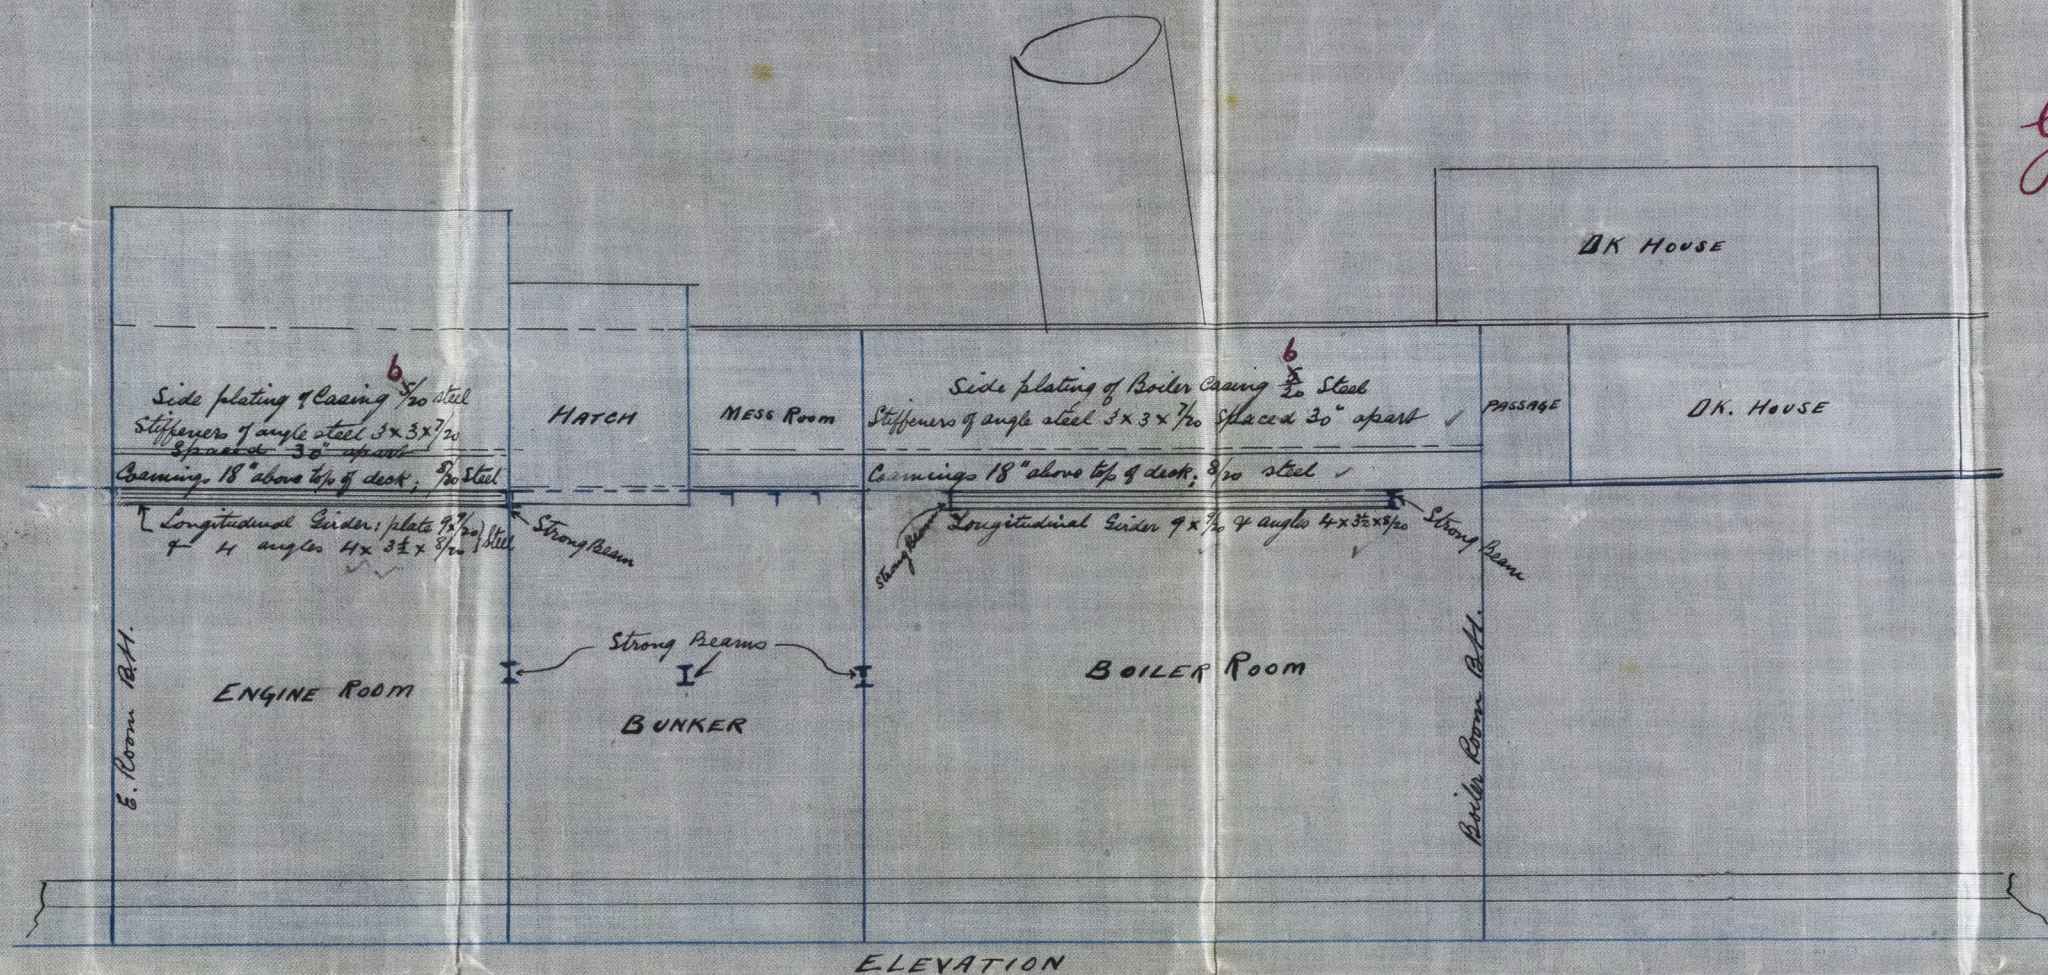

s.s. "Hisanga":
Grk. Kept. No. 9428.

ARRANGEMENT OF ENGINE & BOILER CASINGS
OF STEEL S.S. N° 8/0
Scale $\frac{1}{4}$ " = 1 foot

23.6.87

Handwritten signature

