



*Greenwood Report 22 42 28*  
*to J. L. Thompson*

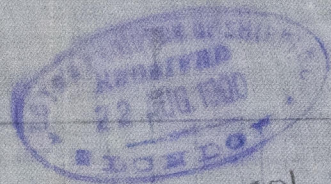

ARL307-0301

 



JOHN REID & CO

BURT OLD TOWN

*Handwritten signature and date: 1887*



S. S. "Kisanga"  
Greenock Report No. 9428

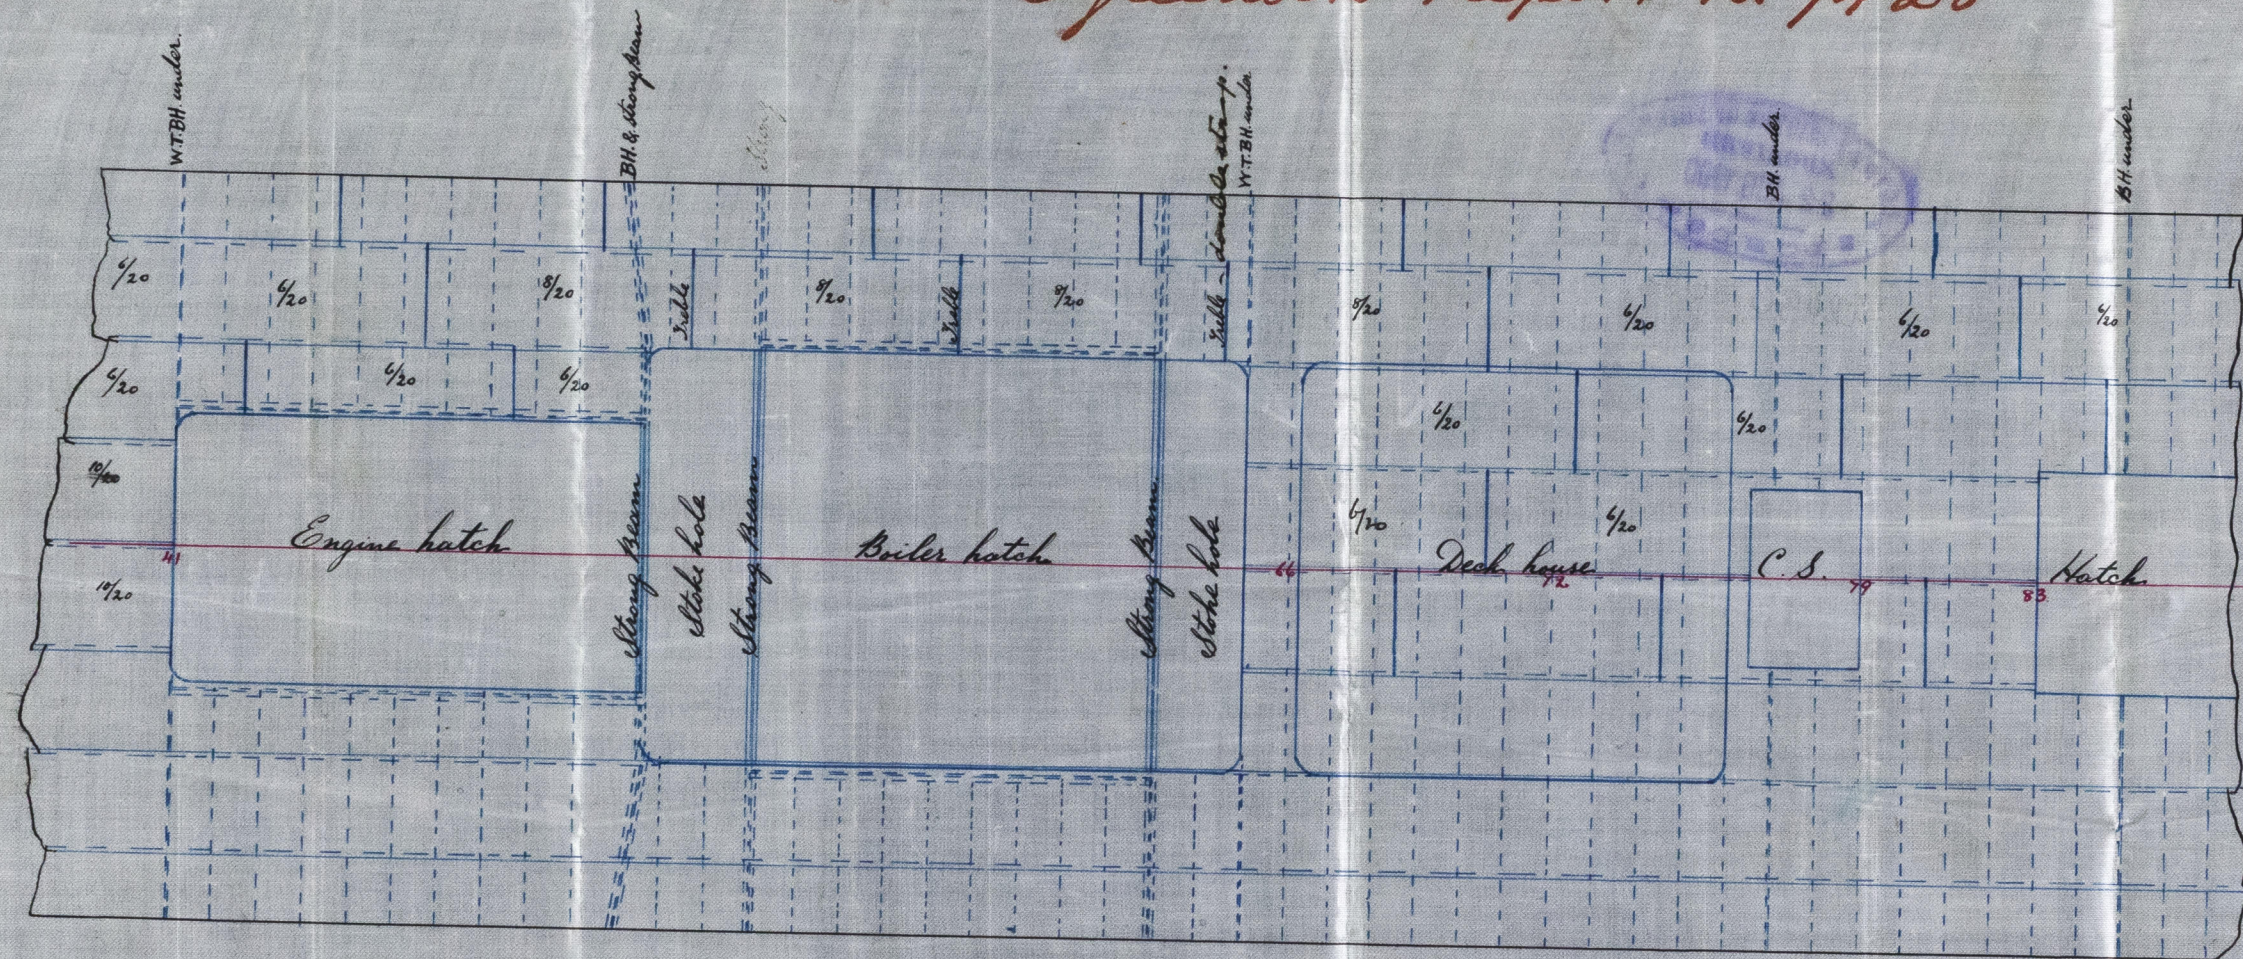

Amended  
Plan of Boiler Openings  
Steel S. S. & C.  
Scale  $\frac{1}{8}'' = 1 \text{ foot}$

JOHN REID & CO  
SHIPBUILDERS

PORT-GLASGOW

22<sup>nd</sup> Aug. 1887.

134

G. S.  
25 Aug. '07

© 2019

Lloyd's Register  
Foundation

APL 307-030