

# Lloyd's Register of British and Foreign Shipping.

(Report on Vessel No. 9449 Port Greenock)  
"Sutlej"

No. 1304

## SHIP FORGINGS OR CASTINGS.

I have to report that the undermentioned Iron or Steel Forgings or Castings, manufactured by Messrs F. McIntyre & Co. of Barrhead, for the Vessel No. 164, being built by Messrs Russell & Co of Port Glasgow, have been inspected by me as set forth below, and found to be, so far as can be seen, sound.

The words FORGINGS or CASTINGS, IRON or STEEL, should be struck out if not applicable.

Mark on Forgings.

Lloyd's  
No. 1304  
G.N.


George Newcomb

Glasgow

14/2/84.

	STERN FRAME.	RUDDER FRAME.	STEM.
Material*	/	<u>Scrap iron</u>	/
How made		<u>Forged</u>	
Dimensions		<u>6 1/4 &amp; 3 1/4</u>	
Progress on Inspection		<u>Smithing.</u>	
Dates when Inspected		<u>26/1/84. 1.11/2/84.</u>	

SKETCHES OF FRAMES SHEWING POSITION AND DESCRIPTION OF WELDS OF FORGINGS, OR PARTICULARS OF TESTS APPLIED TO CASTINGS.

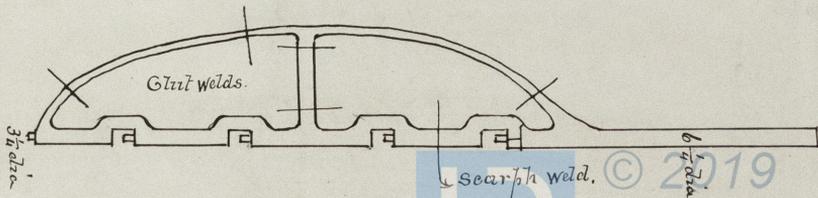

G.N.

\* If of Iron, state whether scrap or puddled iron.

