



Sketch showing temporary division in after tank of *H.M.S. Russell* No. 187 (S.S. "Aldborough").
 with amended pumping arrangement, and additional air pipes.
 C.F. 6/7/88.

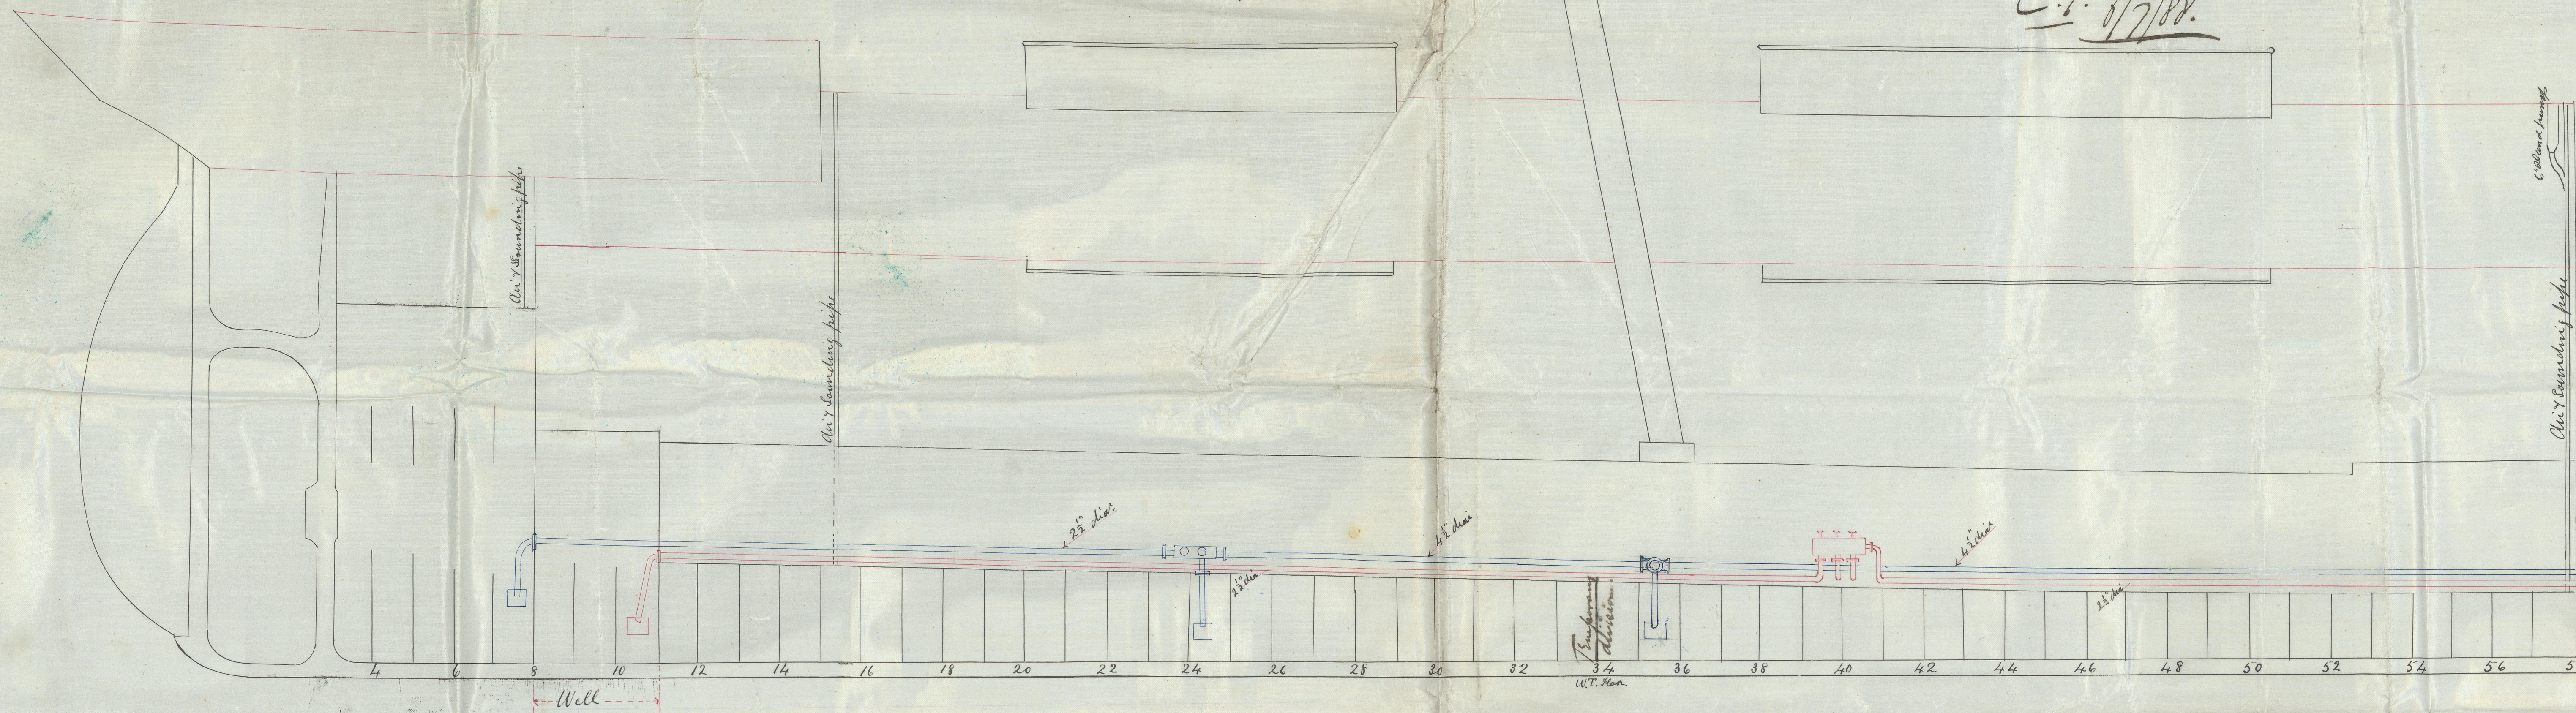



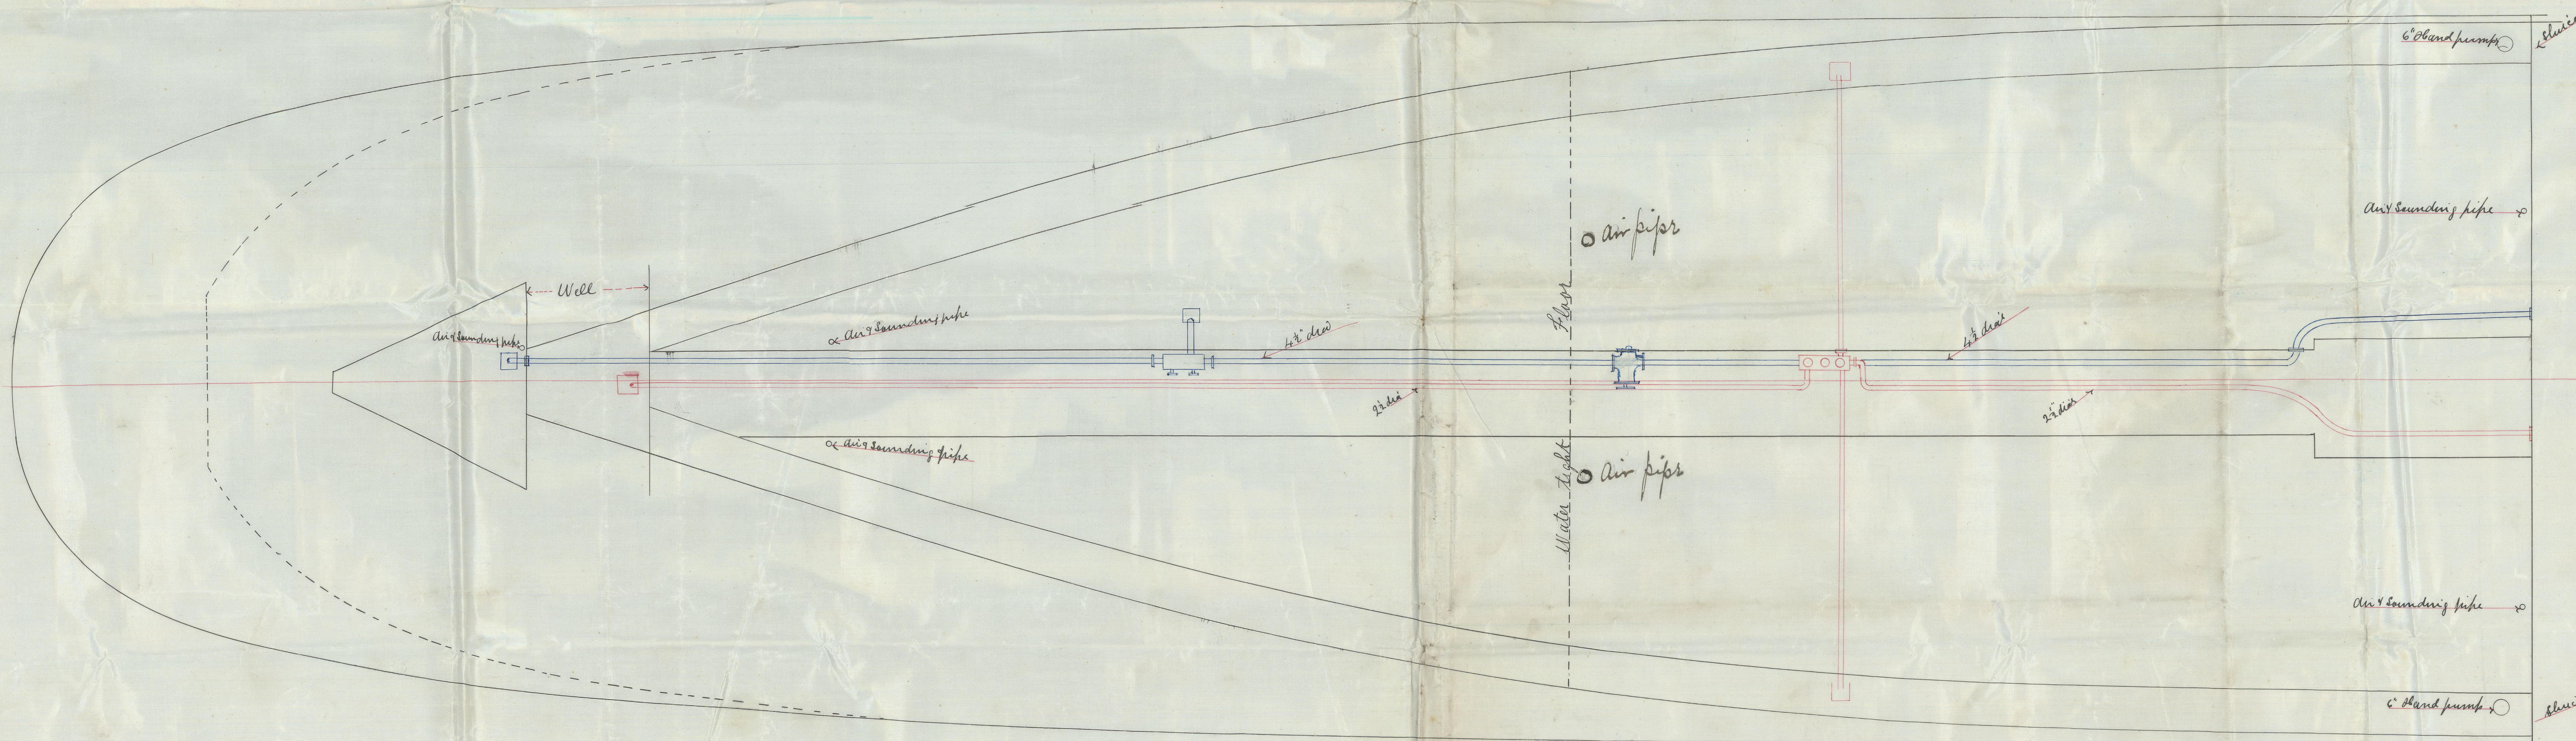

G.R.K. 308-0065