



22.12.89


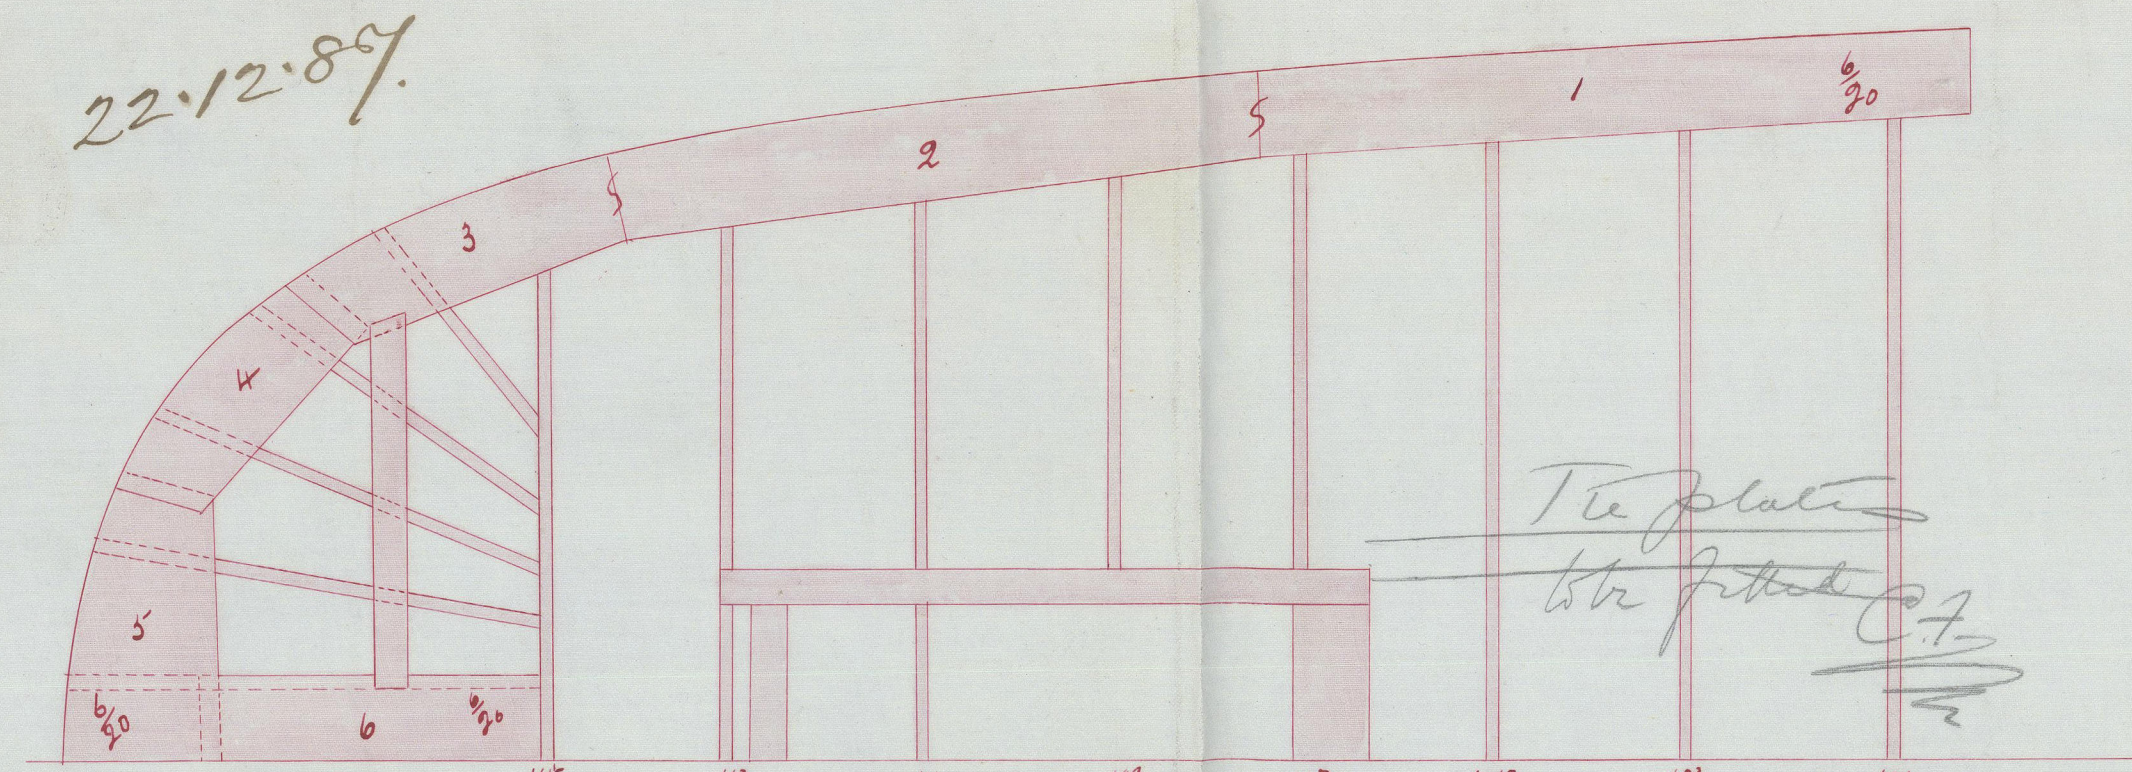


The plan
like fitted

Butts well riveted
Main Deck

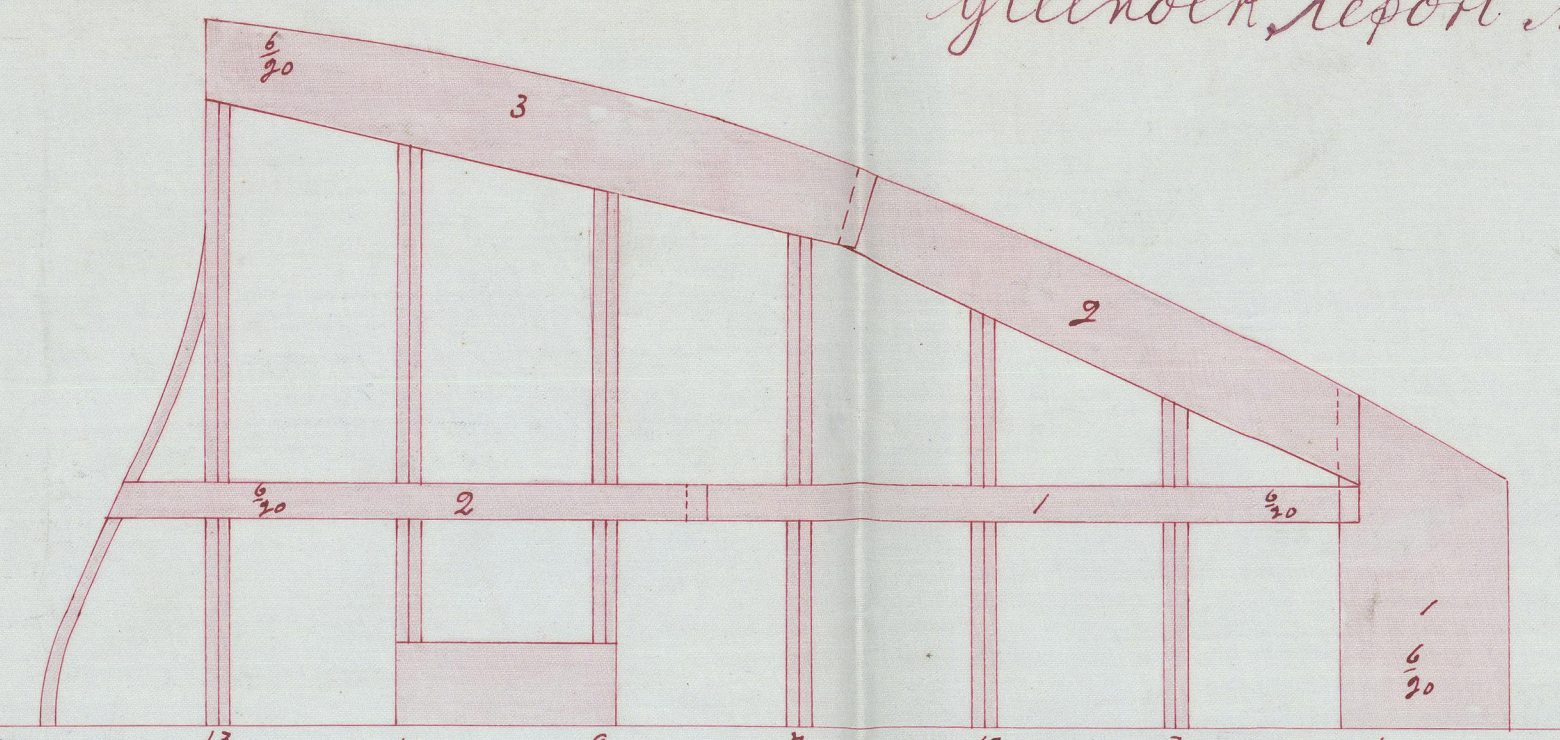

Bk "Harold":
Greenock Report No. 9501.

 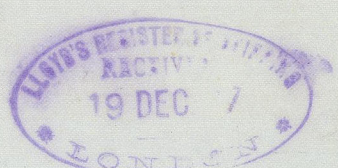


Forecastle

No 234 Steel Barge
228.58 x 36.33 x 23.46



Sween Deck
Stungas overlapped butts

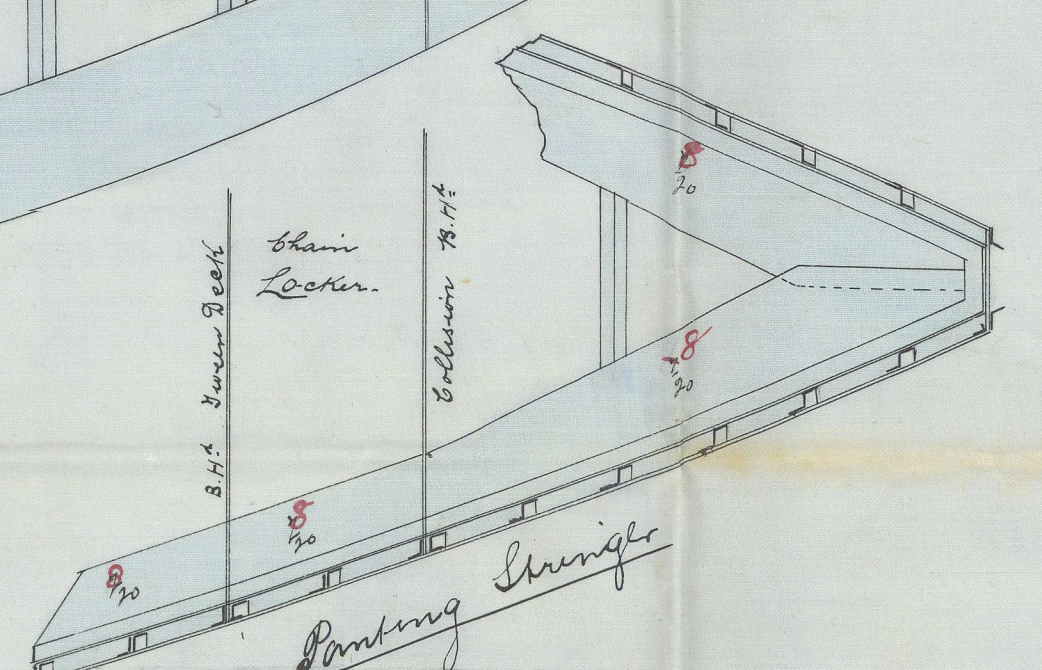

17/12/89