

Greenock Report No. ....



## Numerals & Proportions


$\frac{1}{2}$ Girth	37.04
$\frac{1}{2}$ Breadth	18.16
Depth	23.46
1 <sup>st</sup> Humeral	78.66
	<u>228.583</u>

2<sup>nd</sup> Numeral 17980.358



Breadths to Length 6.28

Depth 9.76

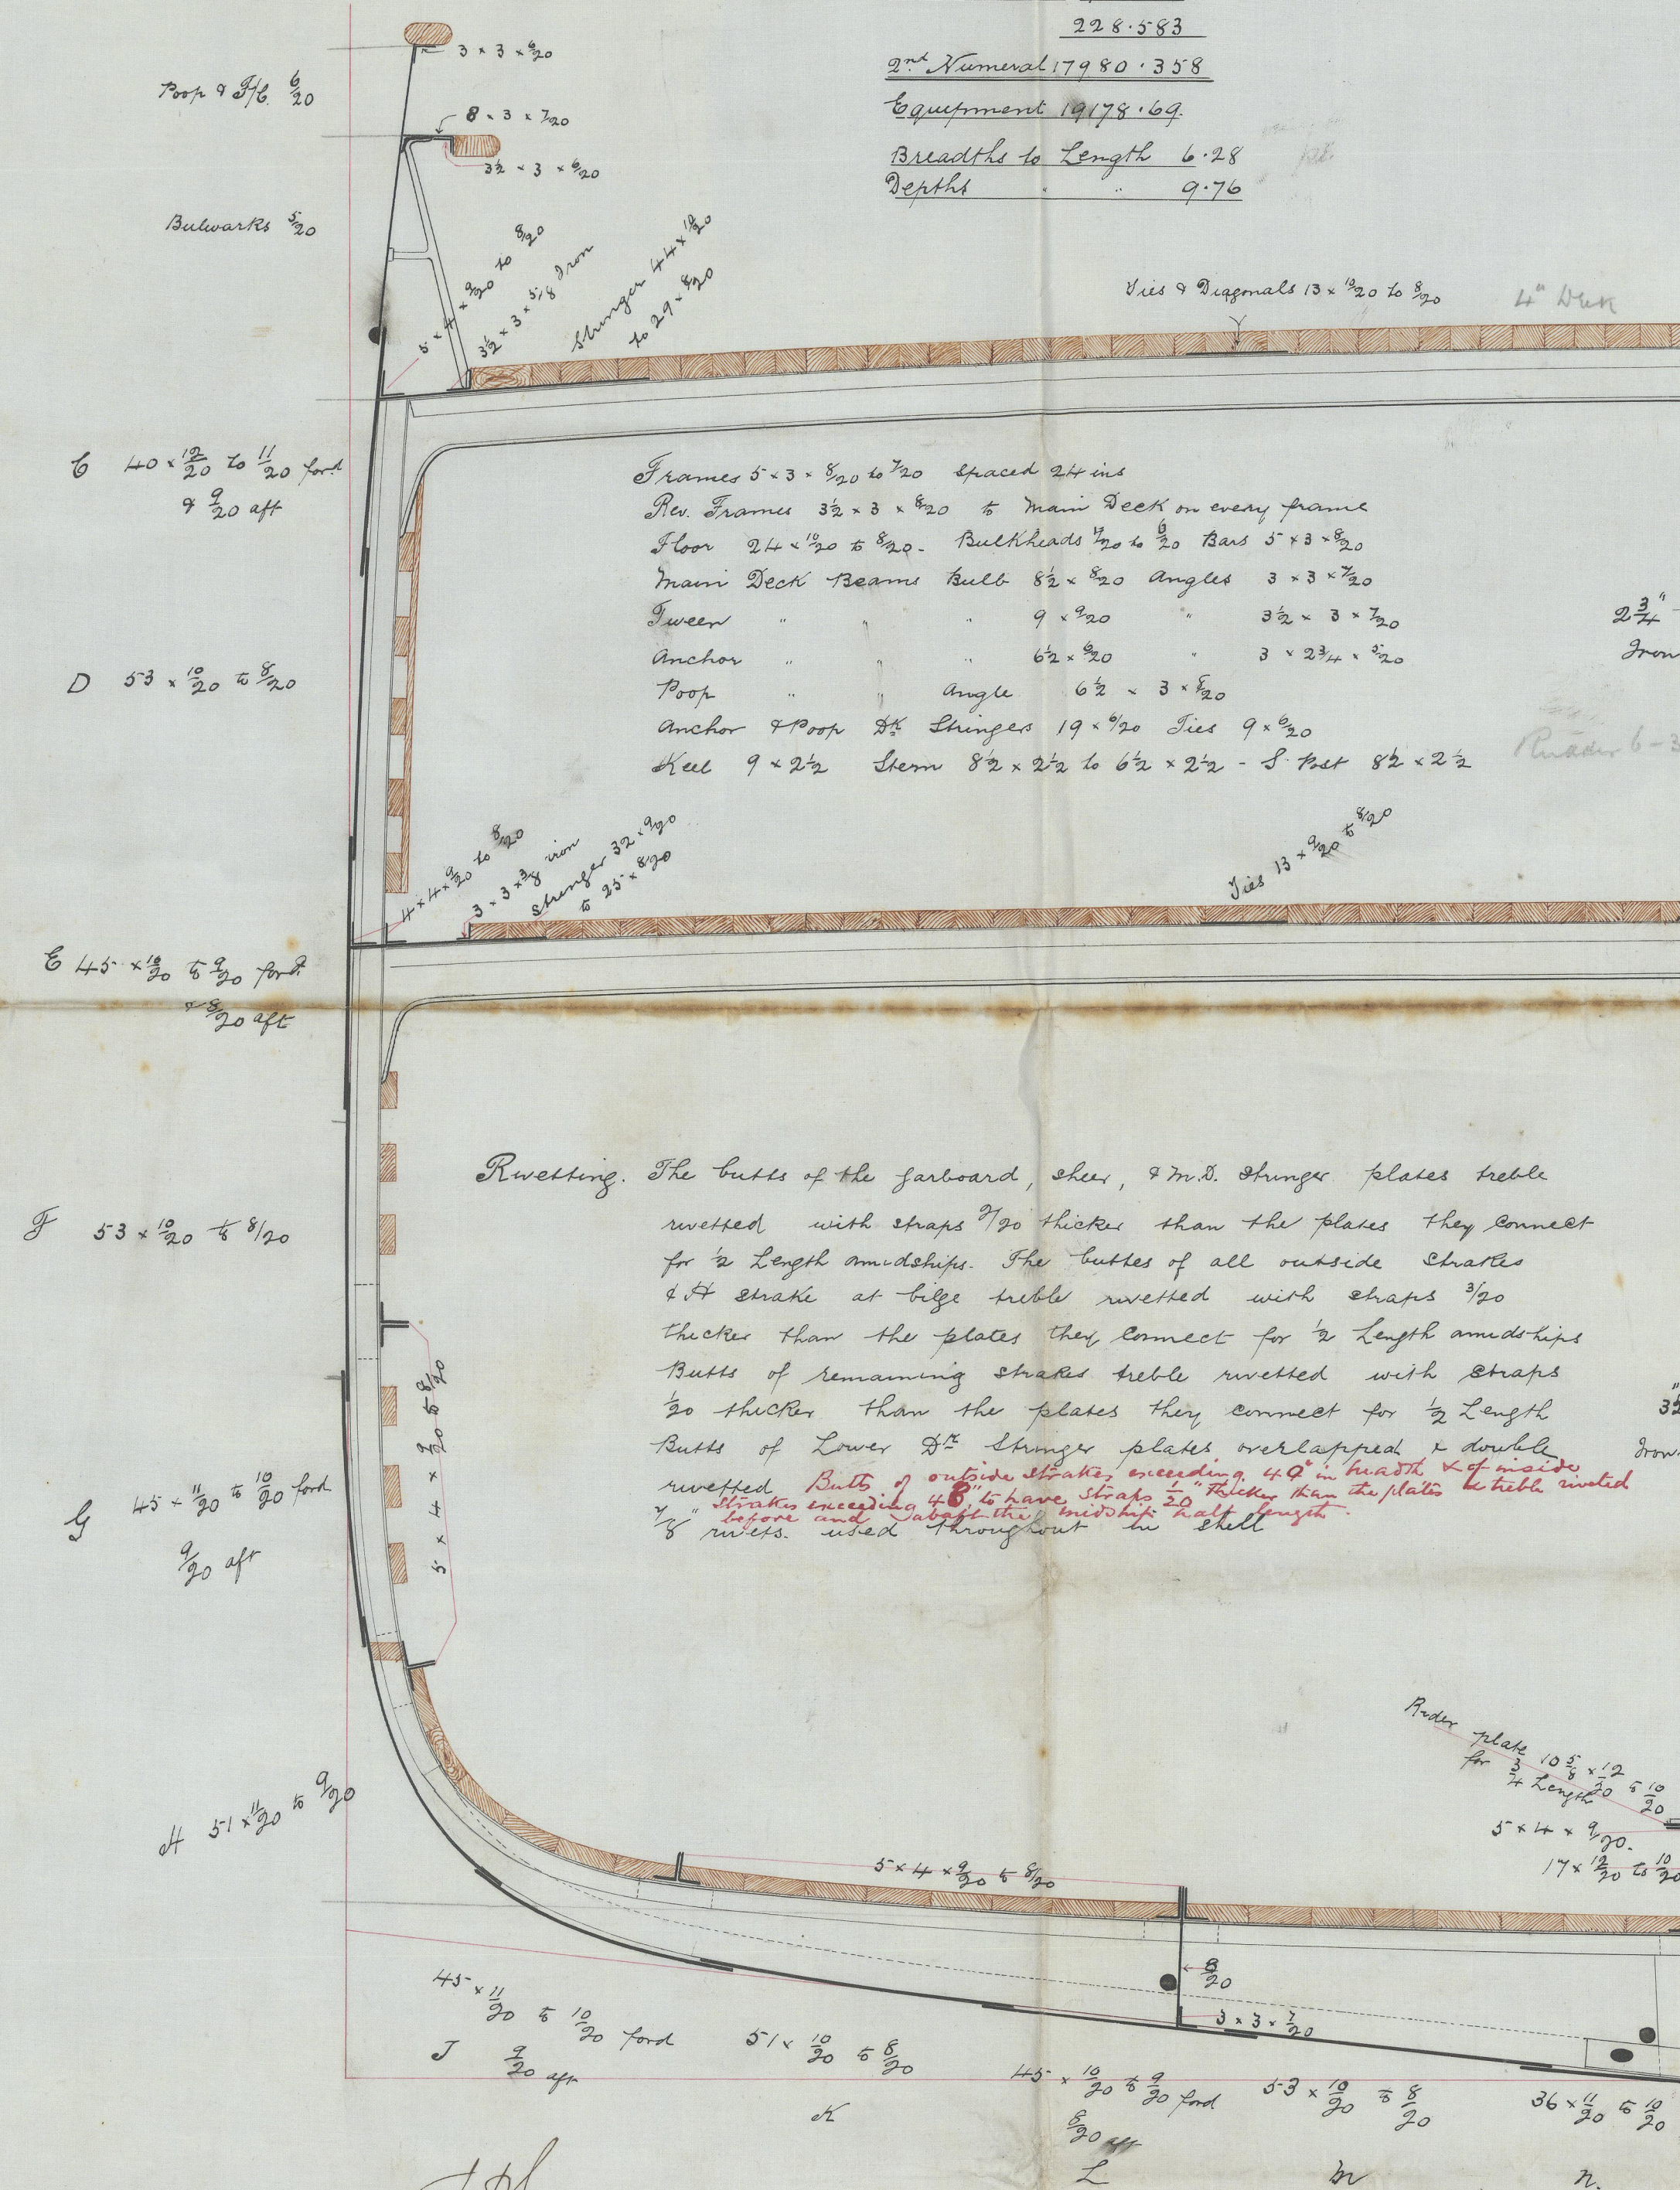

28/12/87

N° 234 Steel Barque
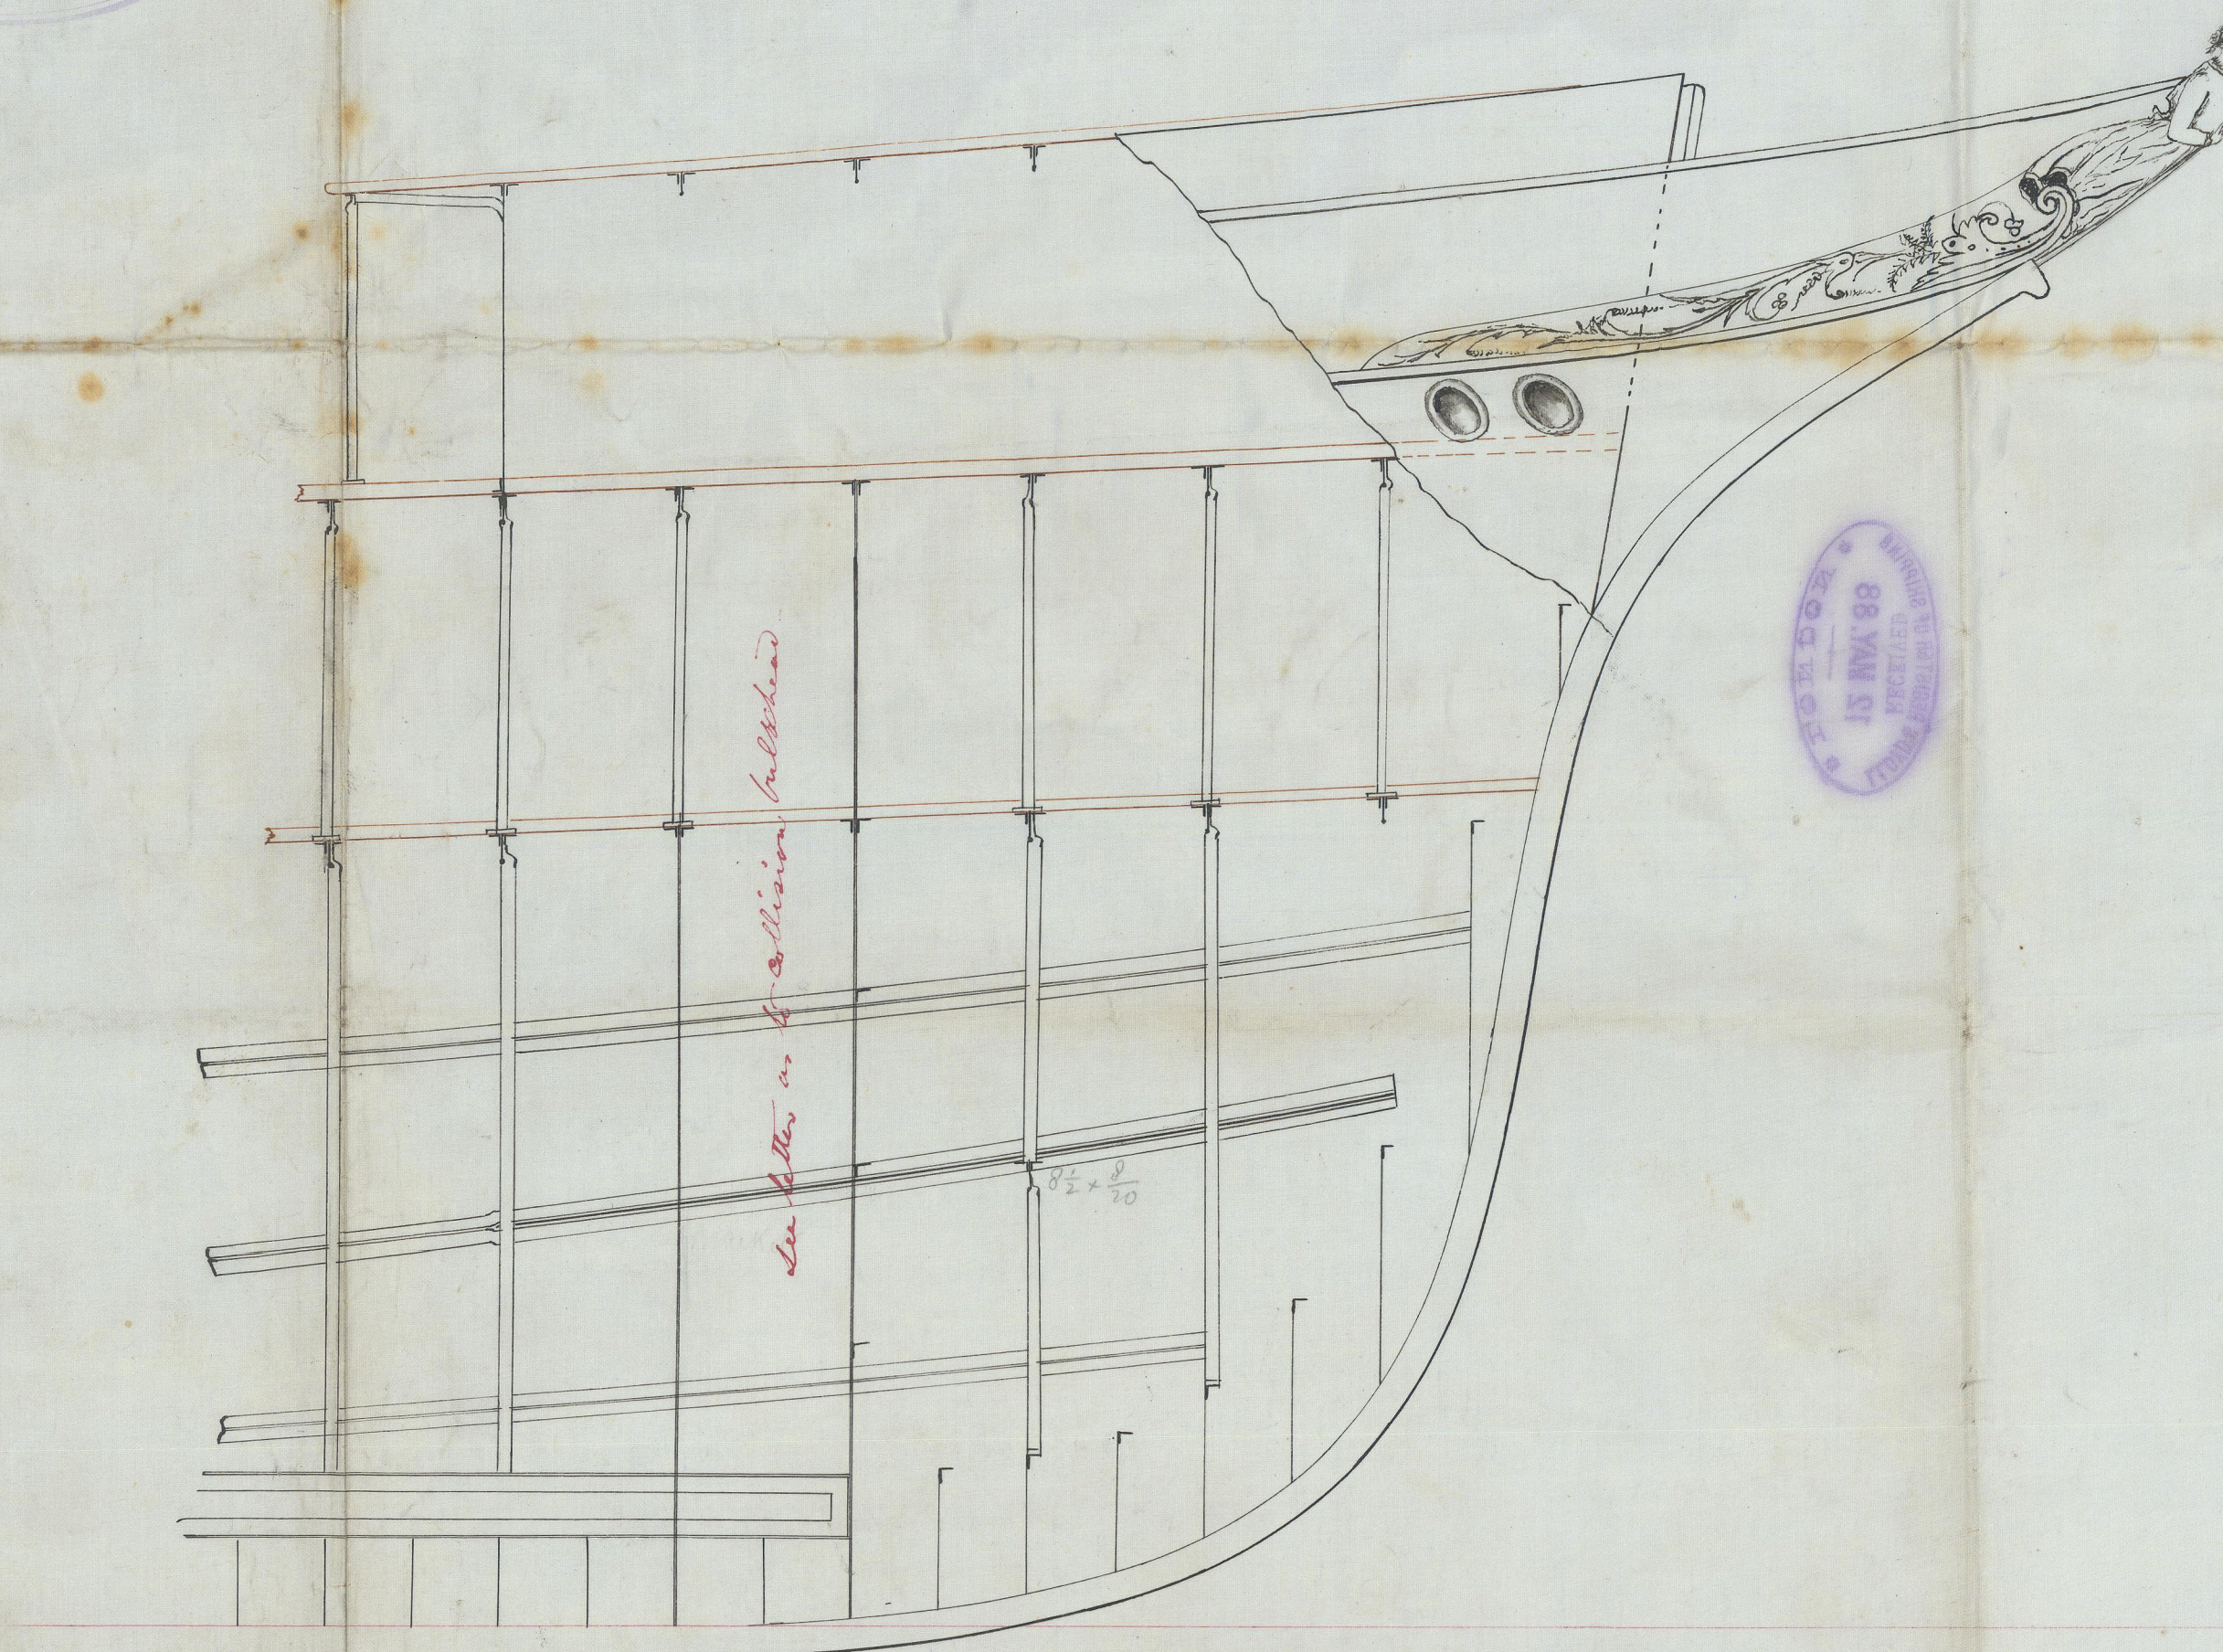
$$-228.58 \times 36 \times 33 \times 23 \cdot 46$$






GRK308-0112



© 2021

Lloyd's Register  
Foundation