



1871


Вх. "Harold": ГРН. Report № 9501.

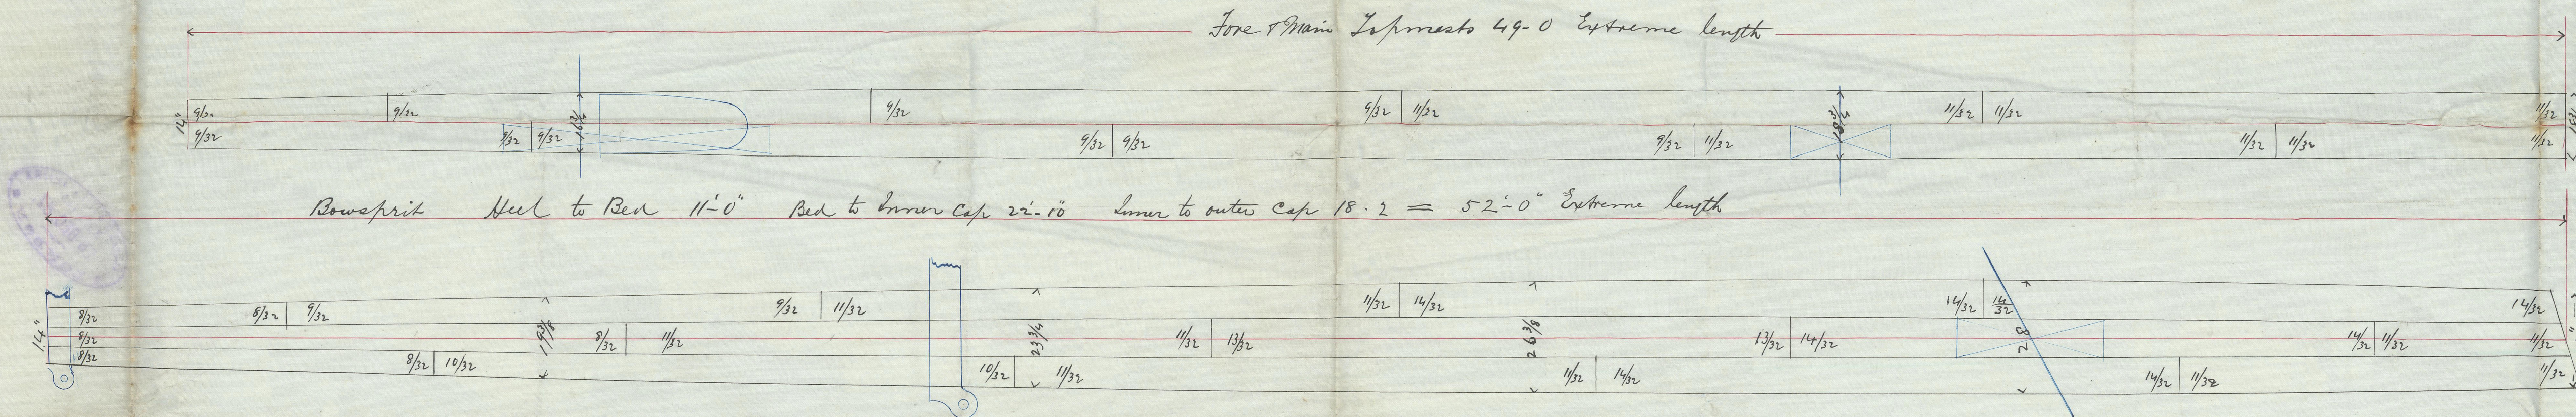

Scale  $\frac{1}{2}$  ins. = 1 ft.

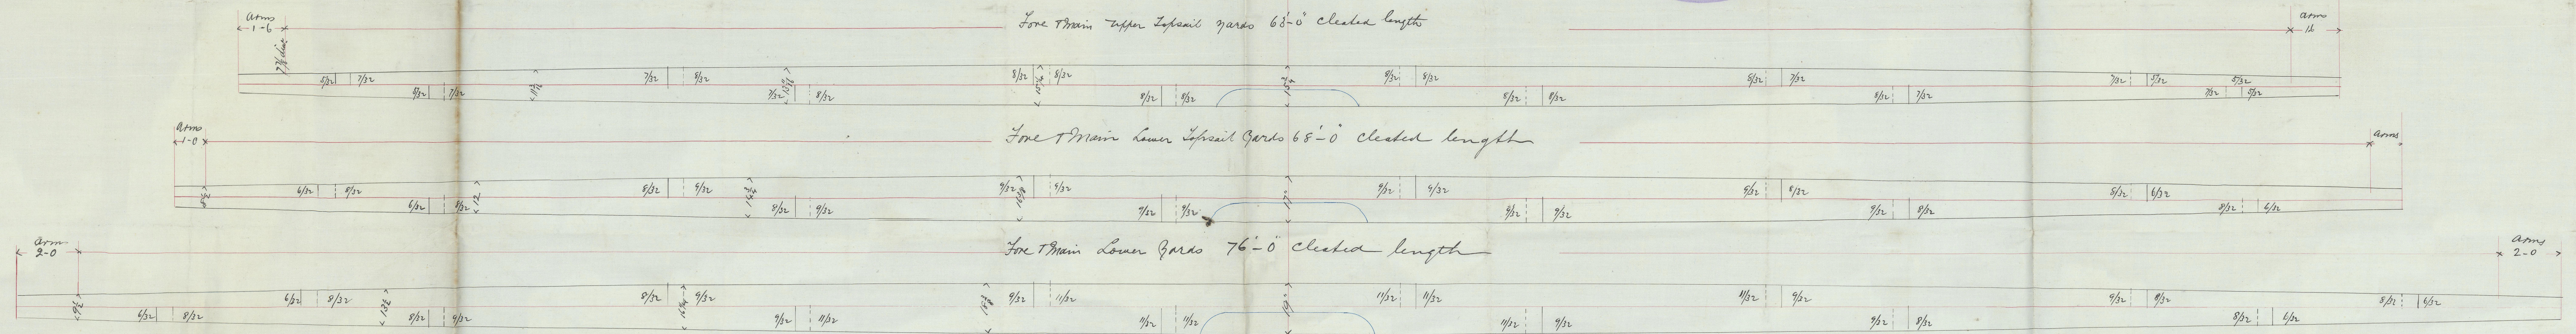

Note - Boreasprint, Fore main & Mizen masts double  
rivetted seams and teeth rivetted both throughout with  
strops outside  $\frac{3}{4}$  in thicker than plate —  
Topmasts Seams Single rivetted and Butts both rivetted  
with strops inside  $\frac{3}{4}$  in thicker than plate —  
Yards, Seams Single rivetted, Butts overlapped and  
teeth rivetted throughout —  
Boreasprint to have 4 angle 35-0 x 4 x 3 x  $\frac{5}{16}$   
no angles in masts or yards —

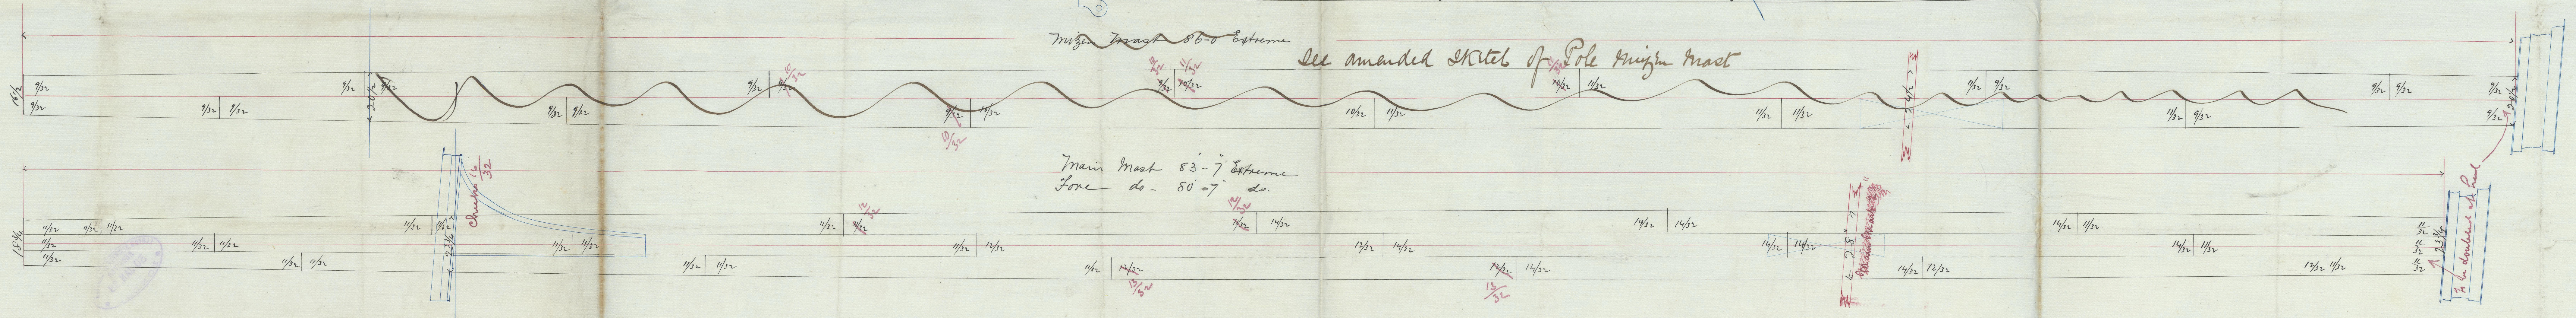




307/2/87



Bk Harold Grk Report 9501.

18.51.08  
88.1.18

GRK 308-0114

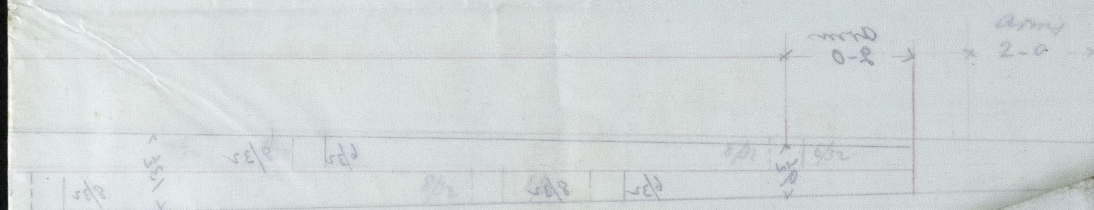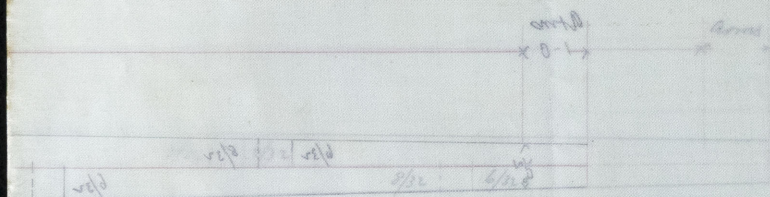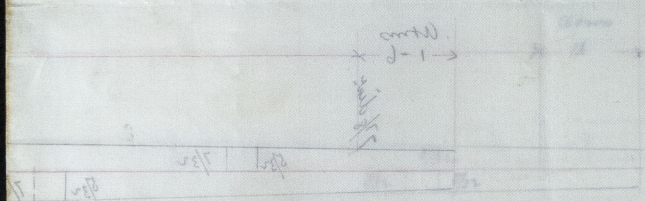

Note - Bowprit, Stern plate and Butts with rivets



© 2021

Lloyd's Register  
Foundation