

Lloyd's Register of British and Foreign Shipping.

(Report on Vessel No. 9501 Port Greenock)

No. 1609. SHIP FORGINGS OR CASTINGS.

I have to report that the undermentioned Iron or ~~Steel~~ Forgings or Castings, manufactured by The Irvine Forge Co. of Irvine. for the Vessel No. 234, being built by Messrs Robert Duncan & Co. of Port Glasgow. have been inspected by me as set forth below, and found to be, so far as can be seen, sound and efficient.

on Forgings.

Lloyd's
No. 1609
G.N.


George Newcomb.

Glasgow.

10/4/88.

	STERN FRAME.	RUDDER FRAME.	STEM.
Material*	/	Scrap iron.	/
Made		Forged.	
Dimensions		6 1/2" x 3 3/4" dia	
Tests on Inspection		Forging & smithing.	
When Inspected		28/2/88. 2.24/3/88. 5.9/4/88.	

ETCHES OF FRAMES SHEWING POSITION AND DESCRIPTION OF WELDS OF FORGINGS, OR PARTICULARS OF TESTS APPLIED TO CASTINGS.

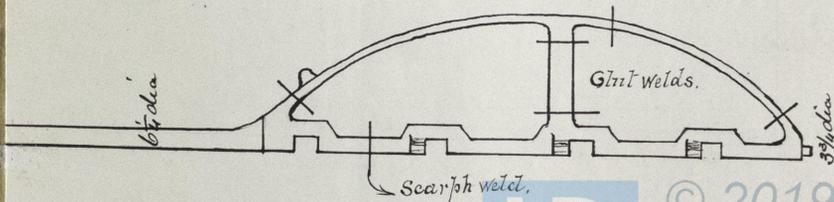

© 2019

Lloyd's Register
Foundation

* If of Iron, state whether scrap or puddled iron.