Barque "Adderley"; Greenock Rept. No. 9486

" "Banklands" " " " 9513

Main Deck Plan of Steel Barque No 8/12

Scale ½" = 1 foot

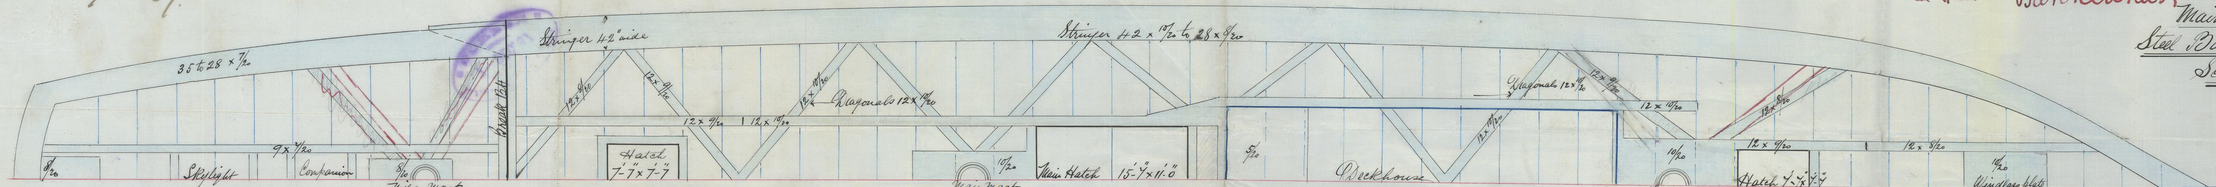

9.12.87

9/12/87 Ok

3rd Dec. 1887

© 2021 Lloyd's Register Foundation

GRK308-0126