


1.12.27

bk. "Adderley"; Greenock Report No. 9486.
 " "Banklands"; " " 9513

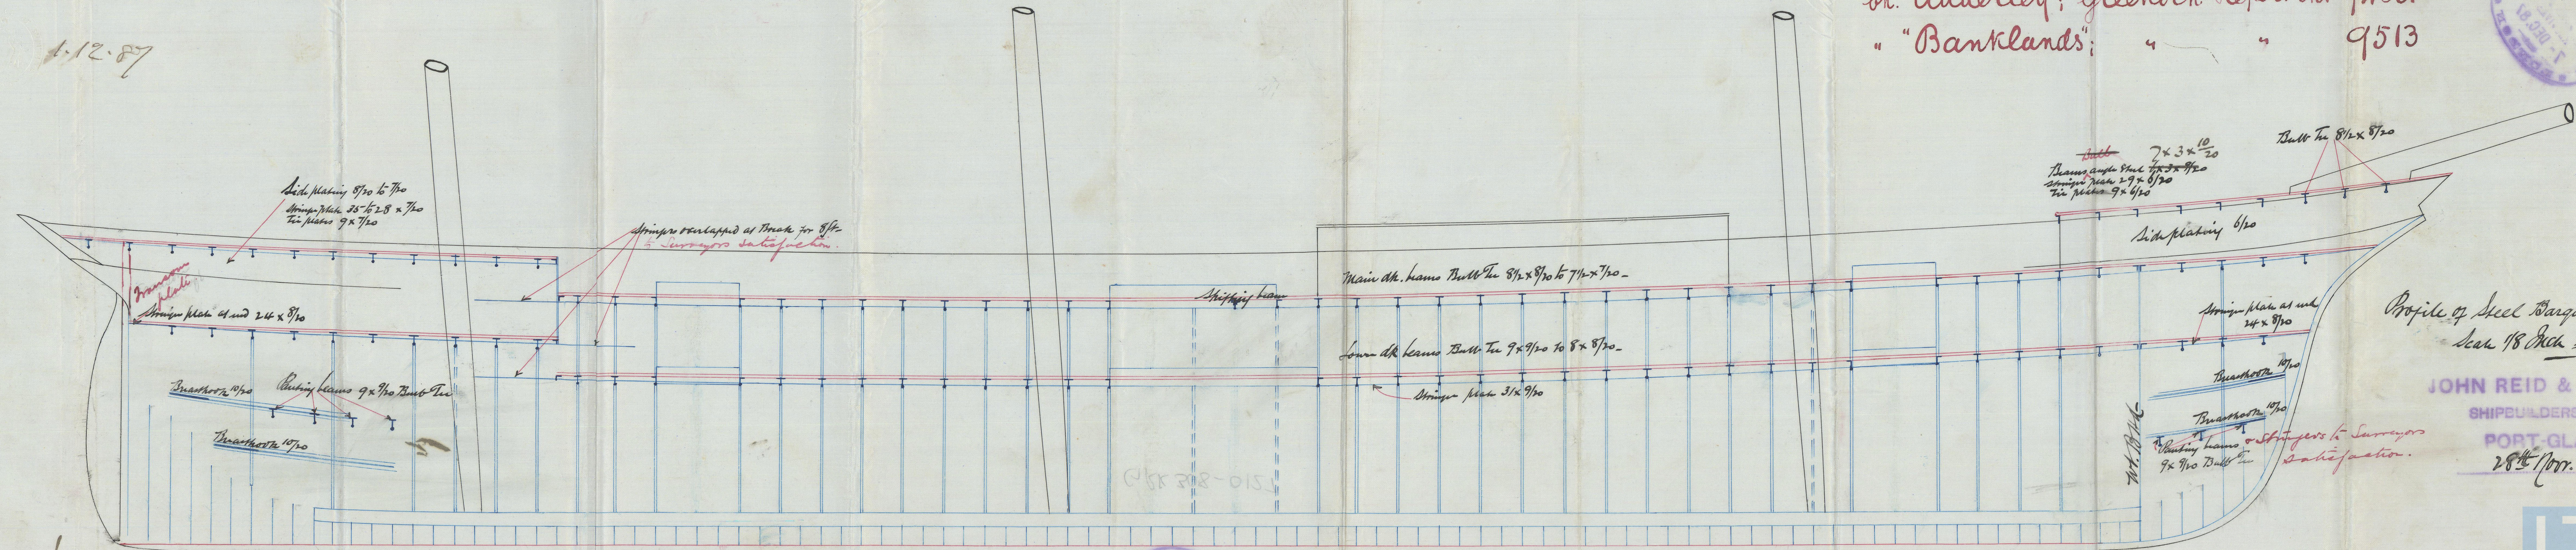

Profile of Steel Barge No 87 D.
Scale 1/8 Inch = 1 Foot

JOHN REID & CO.
SHIPBUILDERS,
PORT-GLASGOW.
28th Nov. 1887-

J.H.L.
30/11/82



© 2021
Lloyd's Register
Foundation

GRK 308-0127