


Ok. "Adderley": Greenock Report No. 9486.
"Banklands": " " " " 9513.

3.1.88.

FORE MAIN & MIZEN MASTS
2 PLATES IN ROUND

Butt straps of lower masts, outside.

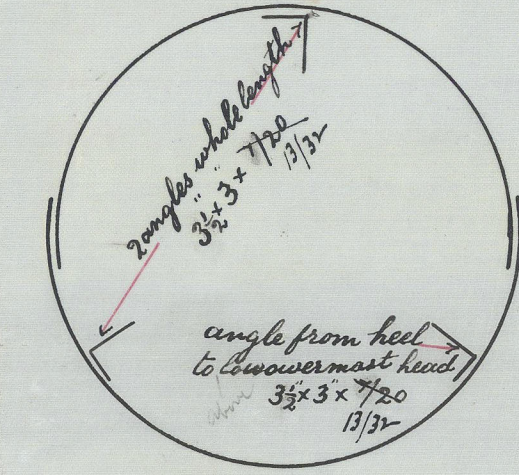

STEEL
MASTS & YARDS
OF
BARQUE No 8/D 48/15


SCALE
MASTS & BOWSPRIT: LENGTH 1/4" = 1 FOOT
" " " DIAMETER 1/8" = 1 FOOT
YARDS " " " 1/4" = 1 FOOT

JOHN REID & CO
SHIPBUILDERS
PORT GLASGOW
15, QUEEN ST.


FORE MAST

MAIN MAST



MIZEN MAST

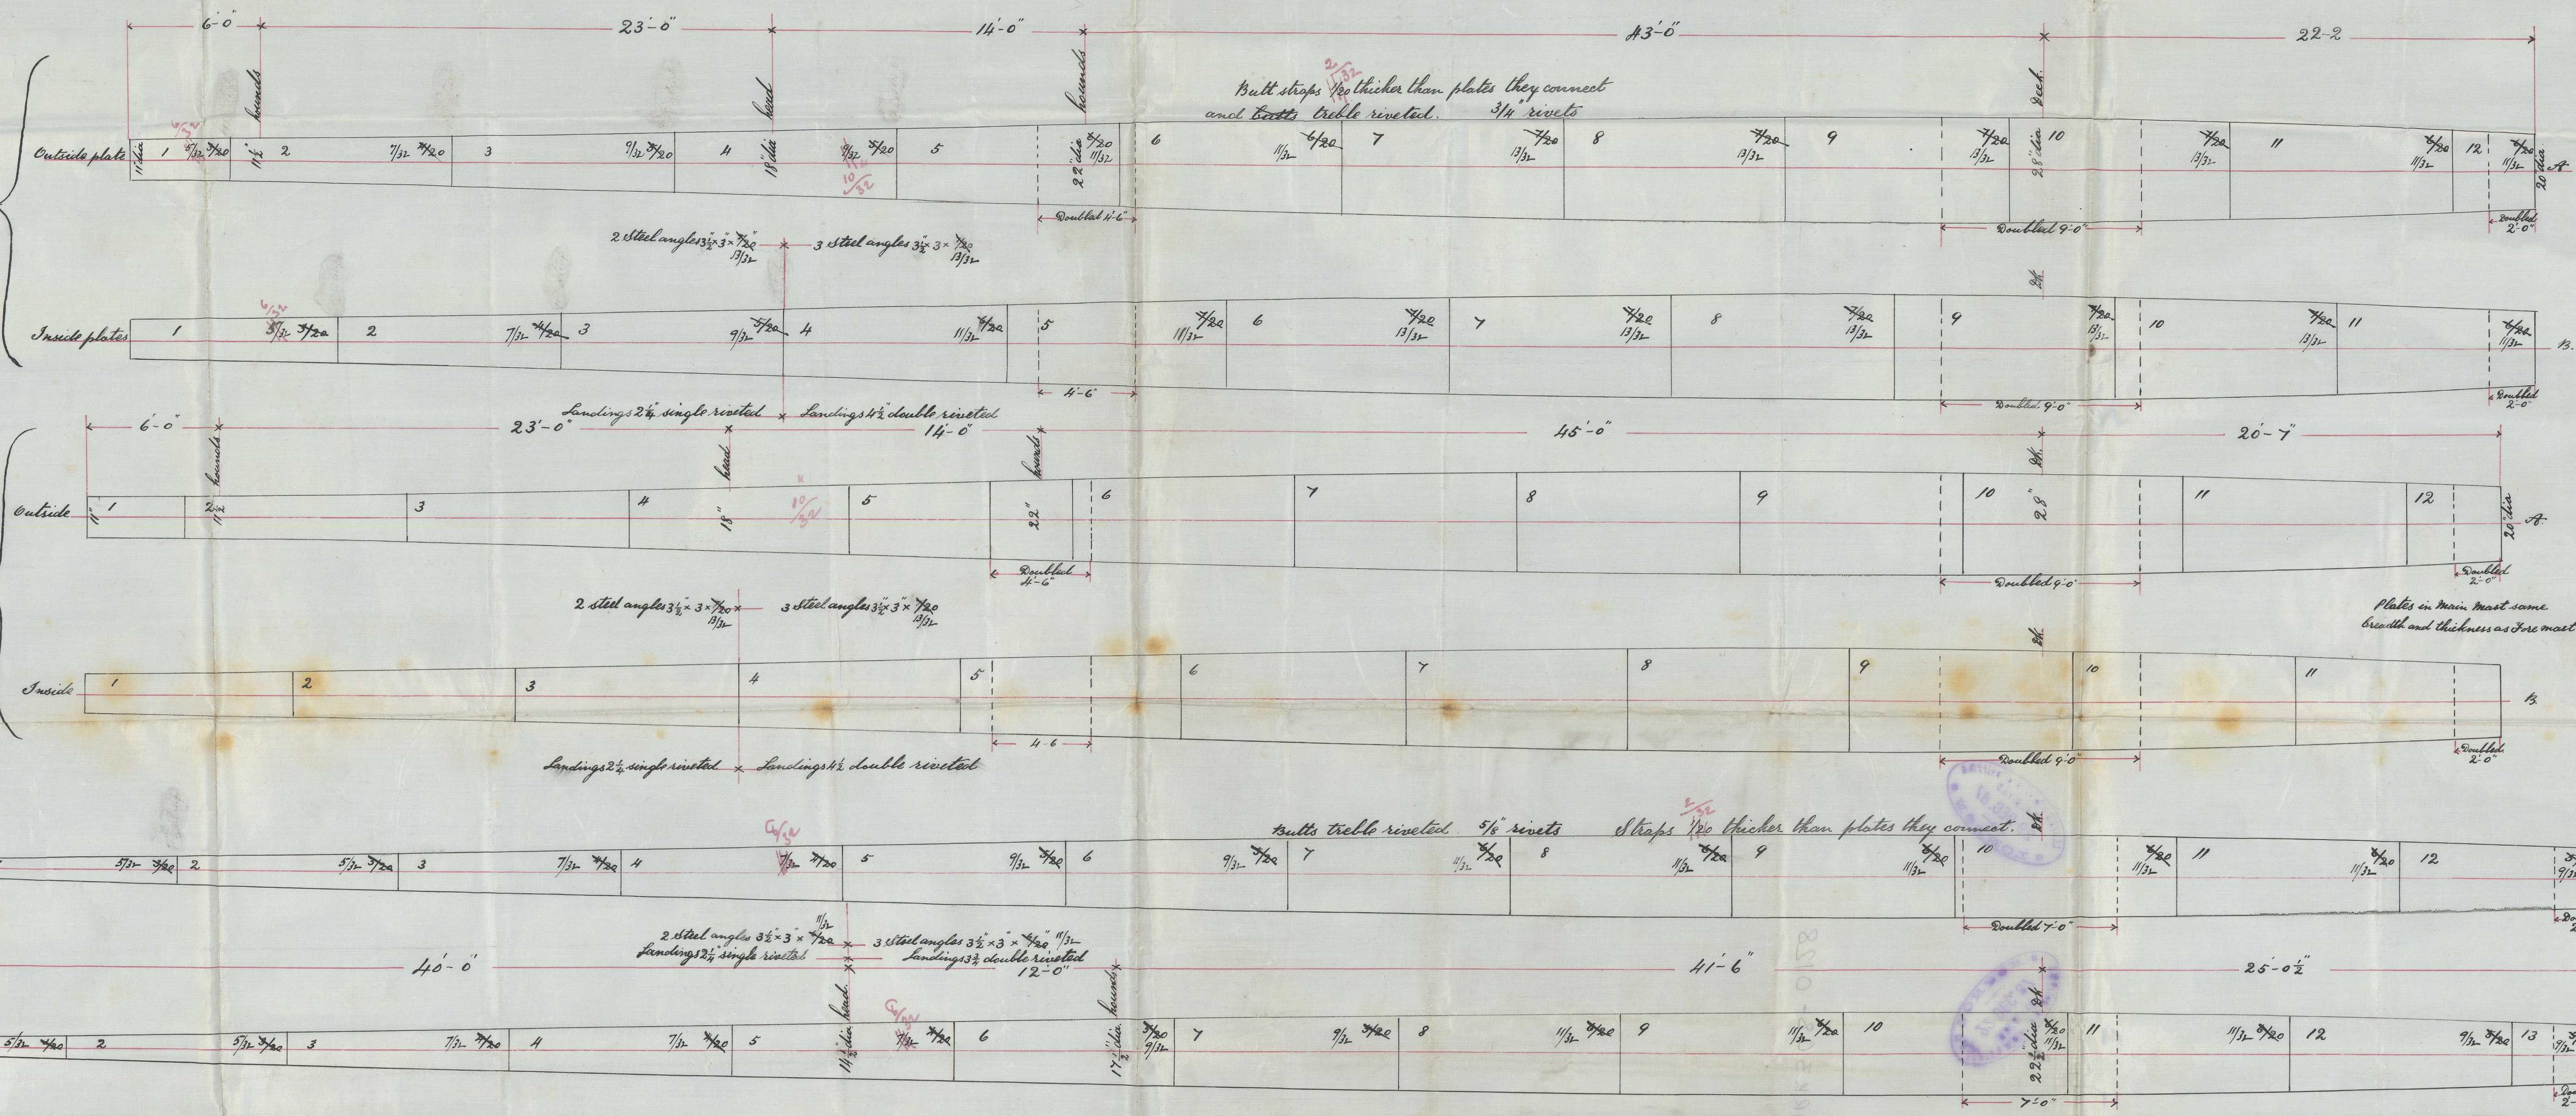

Bowsprit
Bed 11'-0"
Outside 37'-0"
Overall 48'-0"

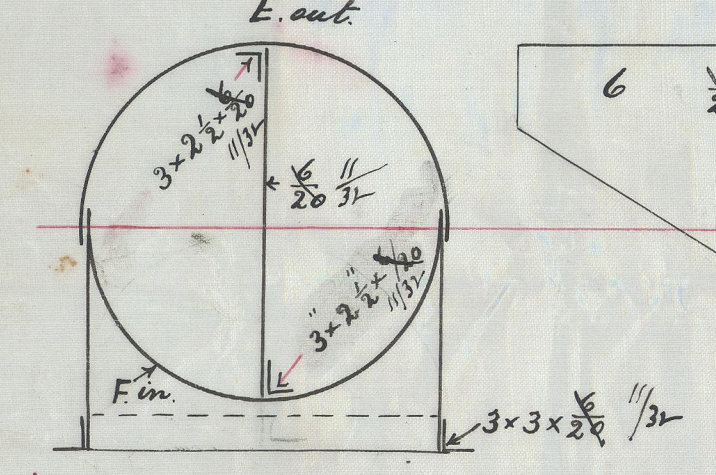

The attachment of bowsprit at heel to be to the satisfaction of the Surveyors

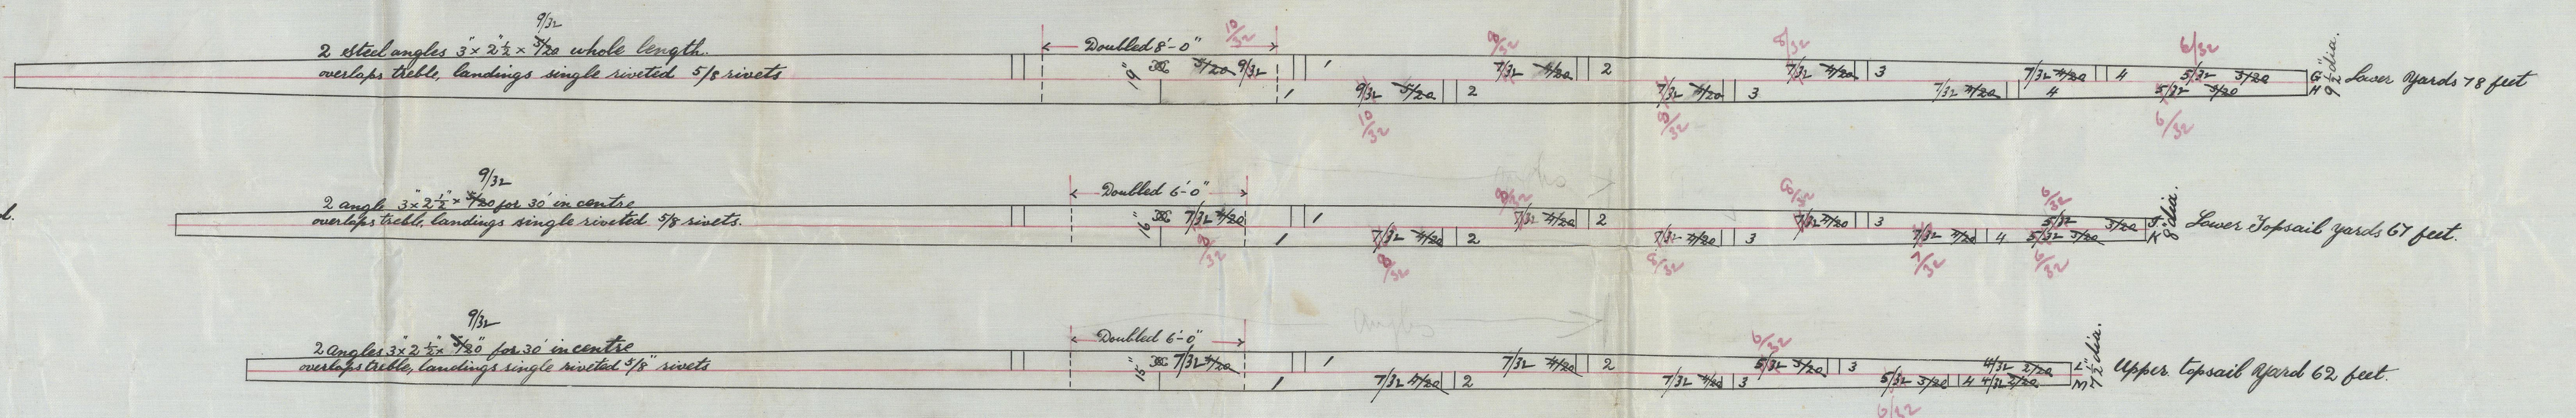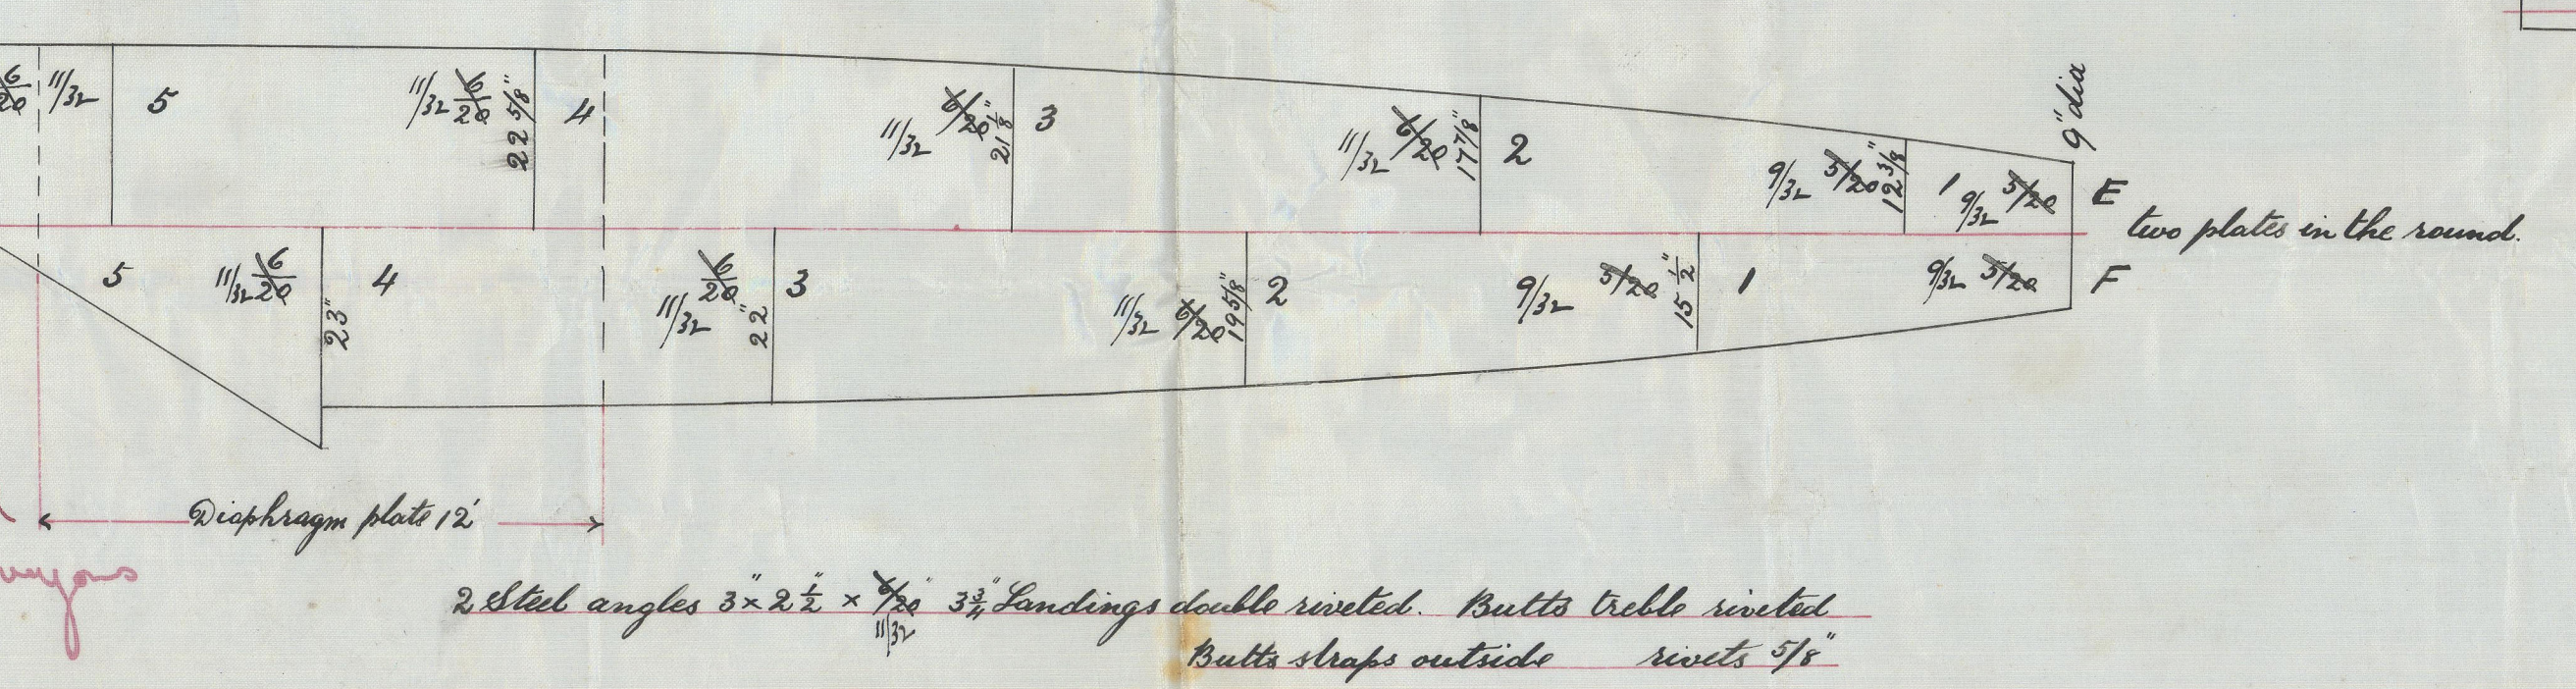



GRK308-0128



© 2021

Lloyd's Register
Foundation