
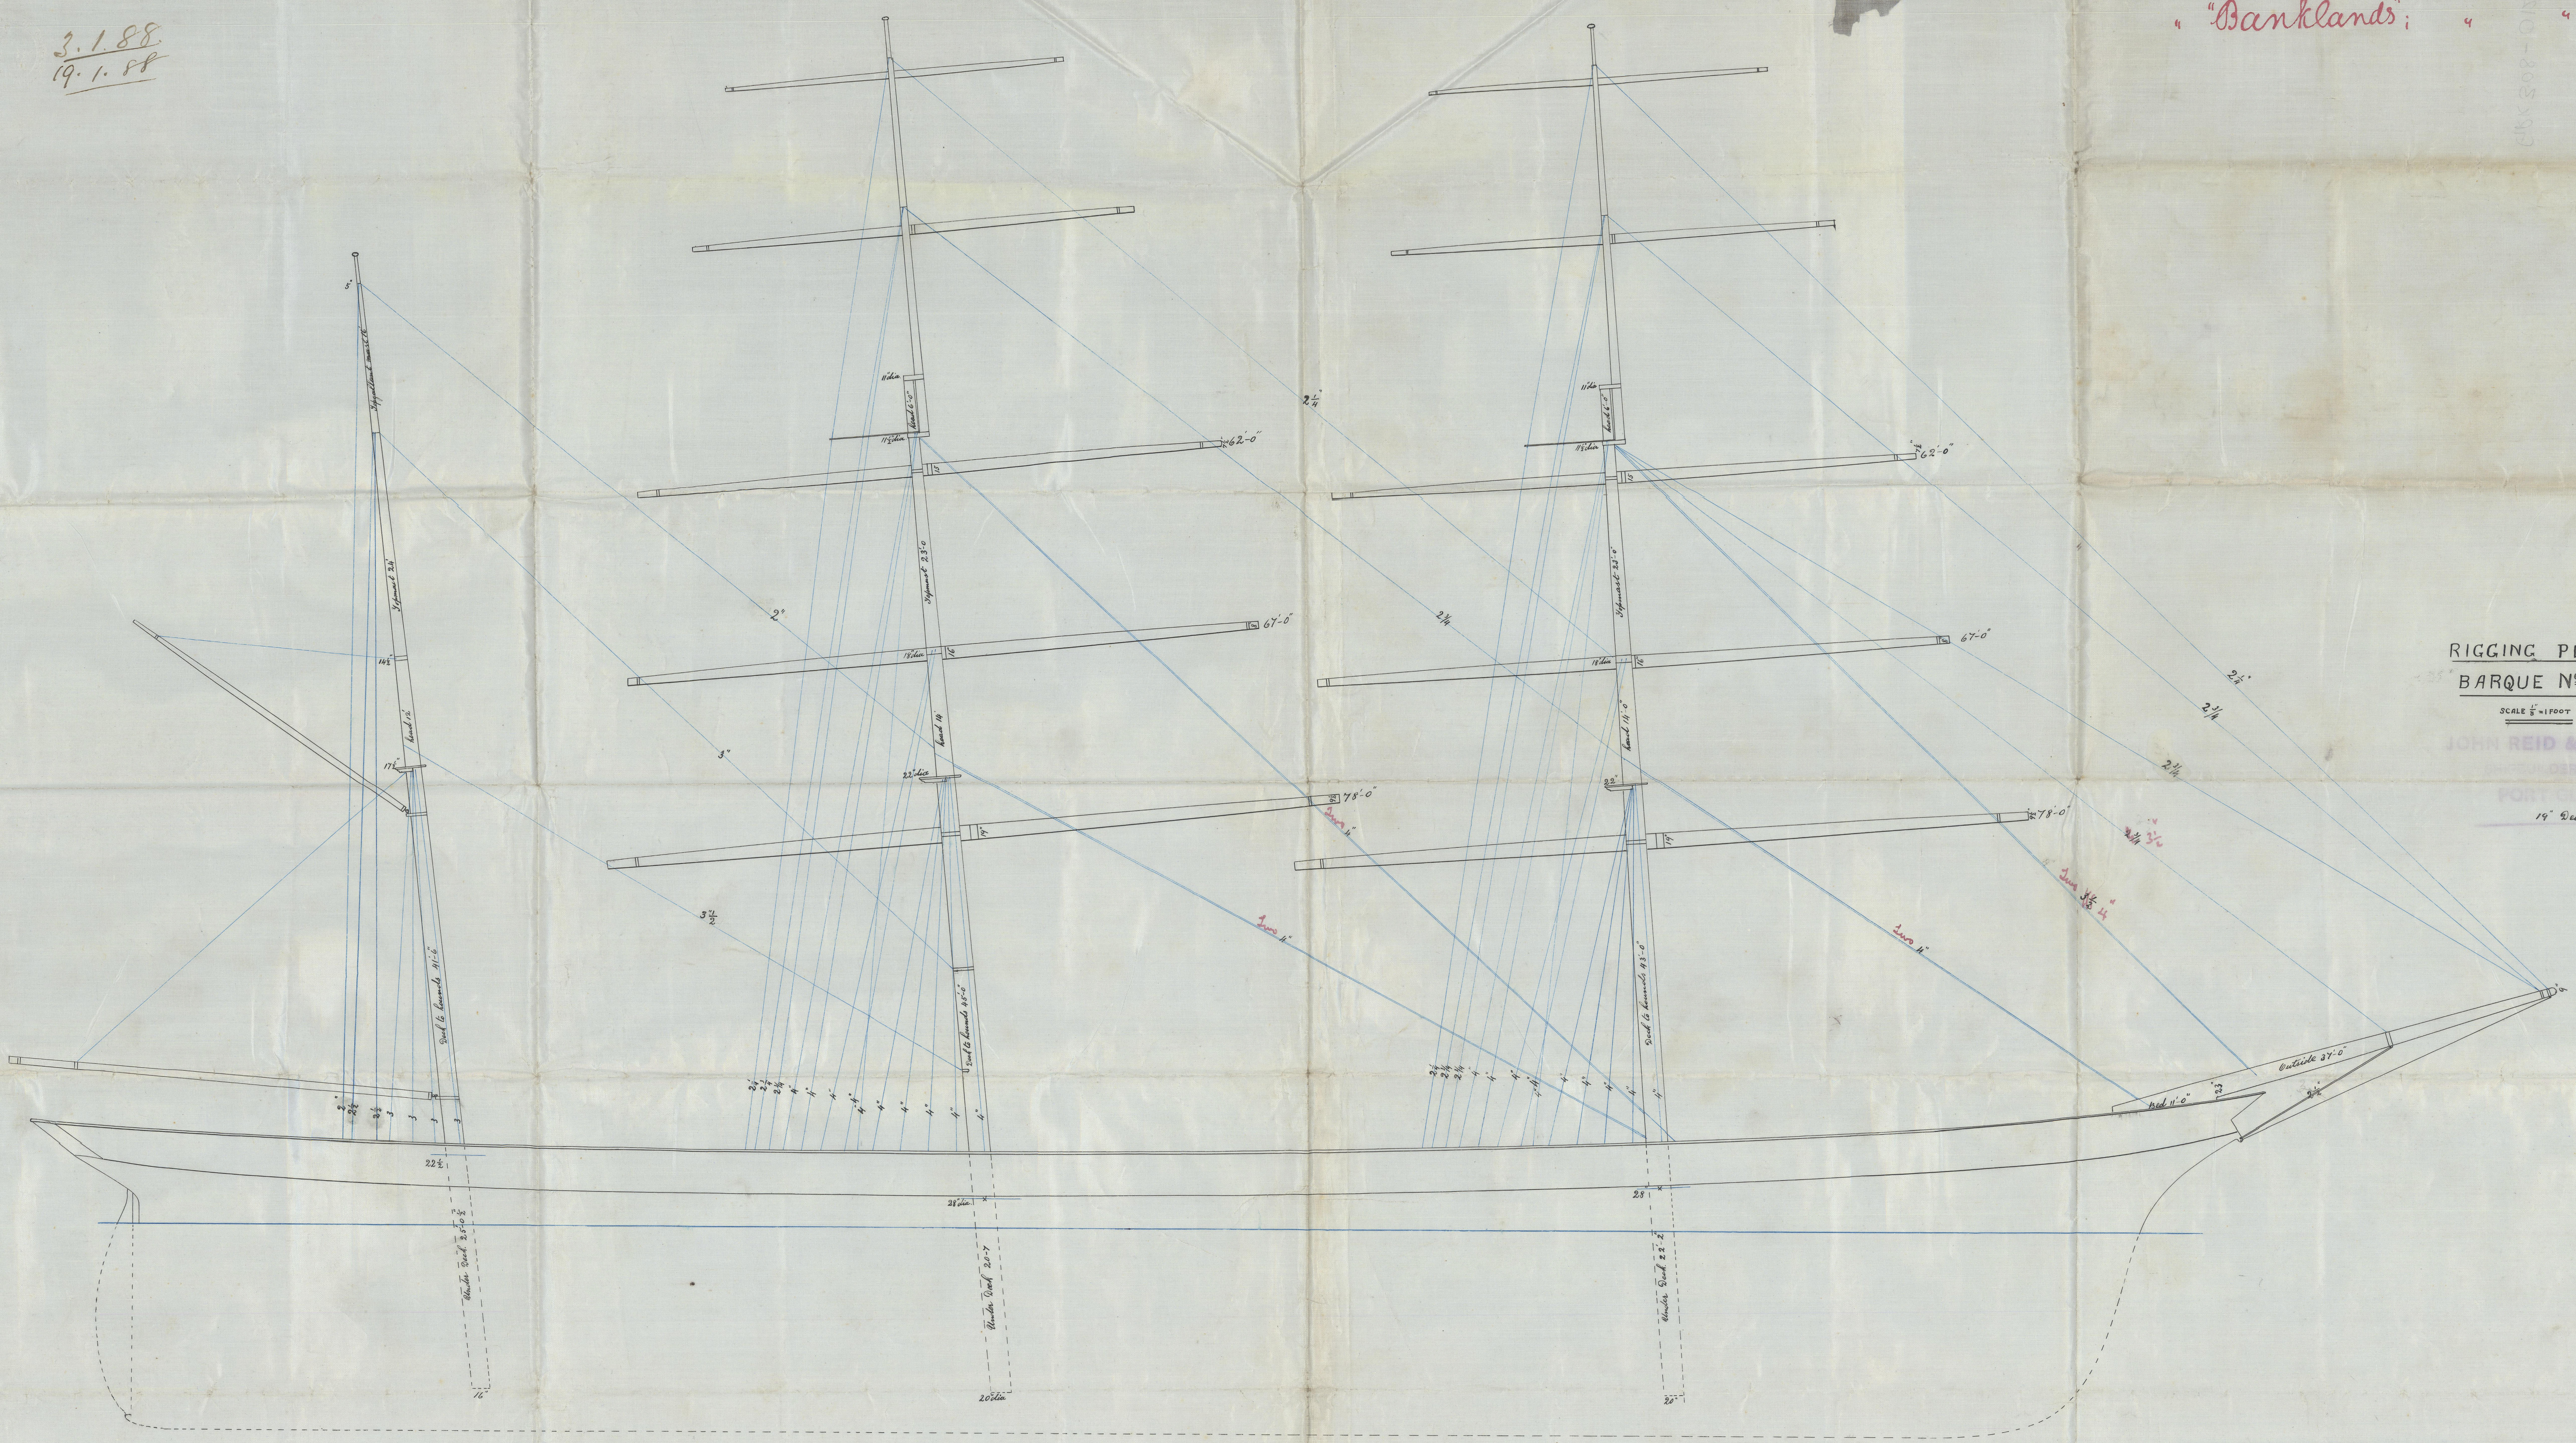


3.1.88  
19.1.88

6th. "Adderley"; Greenock Report No. 9486.  
"Banklands"; " " " 9513

GRK 308-0124

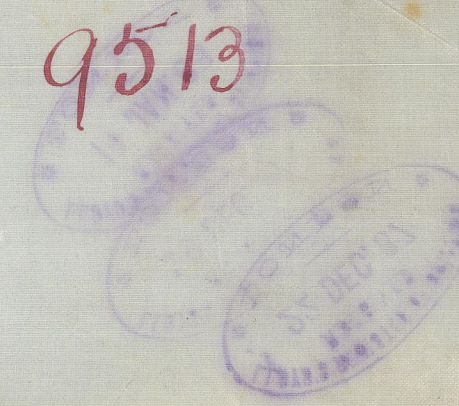

RIGGING PLAN  
BARQUE N°8/D 88/F  
SCALE 1/4" = 1 FOOT  
JOHN REID & CO  
GREENOCK  
PORT GLEN DOW  
19 Dec 1887



GRK 308-0129

0129  

© 2021

Lloyd's Register  
Foundation