

Lloyd's Register of British and Foreign Shipping.

(Report on Vessel No. 9513 Port Greenock)

Mr Ranklands

No. 1601

SHIP FORGINGS OR CASTINGS.

I have to report that the undermentioned Iron ~~or Steel~~ Forgings ~~or Castings~~, manufactured by The Lancefield Forge Co of Glasgow for the Vessel No. S/F, being built by Messrs John Reid & Co of Port Glasgow, have been inspected by me as set forth below, and found to be, so far as can be seen, sound and efficient.

Mark on Forgings.

Lloyd's
No. 1601
G. N

George Newcomb


Glasgow

24/1/88.

Post

	STERN FRAME.	RUDDER FRAME.	STEM & Keels.
Material*	<u>Scrap iron</u>	/	<u>Scrap iron</u>
How made	<u>Forged.</u>		<u>Forged.</u>
Dimensions	<u>8 1/2 x 2 1/2</u>		<u>Stem 8 1/2 x 2 1/2, Keel 9 x 2 1/2.</u>
Progress on Inspection	<u>Forging & smithing</u>		<u>Forging.</u>
Dates when Inspected	<u>19. 23. 27. 31/12/87.</u>		<u>14. 15. 19. 23/12/87.</u>

SKETCHES OF FRAMES SHEWING POSITION AND DESCRIPTION OF WELDS OF FORGINGS, OR PARTICULARS OF TESTS APPLIED TO CASTINGS.

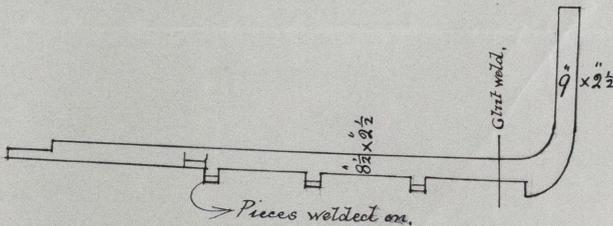

© 2019



Lloyd's Register
Foundation

CF