


19.12.87



s.s. "Virginia"; Greenock Report No. 9488  
s.s. "Aldbrough" — do — 9540

— Rigging Plan —  
— Screw Steamer —  
— 17<sup>03</sup> 1814-87 —  
— Scale 1/4 inch = one foot —

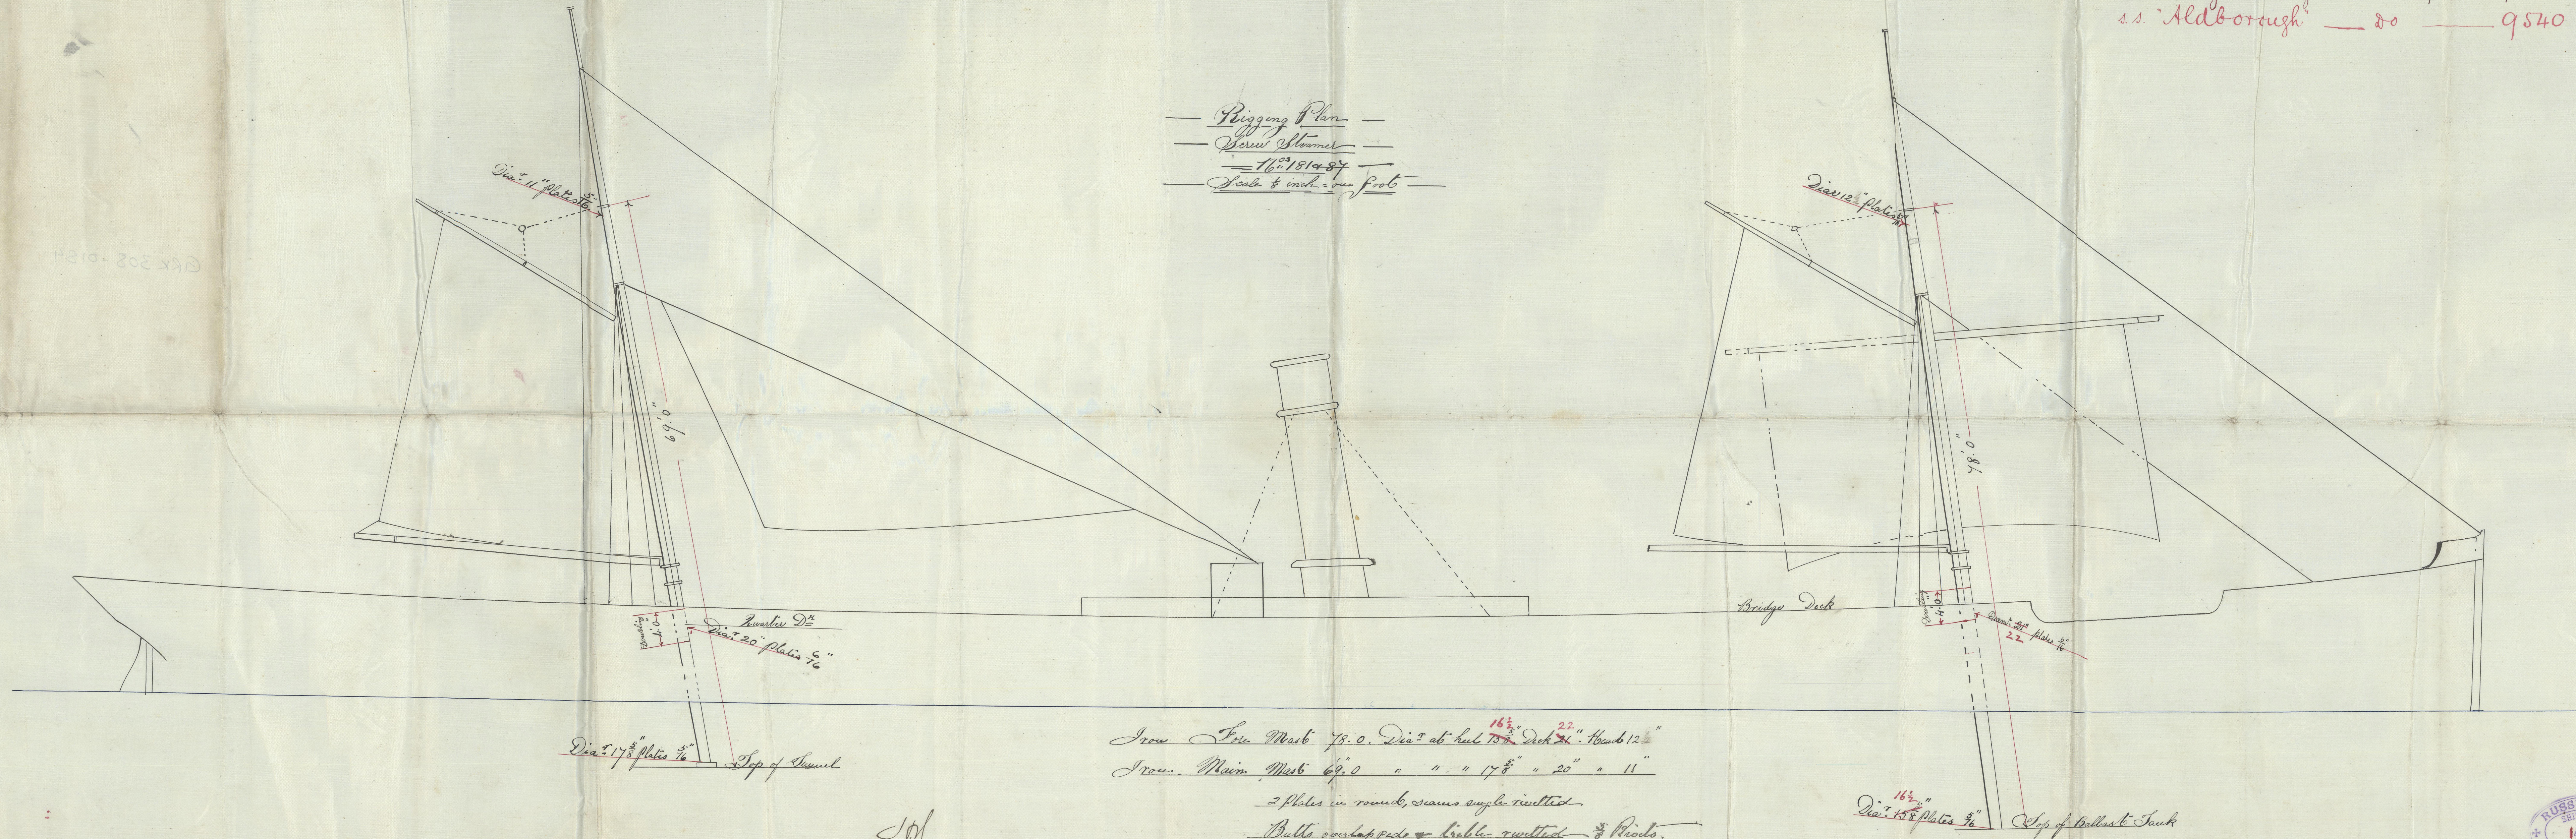

Iron Fore Mast 78.0. Dia. at hull <sup>16 1/2</sup> 15' 22" Deck 12' 11"  
Iron Main Mast 69.0 " " " 17 1/2 " 20 " 11"

2 plates in round, seams single riveted  
Butts overlapped & double riveted & fitted.  
Heels of masts to be efficiently strengthened


J.H.  
19/12/87






GRK308-0184

1 R/W  
C. J. 185

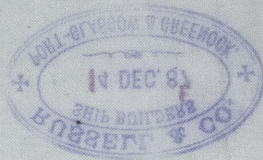

*Handwritten signature*

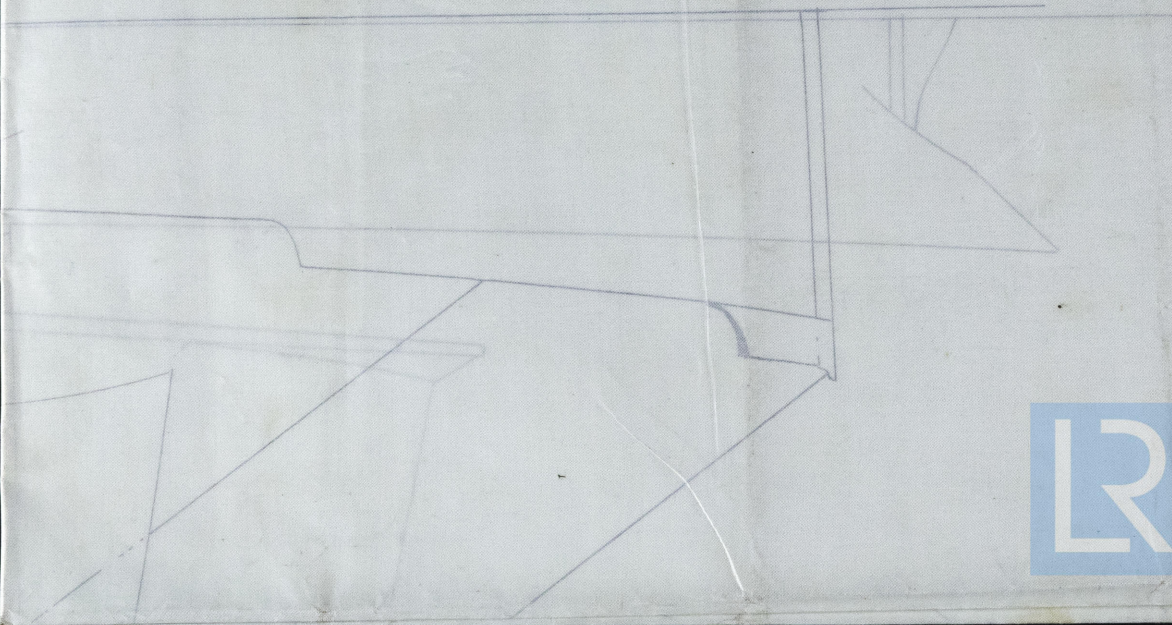

© 2021

Lloyd's Register  
Foundation

GRK308-0184