

Lloyd's Register of British and Foreign Shipping.

(Report on Vessel No. 9540 Port Greenock)

No. 1580

SHIP FORGINGS OR CASTINGS.

I have to report that the undermentioned Iron or ~~Steel~~ Forgings or Castings, manufactured by The Dennytown Forge Co. of Dumbarton, for the Vessel No. 184, being built by Messrs Russell & Co. of Port Glasgow, have been inspected by me as set forth below, and found to be, so far as can be seen, sound and efficient.

The records FORGINGS or CASTINGS, IRON or STEEL, should be struck out as may be required.

Mark on Forgings.

Lloyd's
No. 1580
G.N.


George Newcomb.

Glasgow.

16/5/88.

	STERN FRAME.	RUDDER FRAME.	STEM.
Material*	/	Scrap iron.	/
How made		Forged	
Dimensions		$4\frac{3}{4}$ & $3\frac{3}{4}$	
Progress on Inspection		Forging & smithing	
Dates when Inspected		13.21.29/3/88. 25/4/88. 1.11.12.16/5/88.	

SKETCHES OF FRAMES SHEWING POSITION AND DESCRIPTION OF WELDS OF FORGINGS, OR PARTICULARS OF TESTS APPLIED TO CASTINGS.

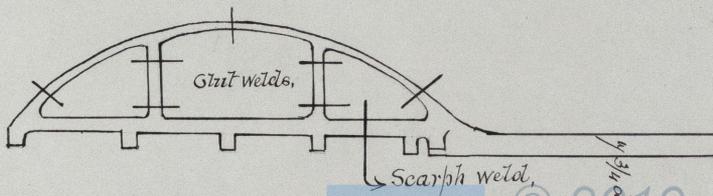

* If of Iron, state whether scrap or puddled Iron.

