


28.1.88.
6.2.88.

Proposed arrangement of Centre Bulkhead
showing joinings to stanchions
SS No 181

S.S. "Virginia"; Greenock Report No. 9488
S.S. "Aldborough"; — do — 9540

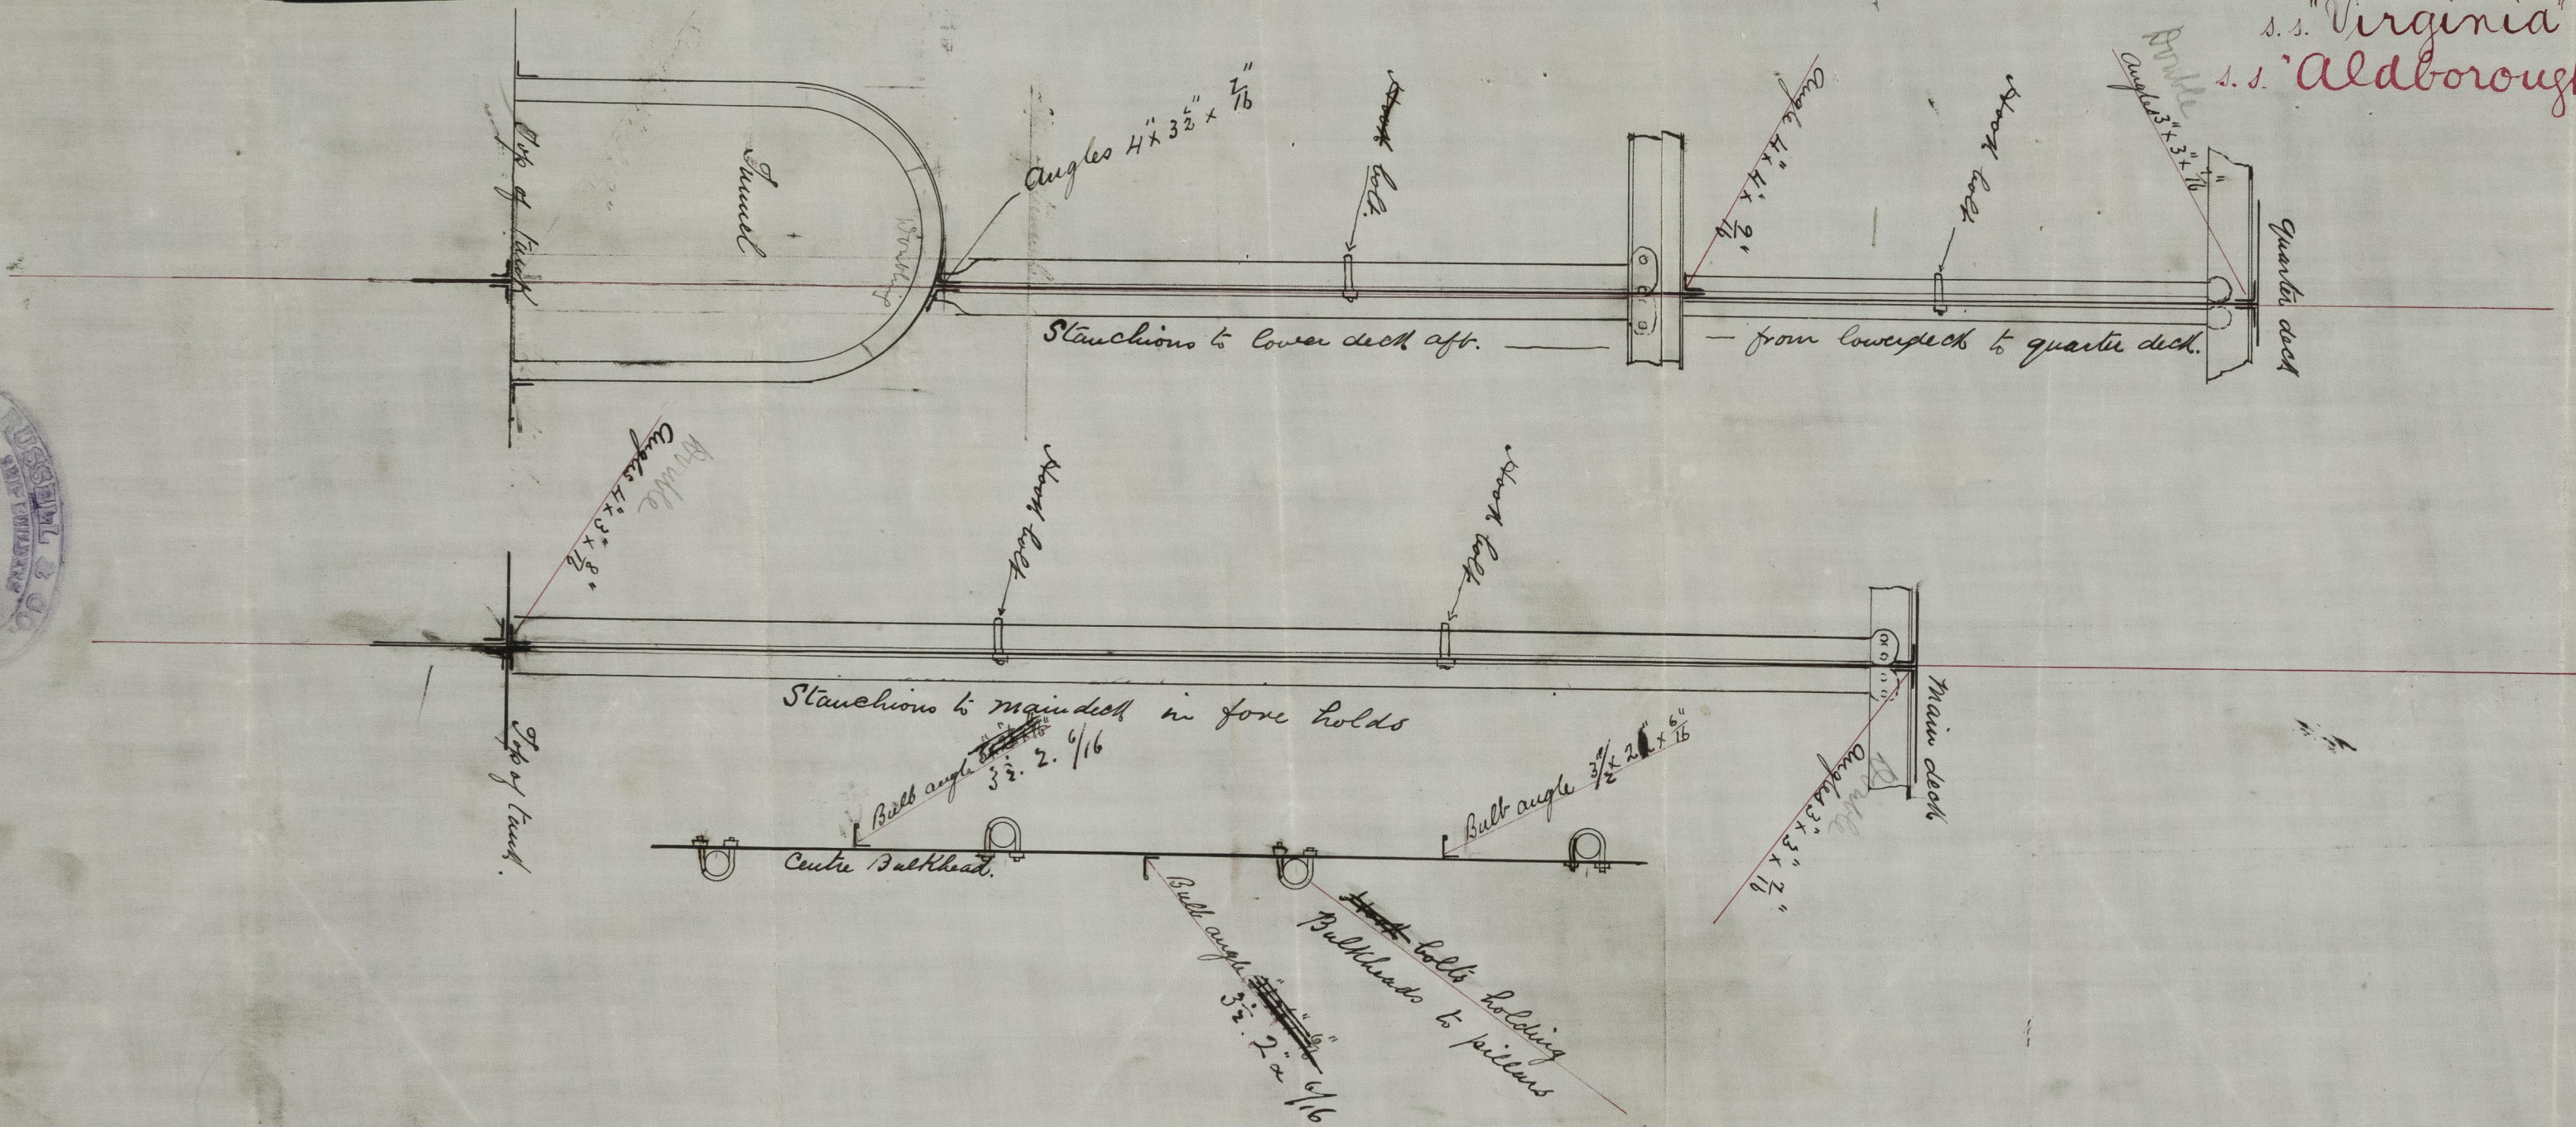

GIRK 308-0186

C.F. 181

28.5.25

GRK 308.-0186

© 2021

Lloyd's Register
Foundation

